



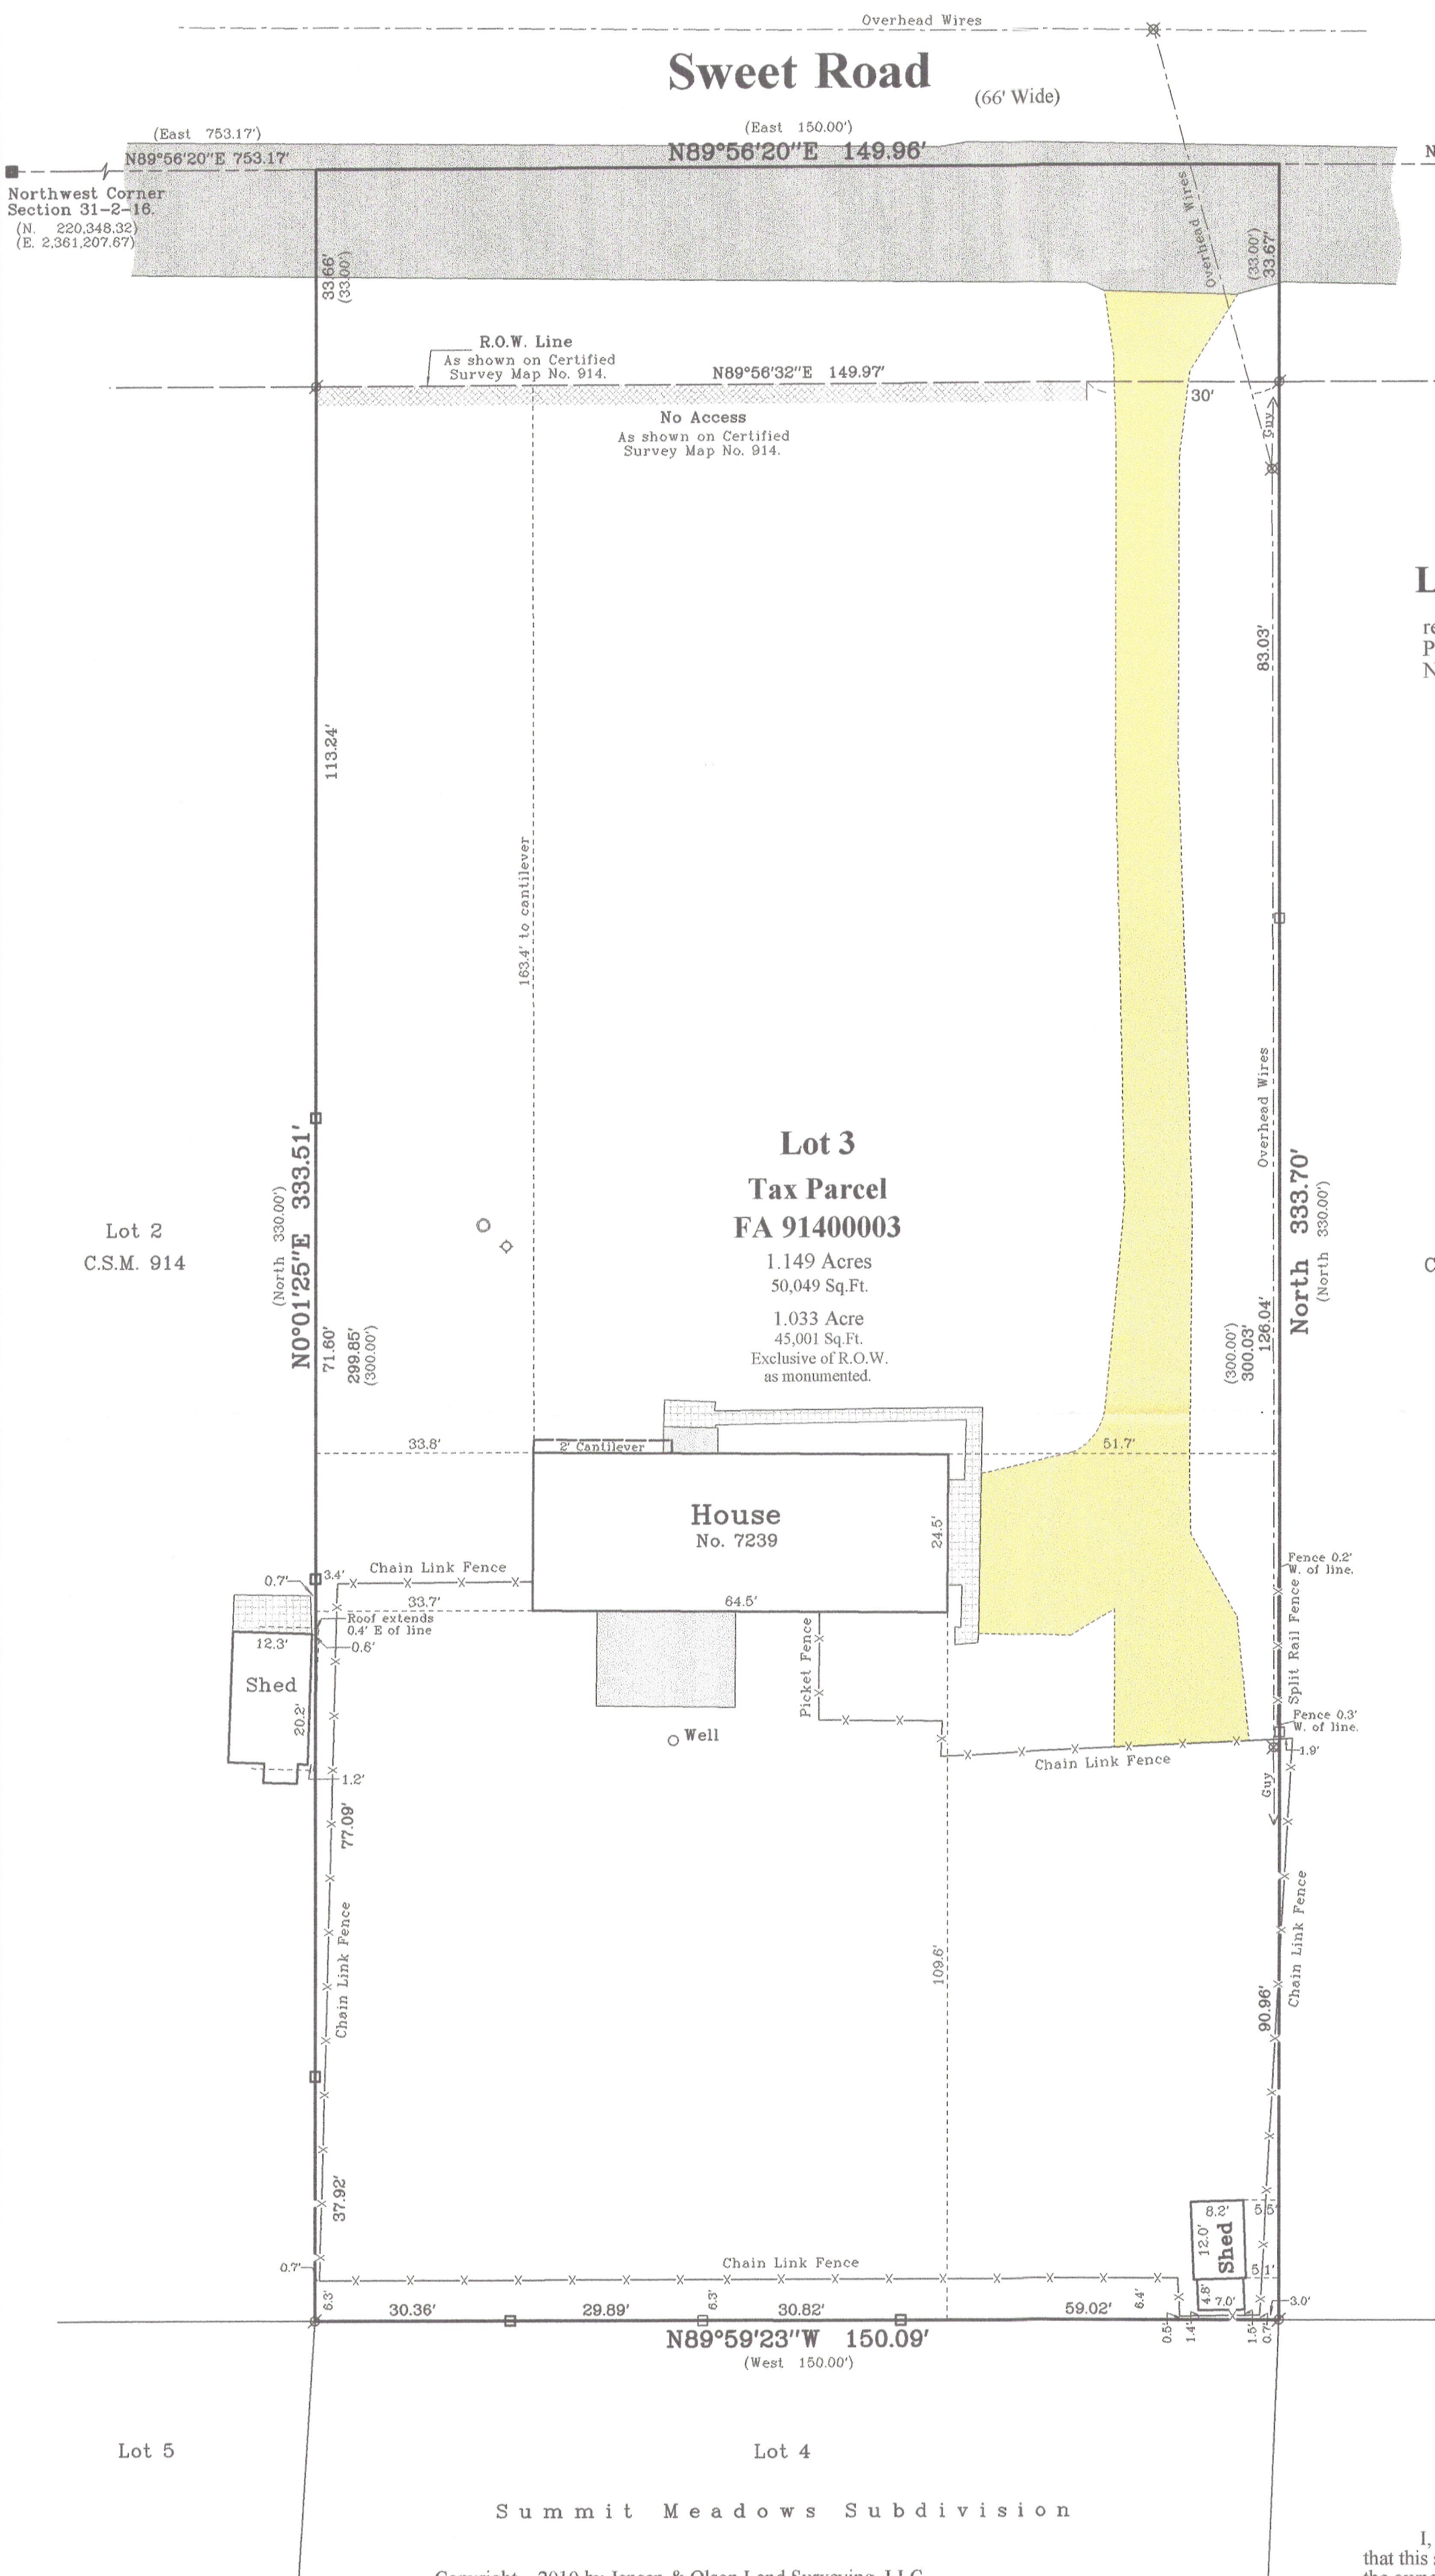

Plat of Survey

of
Lot 3 of Certified Survey Map No. 914,
recorded in Vol. 4 of Certified Survey Maps of Walworth County on
Page 146 and located in the Northwest 1/4 of Section 31, Town 2
North, Range 16 East, Town of Delavan, Walworth County, Wisconsin.

Surveyed for: **Dennis & Sadie Gunnink**
7239 Sweet Road
Delavan, Wisconsin. 53115

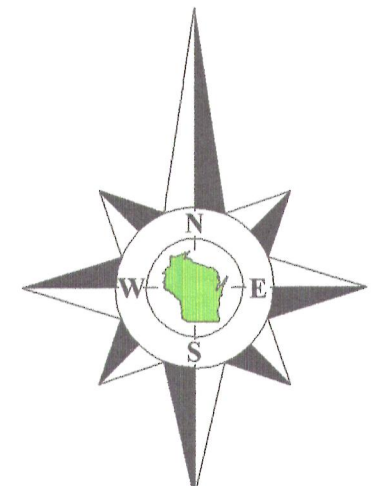

Bearings referenced to Certified
Survey Map No. 914.



Notes:

- 1) This survey plat is not certified unless signed and sealed in red ink.
- 2) This survey is subject to Wisconsin lien laws. This Plat of Survey is the notice of intent to file lien. Lien waiver required.



I, Douglas G. Olson, Wisconsin Registered Land Surveyor, do hereby certify that this survey was performed by me, or under my direction in full compliance with the owner's/agent's instructions and Chapter A-E 7 of the Wisconsin Administrative Code "Minimum Standards for Property Surveys"; and that this map is an accurate representation thereof to the best of my knowledge and belief.

Douglas G. Olson
Wisconsin Registered Land Surveyor - 2093

Copyright 2010 by Jensen & Olson Land Surveying, LLC.

All rights reserved. No part of this survey plat may be reproduced or transmitted in any form by any means - graphic, electronic, or mechanical, including photocopying, tracing, or information storage and retrieval systems - without permission in writing from Douglas G. Olson, Jensen & Olson Land Surveying, LLC.

2010.049	Sheet 1 of 1 Sheets	Legend Found County Section Corner Found Iron Pipe Set Wood Lath, June 2010 Recorded Information Utility Pole Concrete Cover PVC Pipe Asphalt Surface Concrete Surface Gravel Pavers	Jensen & Olson Land Surveying, LLC 45 South Wisconsin Street * P.O. Box 322 * Elkhorn, Wisconsin. 53121 Telephone: (262) 723-3434 * Facsimile: (262) 723-8044 Email: jensen.olson@elknet.net	Scale in Feet 1" = 20' 	Survey Date: June 10, 2010. Revisions: No. 1 - Update
	Job Reference Number				
	2010.049				
	HA914-3				