


HAROLD H. KOLB

REGISTERED PROFESSIONAL LAND SURVEYOR
LAKE GENEVA, WISCONSIN

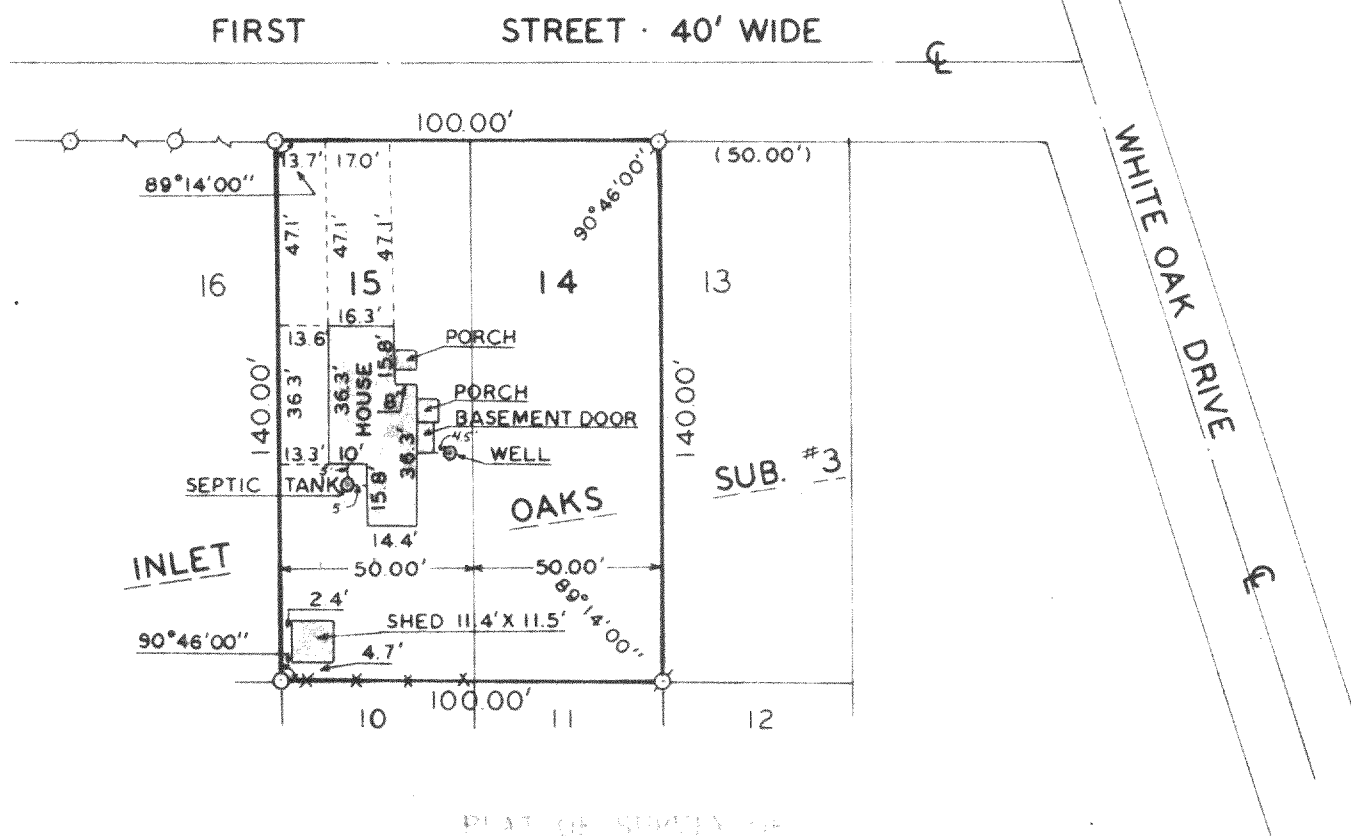

PLAT OF SURVEY OF
lots 14 and 15, Block 1, Inlet Oaks Sub-
division #2, Walworth County, Wisconsin.

OWNER: Richard Rogers


ACCURACY: $\pm 0.01'$
Angle $\pm 13''$
Error of closure
less than 1/3000

N
SCALE - 1" = 50'

LEGEND

- φ — IRON PIPE FOUND
- — IRON PIPE PLACED
- — CONCRETE MONUMENT
- x — SPIKE

*** — CORNER

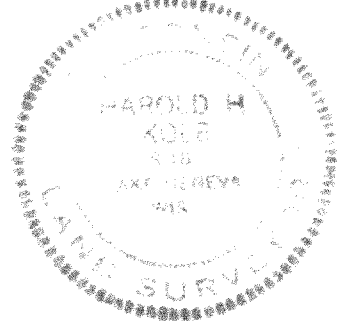

I, HAROLD H. KOLB, DO HEREBY CERTIFY THAT I HAVE
SURVEYED THE PROPERTY HEREON DESCRIBED ACCORDING
TO THE OFFICIAL RECORDS, AND THAT THE PLAT HEREON
IS A CORRECT REPRESENTATION OF THE LOT LINES, AND THE
ACCURACY OF THE SURVEY.

Harold H. Kolb
HAROLD H. KOLB
WISCONSIN REGISTERED LAND SURVEYOR, S-187
DATE Jan. 23, 1975

FIN3-11

216-498