

PLAT OF SURVEY

LOT 2 OF CERTIFIED SURVEY MAP NO. 1337
LOCATED IN THE NORTHWEST 1/4 & SOUTHWEST 1/4 SECTION 27
TOWN 2 NORTH, RANGE 16 EAST
WALWORTH COUNTY, WISCONSIN

Lot 2 of Certified Survey Map No. 1337 recorded in the Office of the Register of Deeds for Walworth County, Wisconsin, on January 20, 1984, in Volume 6 of Certified Survey Maps, on Pages 161 and 162, as Document No. 98819, being located in the Northwest 1/4 and the Southwest 1/4 of Section 27, T2N, R16E, Town of Delavan, County of Walworth, State of Wisconsin.

Parcel No.:
FA133700002

NOTE: COPIES OF THIS MAP TO WHICH THE FOLLOWING CERTIFICATE WILL APPLY SHOW THE SURVEYOR'S ORIGINAL SEAL AND SIGNATURE IN RED INK. COPIES BY ANY OTHER MEANS MAY HAVE ALTERATIONS WHICH DO NOT REPRESENT THE SURVEYOR'S WORK PRODUCT.

I HEREBY CERTIFY THAT THE ABOVE DESCRIBED PROPERTY HAS BEEN SURVEYED UNDER MY DIRECTION AND THAT THE ABOVE MAP IS A TRUE REPRESENTATION THEREOF AND SHOWS THE SIZE AND LOCATION OF THE PROPERTY, ITS EXTERIOR BOUNDARIES, THE LOCATION OF ALL VISIBLE STRUCTURES, AND DIMENSIONS OF ALL PRINCIPLE BUILDINGS THEREON, BOUNDARY FENCES, APPARENT EASEMENTS, ROADWAYS, AND VISIBLE ENCROACHMENTS, IF ANY. THIS SURVEY IS MADE FOR THE USE OF THE PRESENT OWNERS OF THE PROPERTY, AND ALSO THOSE WHO PURCHASE, MORTGAGE, OR GUARANTEE THE TITLE THERETO WITHIN ONE YEAR FROM THE DATE HEREOF.

DATED: SEPTEMBER 18, 2012

PETER S. GORDON





WORK ORDERED BY:
CLAIR LAW OFFICE
PO BOX 445
DELAVER, WI. 53115

FARRIS, HANSEN & ASSOCIATES, INC.
ENGINEERING - ARCHITECTURE - SURVEYING
7 RIDGWAY COURT P.O. BOX 437
ELKHORN, WISCONSIN 53121
OFFICE: (262) 723-2098 FAX: (262) 723-5886

FENCE POST
0.47' NORTH OF
CORNER


(28.30')
28.20'

PROJECT NO.
8656
DATE:
09-12-2012
SHEET NO.
1 OF 1

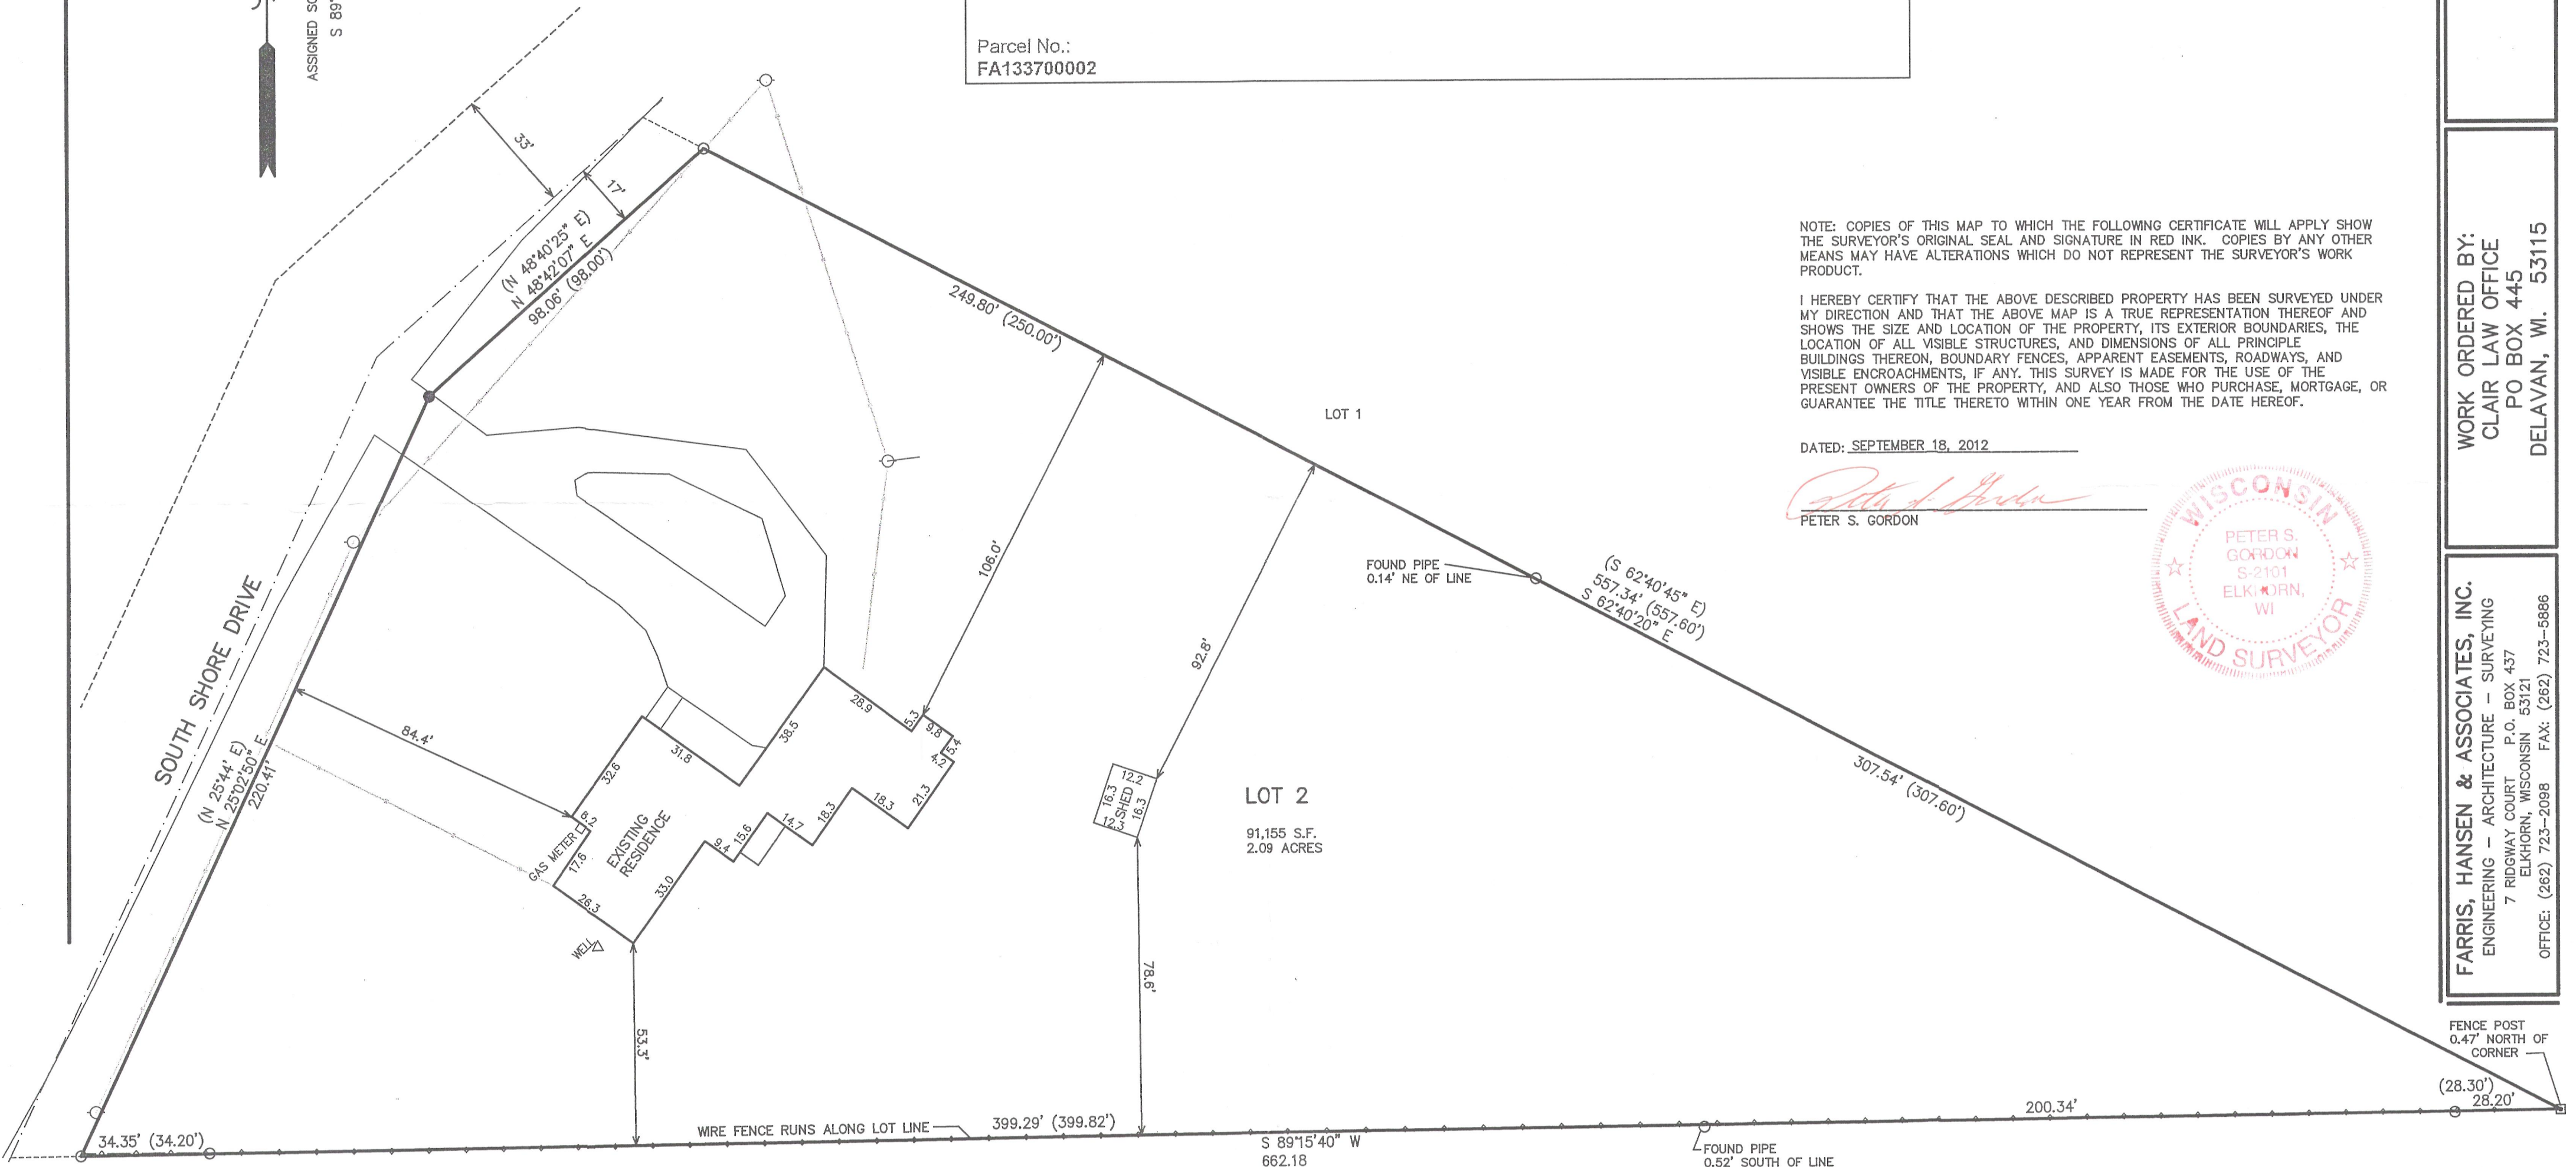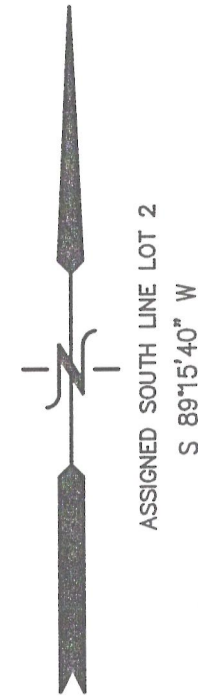

- LEGEND
- = FOUND IRON PIPE STAKE
 - = SET IRON REBAR STAKE
 - = FOUND CONCRETE MONUMENT
 - (XXX) = RECORDED AS

MAP SCALE IN FEET ORIGINAL 1" = 30'

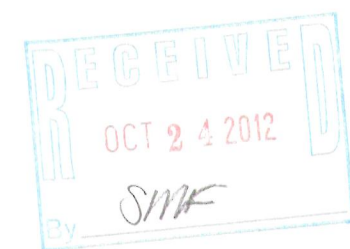

FA1337-2

216-4987

SEP 18 2012

9/18/2012 X:\Projects\B656\dcad\survey