



PREPARED FOR
BARRY CRONIN
&
TUREK CONSTRUCTION

PLAT OF SURVEY

- OF -

PATHFINDER SURVEYING INC.
(formerly)
J.K. SURVEYING INC.
P.O BOX 322
LAKE GENEVA, WI. 53147
WWW.PATHFINDERSURVEYING.NET
262-248-8303

THE EASTERLY 10 FEET OF LOT 33, LOT 34 AND LOT 35, BLOCK 15 DELAVAN LAKE VIEW CREST, A SUBDIVISION LOCATED IN SECTION 31 TOWN 2 NORTH, RANGE 16 EAST OF THE FOURTH PRINCIPLE MERIDIAN, TOWN OF DELAVAN, WALWORTH COUNTY, WISCONSIN

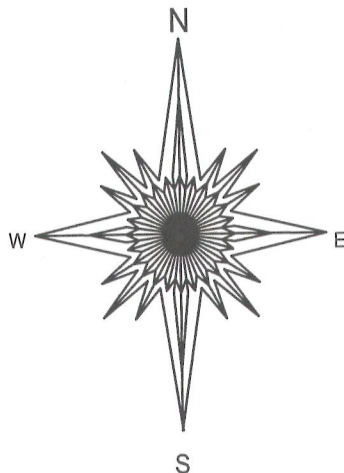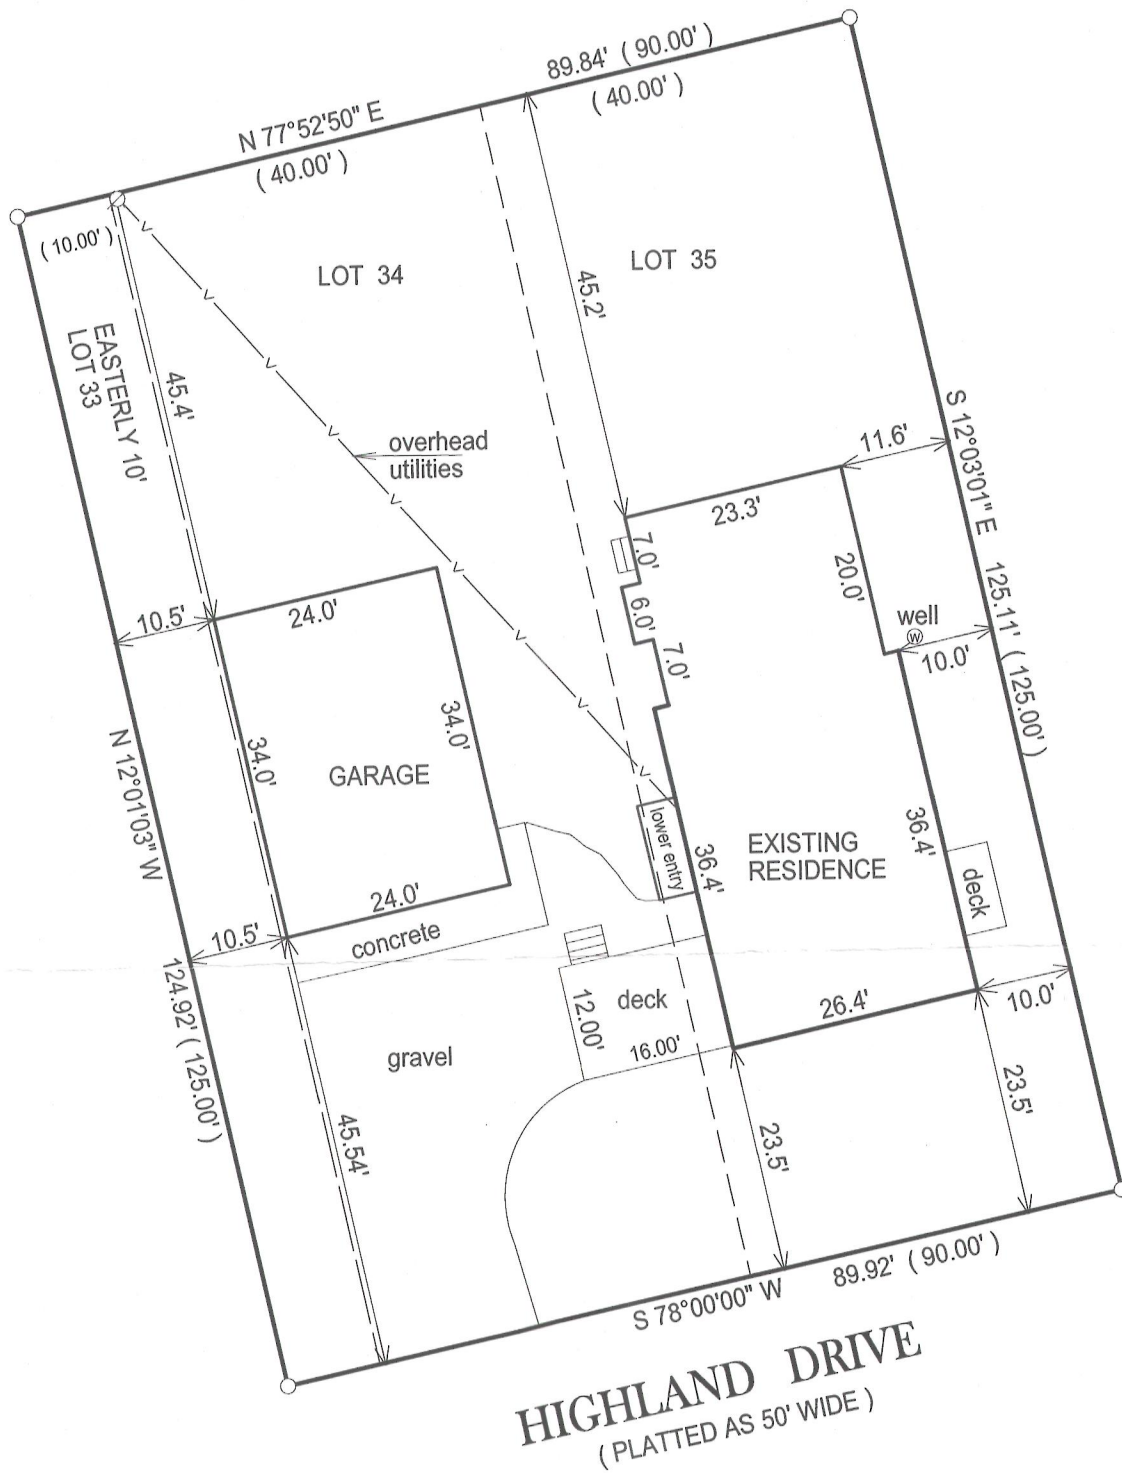

REVISED 10/10/2012 FINAL SURVEY

- () = recorded as
- = found iron bar
- = found iron pipe
- = set iron pipe
- = set iron bar

SCALE 1" = 20'

JOB # 10-81final


TAX ID #
FDLV-00081

BASIS OF BEARING OF THIS PLAT: THE NORTH LINE OF HIGHLAND DRIVE WAS ASSUMED TO BEAR S 78°W.

"I hereby certify that I have surveyed the above described property and that the above map is a true representation of its exterior boundary and shows the size and location of all visible structures, apparent easements and encroachments if any."

This survey is made for the present owners of the property, and those who purchase, mortgage, or guarantee the title thereto, within one year from the date hereof.

REVISED 9/17/2010, ASBUILT FOUNDATIONS
DATED THIS 15TH DAY OF JUNE, 2010.

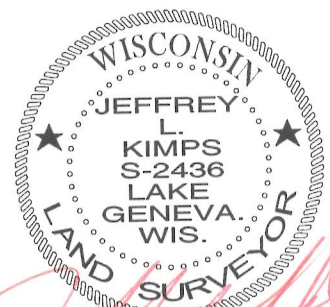

JEFFREY L. KIMPS S - 2436
Wisconsin Registered Land Surveyor
(original if signed in red)

FDLV-86

216-4990