


PLAT OF SURVEY  
LOTS 23 & 24 OF BLOCK 15  
DELANVAN LAKE VIEW CREST SUBDIVISION  
LOCATED IN THE SE 1/4 OF THE NW 1/4 SEC. 31  
TOWN 2 NORTH, RANGE 16 EAST  
WALWORTH COUNTY, WI.

ORDERED BY: LISA DALTON  
5618 FARMBROOK LANE  
CRYSTAL LAKE, IL. 60014

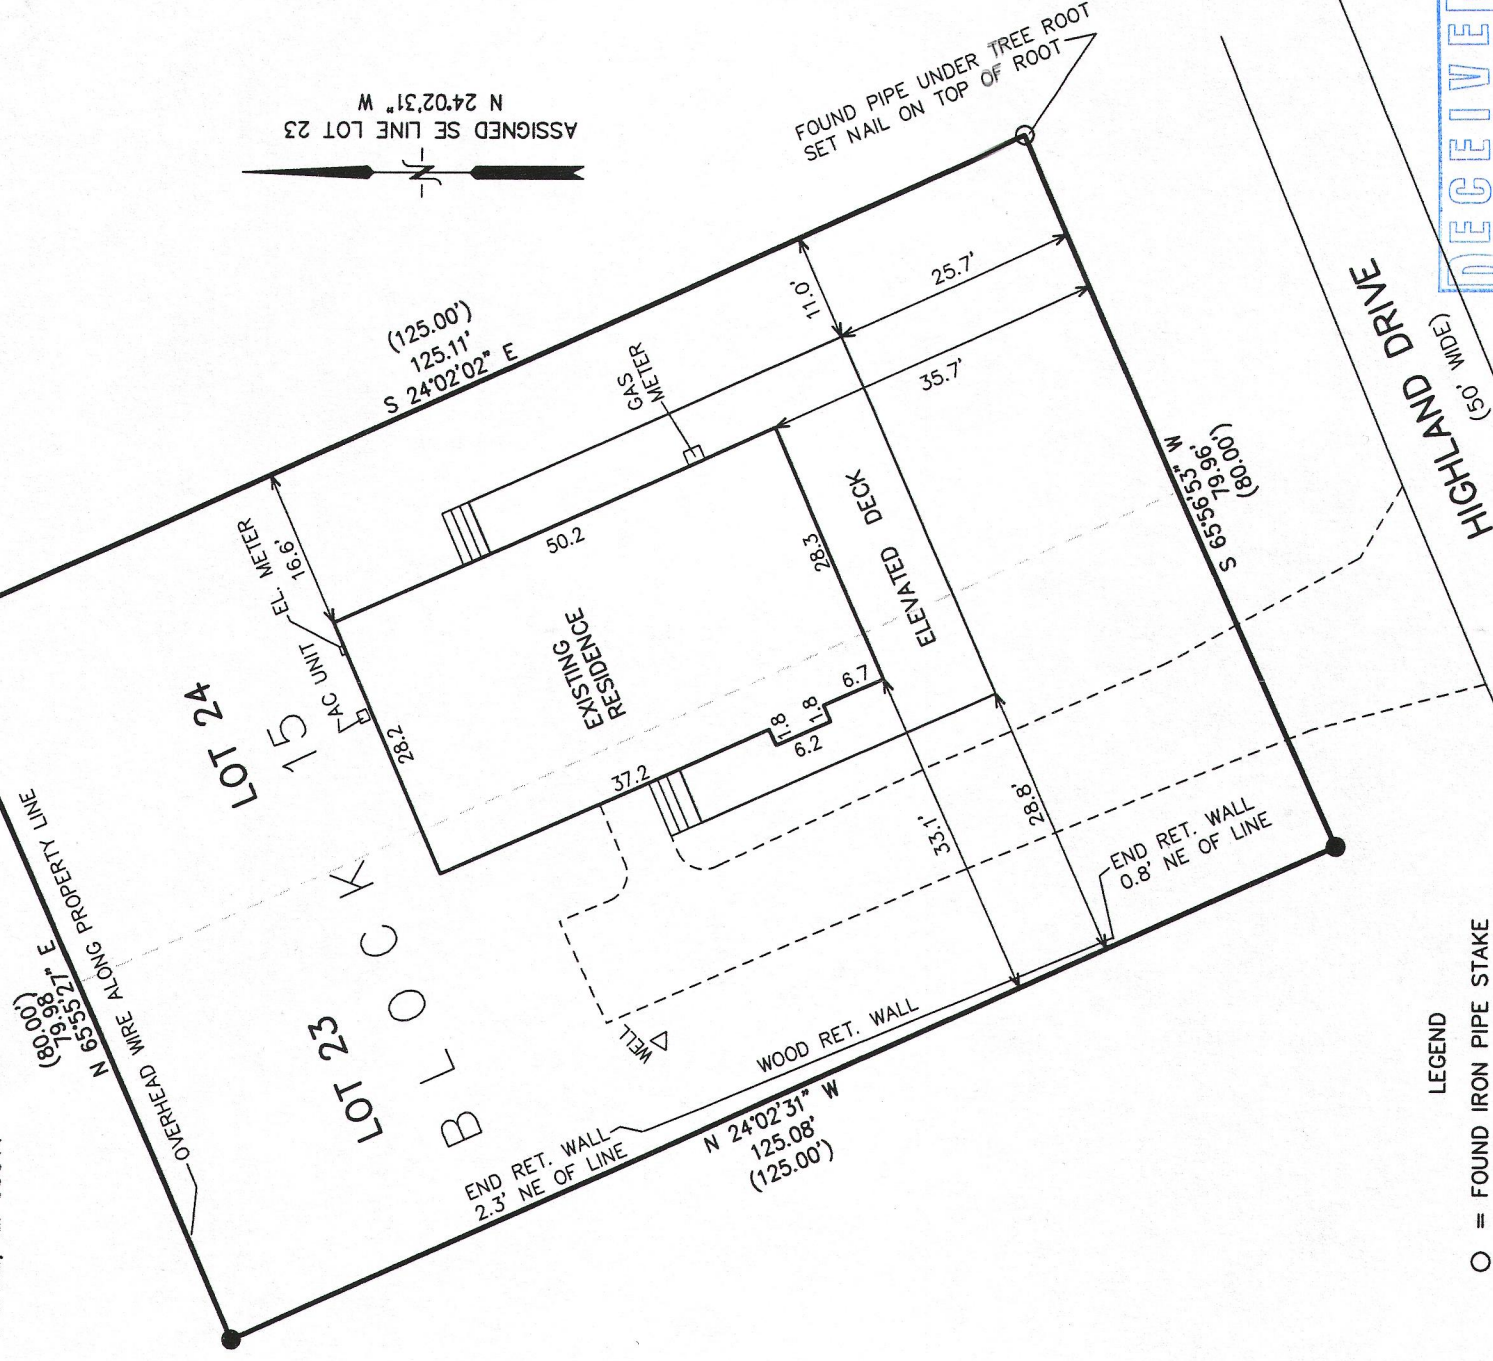

## LEGEND

- = FOUND IRON PIPE STAKE  
● = FOUND IRON REBAR STAKE  
(xxx) = RECORDED AS

AREA SURVEYED = 10,005 S.F. (0.23 AC.)

NOTE: COPIES OF THIS MAP TO WHICH THE FOLLOWING CERTIFICATE WILL APPLY SHOW THE SURVEYOR'S ORIGINAL SEAL AND SIGNATURE IN RED INK. COPIES BY ANY OTHER MEANS MAY HAVE ALTERATIONS WHICH DO NOT REPRESENT THE SURVEYOR'S WORK PRODUCT.

I HEREBY CERTIFY THAT THE ABOVE DESCRIBED PROPERTY HAS BEEN SURVEYED UNDER MY DIRECTION AND THAT THE ABOVE MAP IS A TRUE REPRESENTATION THEREOF AND SHOWS THE SIZE AND LOCATION OF THE PROPERTY AND ITS EXTERIOR BOUNDARIES. THIS SURVEY IS MADE FOR THE USE OF THE PRESENT OWNERS OF THE PROPERTY, AND ALSO THOSE WHO PURCHASE, MORTGAGE, OR GUARANTEE THE TITLE THERETO WITHIN ONE YEAR FROM THE DATE HEREOF.

DATED: MAY 7, 2013

PETER S. GORDON

PROJECT NO. 8784

DATED: 05-07-2013

SHEET 1 OF 1 SHEETS

2013 JUN 6

FdLV - 80 216-5626