



PREPARED FOR:
GEROGE DORL
2809 KING ST.
DELAVAN, WI.53115

PLAT OF SURVEY

- OF -

PATHFINDER SURVEYING INC.
(formerly)
J.K. SURVEYING INC.
P.O BOX 322
LAKE GENEVA, WI. 53147
WWW.PATHFINDERSURVEYING.NET
262-248-8303

LOT 18 OF BLOCK 14, DELMAR SUBDIVISION: A SUBDIVISION
OF PART OF GOVERNMENT LOT 3, PART OF THE SOUTHWEST 1/4
OF THE SOUTHWEST 1/4, ALL OF THE SOUTHEAST 1/4 OF THE SOUTHWEST
1/4, AND PART OF THE NORTHEAST 1/4 OF THE SOUTHWEST 1/4 OF SECTION
27, TOWNSHIP 2 NORTH, RANGE 16 EAST OF THE 4TH PRINCIPLE MERIDIAN,
WALWORTH COUNTY, WISCONSIN

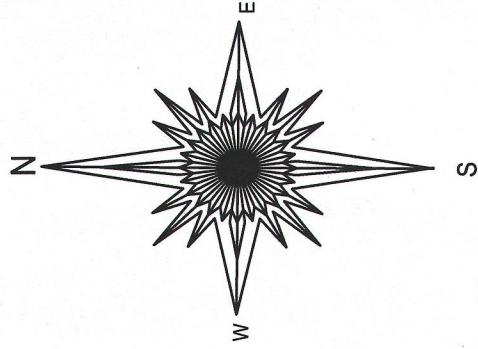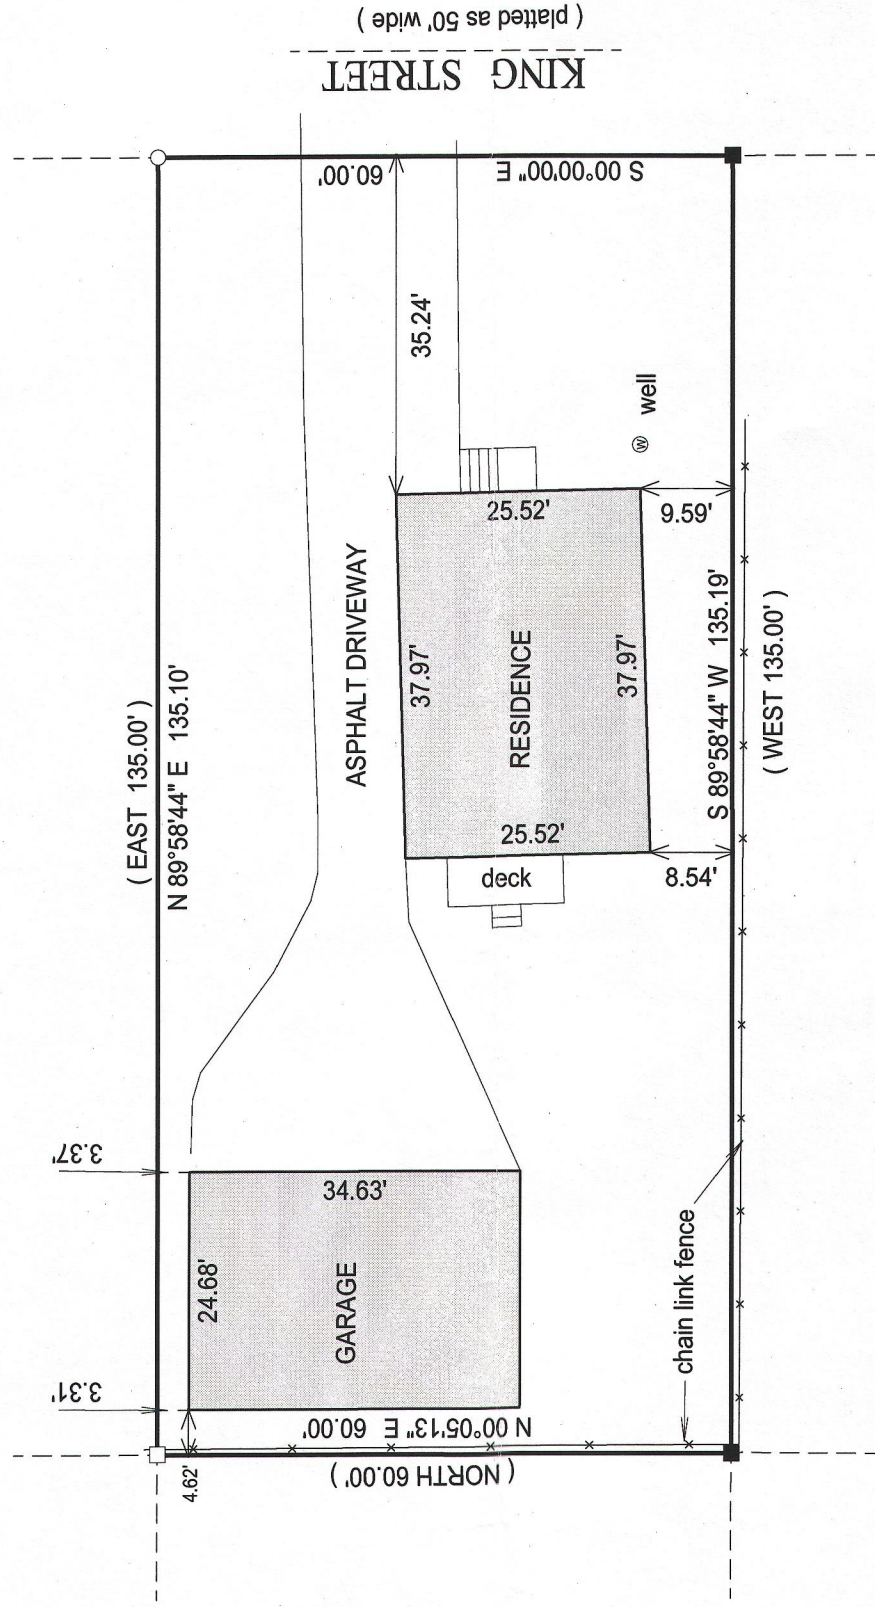

BASIS OF BEARING OF THIS PLAT: THE WEST LINE OF KING STREET
WAS ASSUMED TO BEAR SOUTH AS SHOWN ON THE RECORD PLAT
OF DELMAR.

I hereby certify that I have surveyed the above- described property and the
above map is a true representation thereof and shows the size and
location of the property, its exterior boundaries, the location and
dimensions of all structures thereon, fences, apparent easements and
roadways and visible encroachments if any.

SCALE 1" = 20'

JOB # 13-69

TAX ID #

FDM 00062

This survey is made for the present owners of the property, and those who
purchase, mortgage, or guarantee the title thereto, within one year from
the date hereof.

DATED THIS 29TH DAY OF MAY, 2013.



JEFFREY L KIMPS S - 2436
Wisconsin Registered Land Surveyor
(original if signed in red)

216-5035