

Plat of Survey

of


Lots 102 and 103 of Krumhaar's 2nd Addition to Ravenswood,

a subdivision located in the Southeast 1/4 of Section 31, Town 2 North Range 16 East, Town of Delavan, Walworth County, Wisconsin.

Surveyed for: **Andy Nelson**
4222 Maple Drive
Delavan, Wisconsin. 53115



Bearings reference to previous surveys of record.

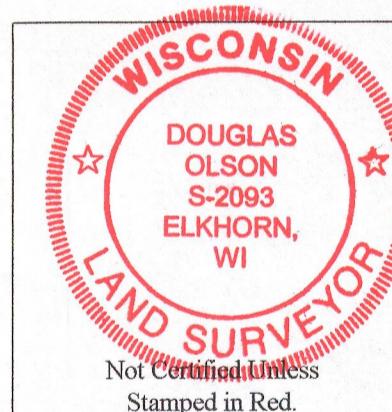

Notes:


- 1) This survey plat is not certified unless signed and sealed in red ink.
- 2) This survey is subject to Wisconsin lien laws. This Plat of Survey is the notice of intent to file lien. Lien waiver required.

Copyright 2013 by Jensen & Olson Land Surveying, LLC

All rights reserved. No part of this survey plat may be reproduced or transmitted in any form by any means - graphic, electronic, or mechanical, including photocopying, tracing, or information storage and retrieval systems - without permission in writing from Douglas G. Olson, Jensen & Olson Land Surveying, LLC.

I, Douglas G. Olson, Wisconsin Registered Land Surveyor, do hereby certify that this survey was performed by me, or under my direction in full compliance with the owner's/agent's instructions and Chapter A-E 7 of the Wisconsin Administrative Code "Minimum Standards for Property Surveys", and that this map is an accurate representation thereof to the best of my knowledge and belief.

Douglas G. Olson
Wisconsin Registered Land Surveyor - 209

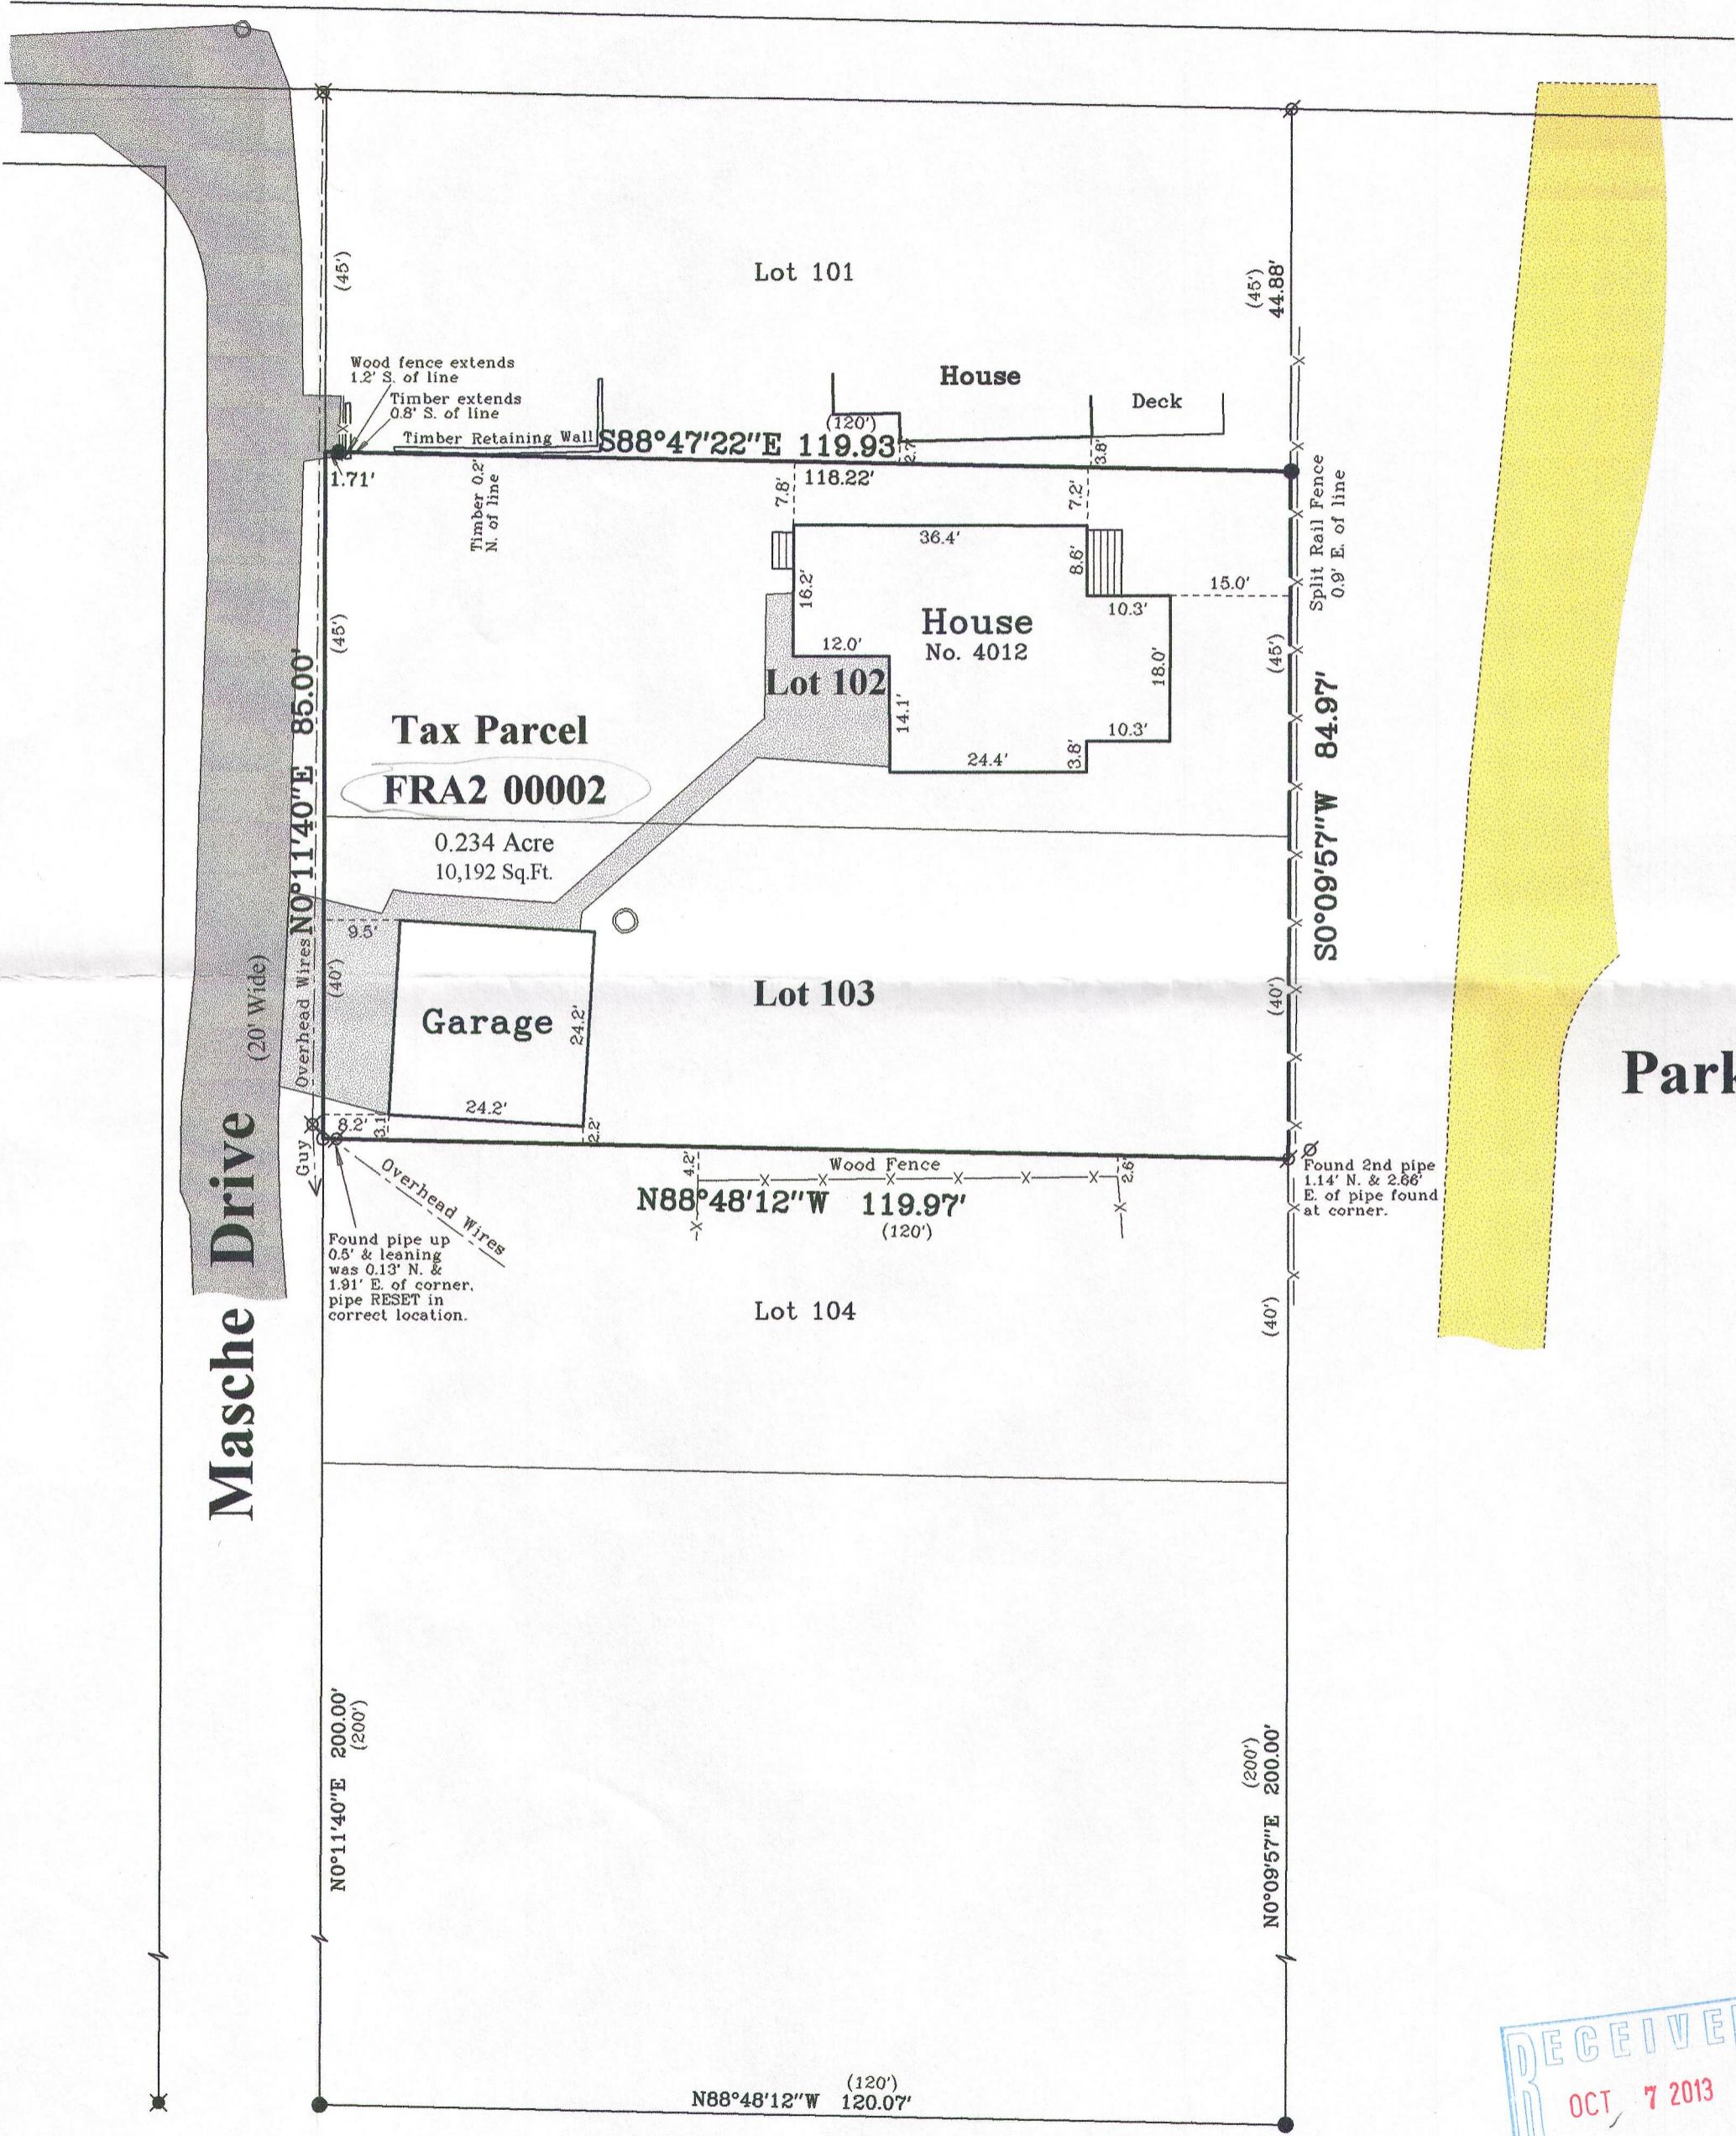

RECEIVED
OCT, 7 2013
JL

Jensen & Olson Land Surveying, LLC	
Survey Date: April 15, 2013.	Revisions:
Legend	
Ø Found Iron Pipe	■ Found Iron Rod
● Found Iron Rod	☒ Found Mag. Nail
☒ Found Mag. Nail	○ Set Iron Pipe, 1" dia.
○ Set Iron Pipe, 1" dia.	() Recorded Information
() Recorded Information	☒ Utility Pole ○ Concrete Cover
☒ Utility Pole ○ Concrete Cover	☒ Asphalt Surface
Sheet 1 of 1 Sheets	
Drawing Name: t2mr16e-2013032-2013032P1at.sqj	Job Reference Number
	2013.032