


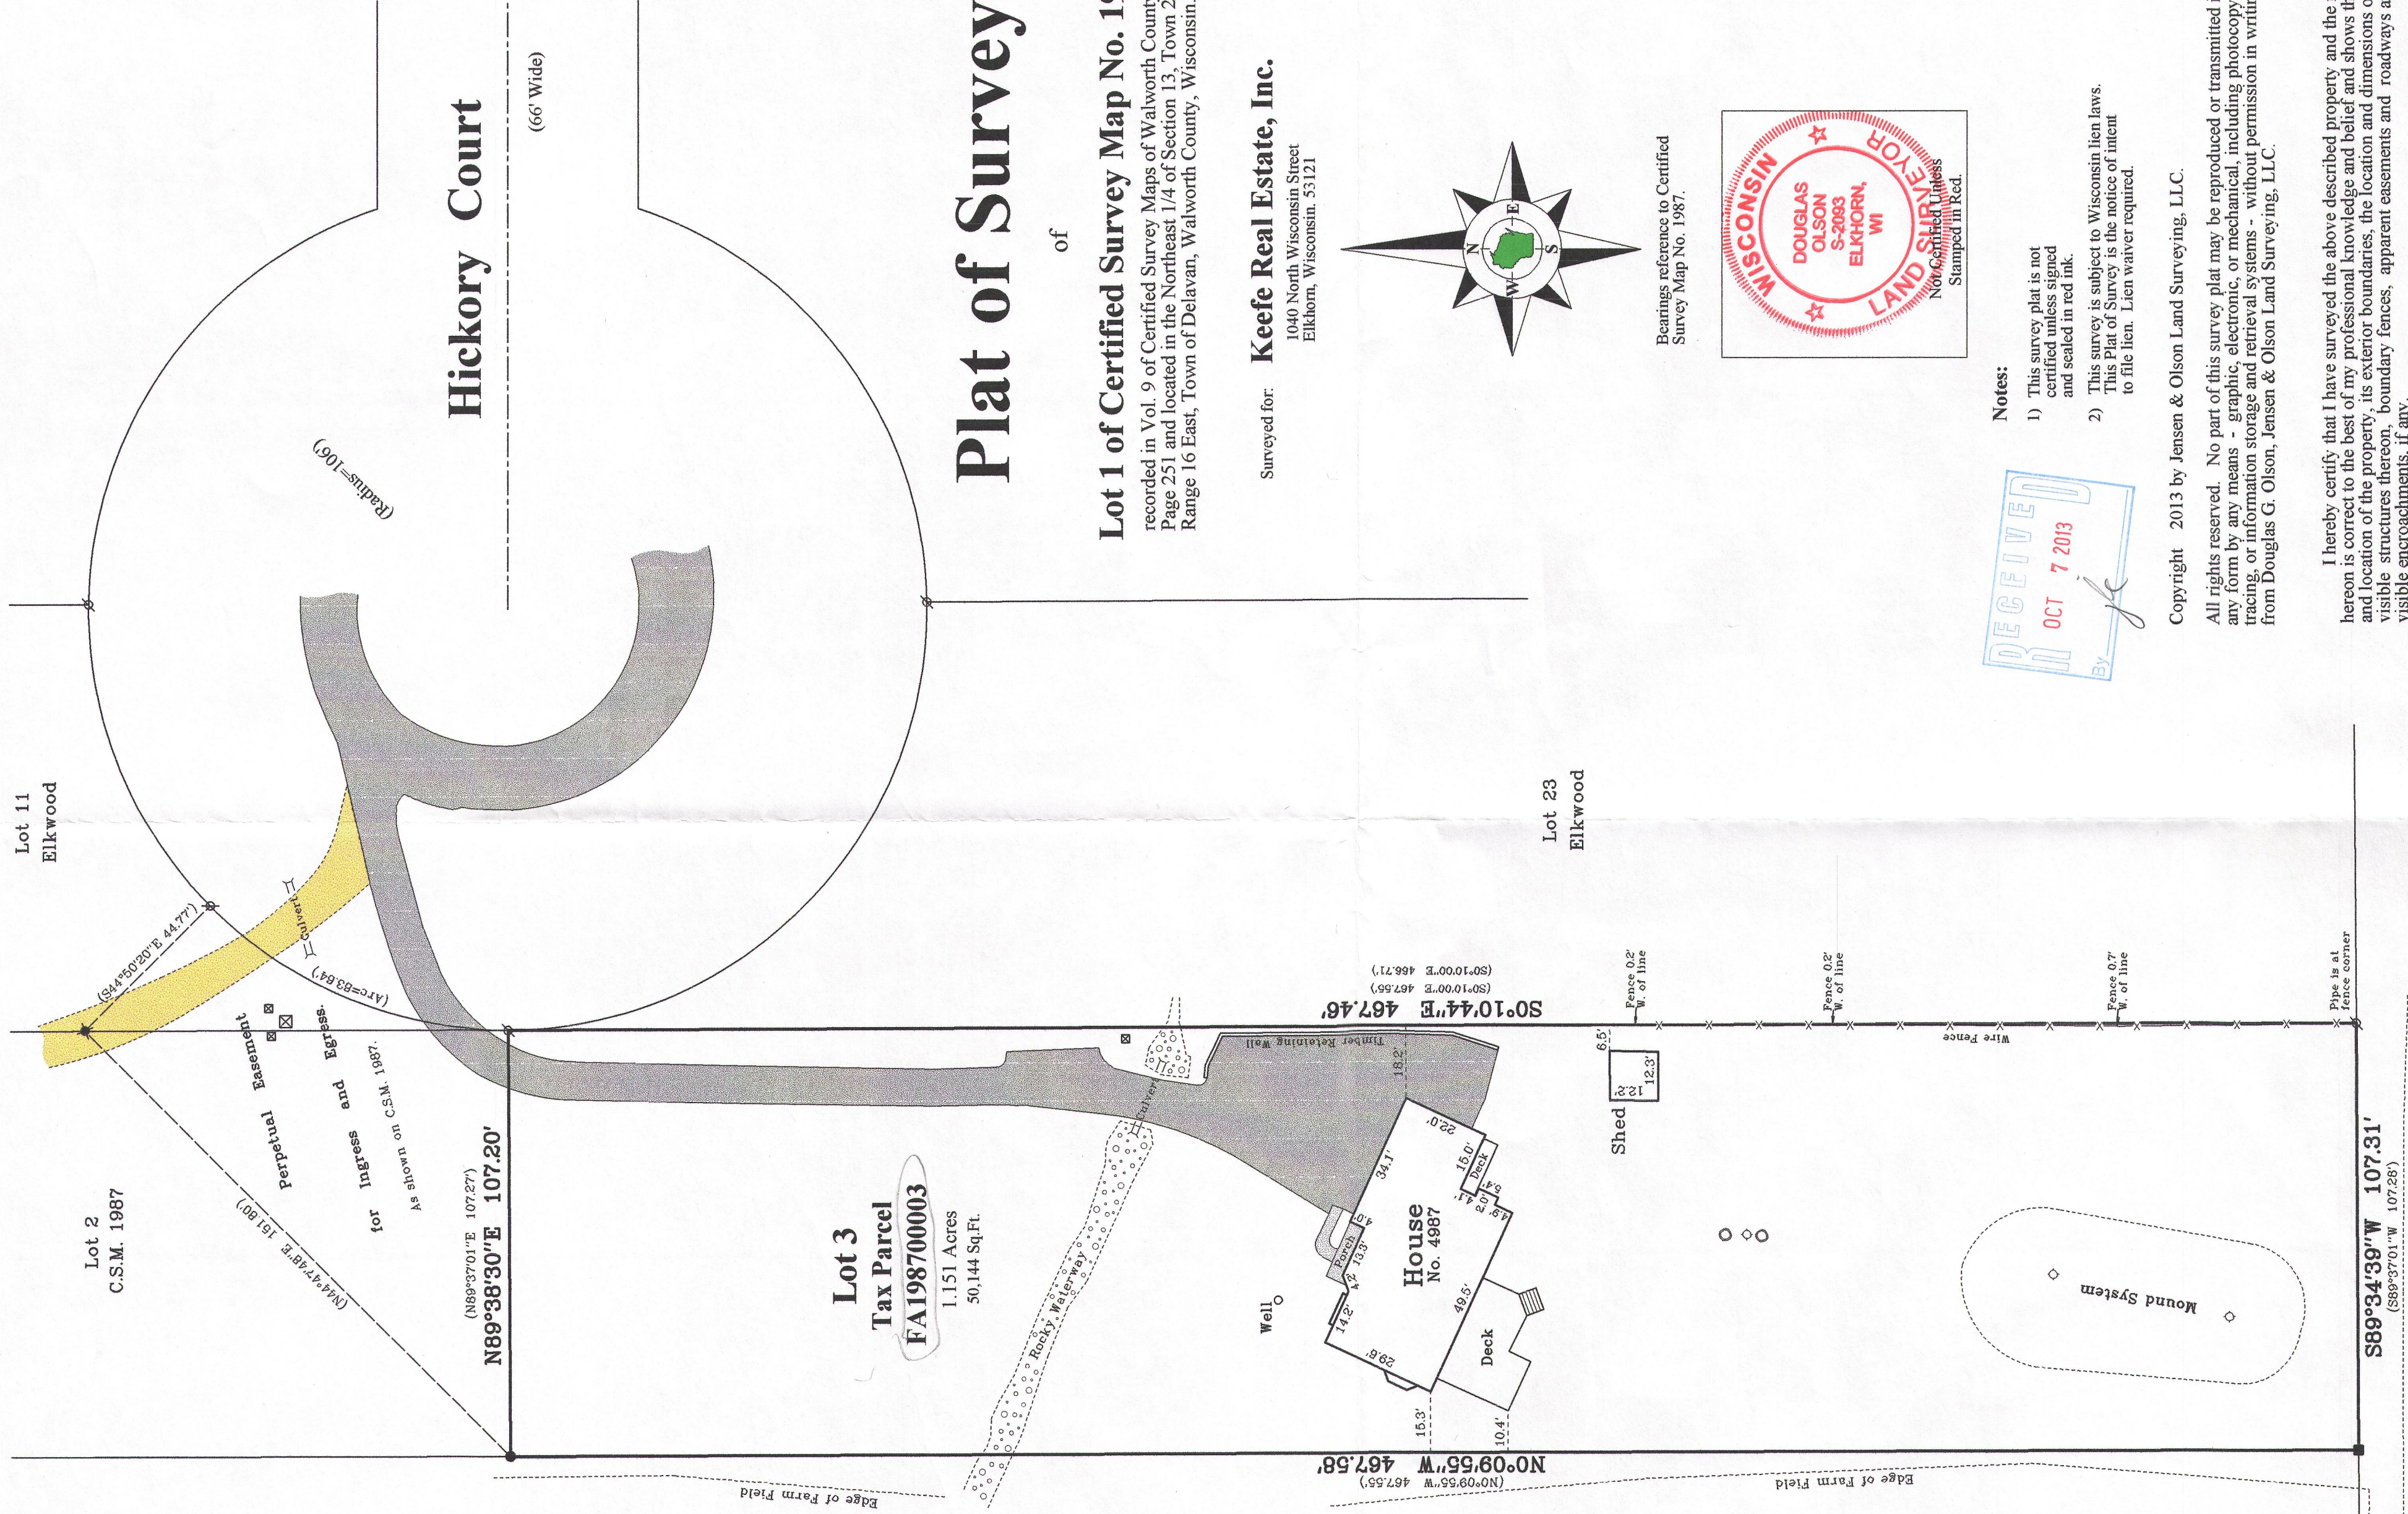


Plat of Survey
of
Lot 1 of Certified Survey Map No. 1987,
recorded in Vol. 9 of Certified Survey Maps of Walworth County on
Page 251 and located in the Northeast 1/4 of Section 13, Town 2 North,
Range 16 East, Town of Delavan, Walworth County, Wisconsin.


Tax Parcel
FD 1300002

Lot 3
Tax Parcel
FA198700003
1.151 Acres
50,144 Sq.Ft.

Surveyed for:
Keefe Real Estate, Inc.
1040 North Wisconsin Street
Elkhorn, Wisconsin. 53121

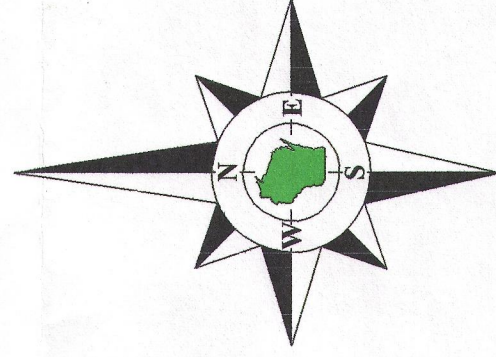

Bearings reference to Certified
Survey Map No. 1987.

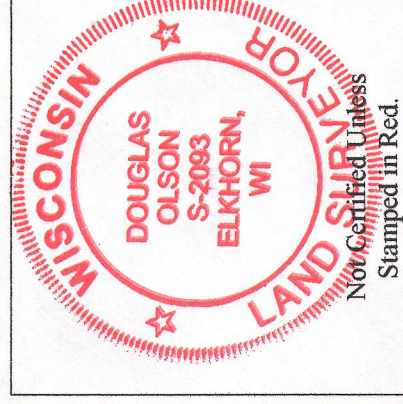

Notes:

- 1) This survey plat is not certified unless signed and sealed in red ink.
- 2) This survey is subject to Wisconsin lien laws. This Plat of Survey is the notice of intent to file lien. Lien waiver required.



Copyright 2013 by Jensen & Olson Land Surveying, LLC.

All rights reserved. No part of this survey plat may be reproduced or transmitted in any form by any means - graphic, electronic, or mechanical, including photocopying, tracing, or information storage and retrieval systems - without permission in writing from Douglas G. Olson, Jensen & Olson Land Surveying, LLC.

I hereby certify that I have surveyed the above described property and the map hereon is correct to the best of my professional knowledge and belief and shows the size and location of the property, its exterior boundaries, the location and dimensions of all visible structures thereon, boundary fences, apparent easements and roadways and visible encroachments, if any.

This survey is made for the exclusive use of the present owners of the property, and also those who purchase, mortgage or guarantee title thereto, within one year from the date hereof.

Douglas G. Olson
Wisconsin Registered Land Surveyor - 2093

Tax Parcel
FD 1300017

Sheet 1 of 1 Sheets

Drawing Name: D:\16-2013\066-2013\066P\16.sjg

Job Reference Number

2013.066

Legend

- Found Concrete Monument
- Found Iron Pipe
- Found Iron Rod
- Set 60d Spike
- Surveyed Information
- Utility and Pedestal
- Concrete Cover
- Asphalt Surface
- Concrete Surface
- Gravel



Jensen & Olson Land Surveying, LLC

45 South Wisconsin Street * P.O. Box 322 * Elkhorn, Wisconsin. 53121

Telephone: (262) 723-3434 * Facsimile: (262) 723-8044


Email: jensen.olson@elknet.net

2013.066

Survey Date: June 20, 2013.
Revisions:

Scale in Feet

1" = 30'

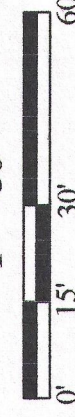

216-5052