


PREPARED FOR
BILL PERKINS

PLAT OF SURVEY

PATHFINDER SURVEYING INC.
(formerly)
J.K. SURVEYING INC.
P.O BOX 322
LAKE GENEVA, WI. 53147
WWW.PATHFINDERSURVEYING.NET
262-248-8303

- OF -

LOTS 23 AND 24. BLOCK 2, SOUTH SHORE MANOR, A SUBDIVISION
LOCATED IN THE SE 1/4 OF SECTION 32, TOWN 2 NORTH, RANGE 16
EAST, TOWN OF DELAVAN, WALWORTH COUNTY, WISCONSIN.

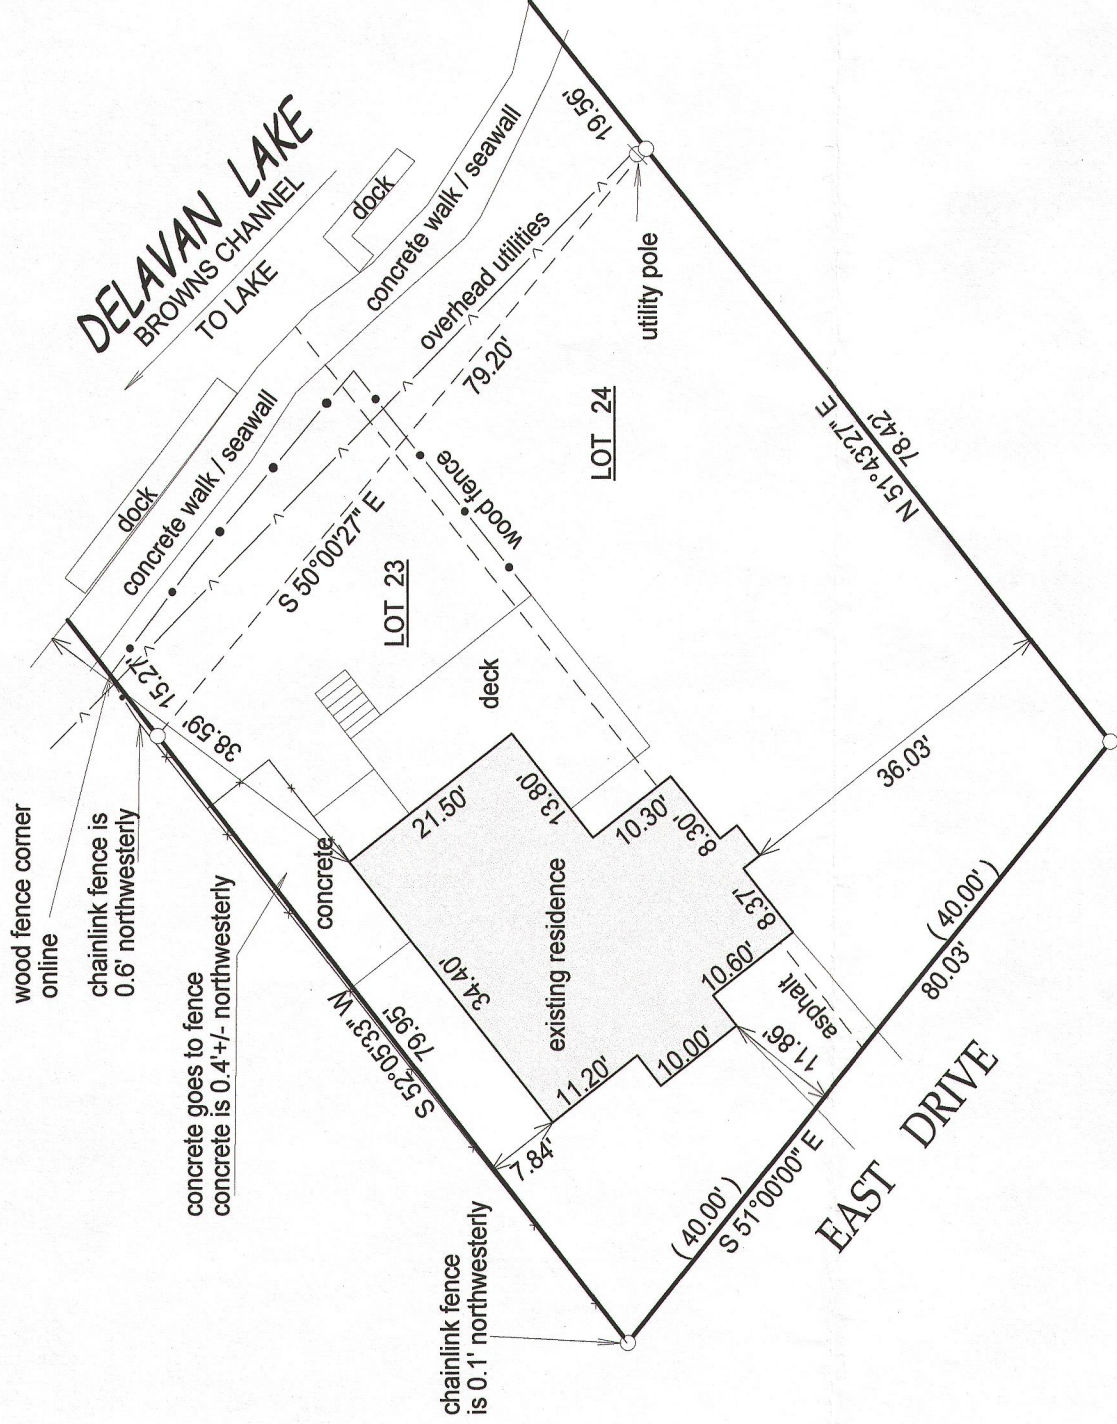


- () = recorded as
- = found iron bar
 - = found iron pipe
 - = set iron pipe
 - = set iron bar

SCALE 1" = 20'

JOB # 13-171

TAX ID #
FSS00045 / FSS00046

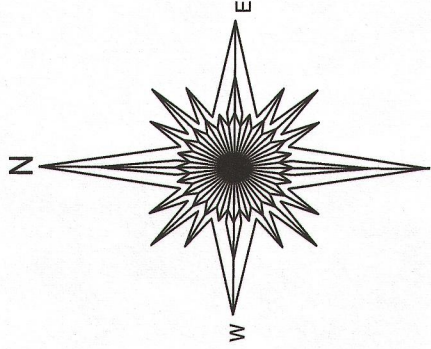


BASIS OF BEARING OF THIS PLAT: THE EAST LINE OF
EAST DRIVE WAS ASSUMED TO BEAR S 51°00' E.

I hereby certify that I have surveyed the above- described property and the
above map is a true representation thereof and shows the size and
location of the property, its exterior boundaries, the location and
dimensions of all structures thereon, fences, apparent easements and
roadways and visible encroachments if any.

This survey is made for the present owners of the property, and those who
purchase, mortgage, or guarantee the title thereto, within one year from
the date hereof.

DATED THIS 12TH DAY OF SEPTEMBER, 2013.

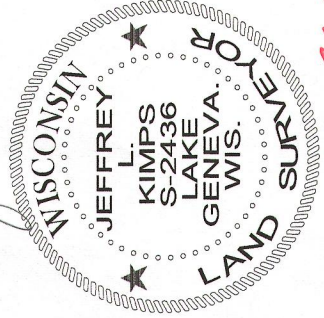

Jeffrey L. Kimps
JEFFREY L. KIMPS S - 2436
Wisconsin Registered Land Surveyor
(original if signed in red)

F88-45
F88-40

216-5060