


PREPARED FOR
CENTURY 21 AFFILIATED
DELAVAN WI.
RENEA DUNBAR

PLAT OF SURVEY

- OF -

PATHFINDER SURVEYING INC.
(formerly)
J.K. SURVEYING INC.
P.O BOX 322
LAKE GENEVA, WI. 53147
WWW.PATHFINDERSURVEYING.NET
262-248-8303

LOT 40, BLOCK 20 DELAVAN LAKE-VIEW CREST, BEING A SUBDIVISION
OF PART OF THE NORTH 1/2 OF SECTION 31, TOWN 2 NORTH, RANGE
16 EAST OF THE FOURTH PRINCIPAL MERIDIAN, TOWN OF DELAVAN,
WALWORTH COUNTY, L, WISCONSIN.

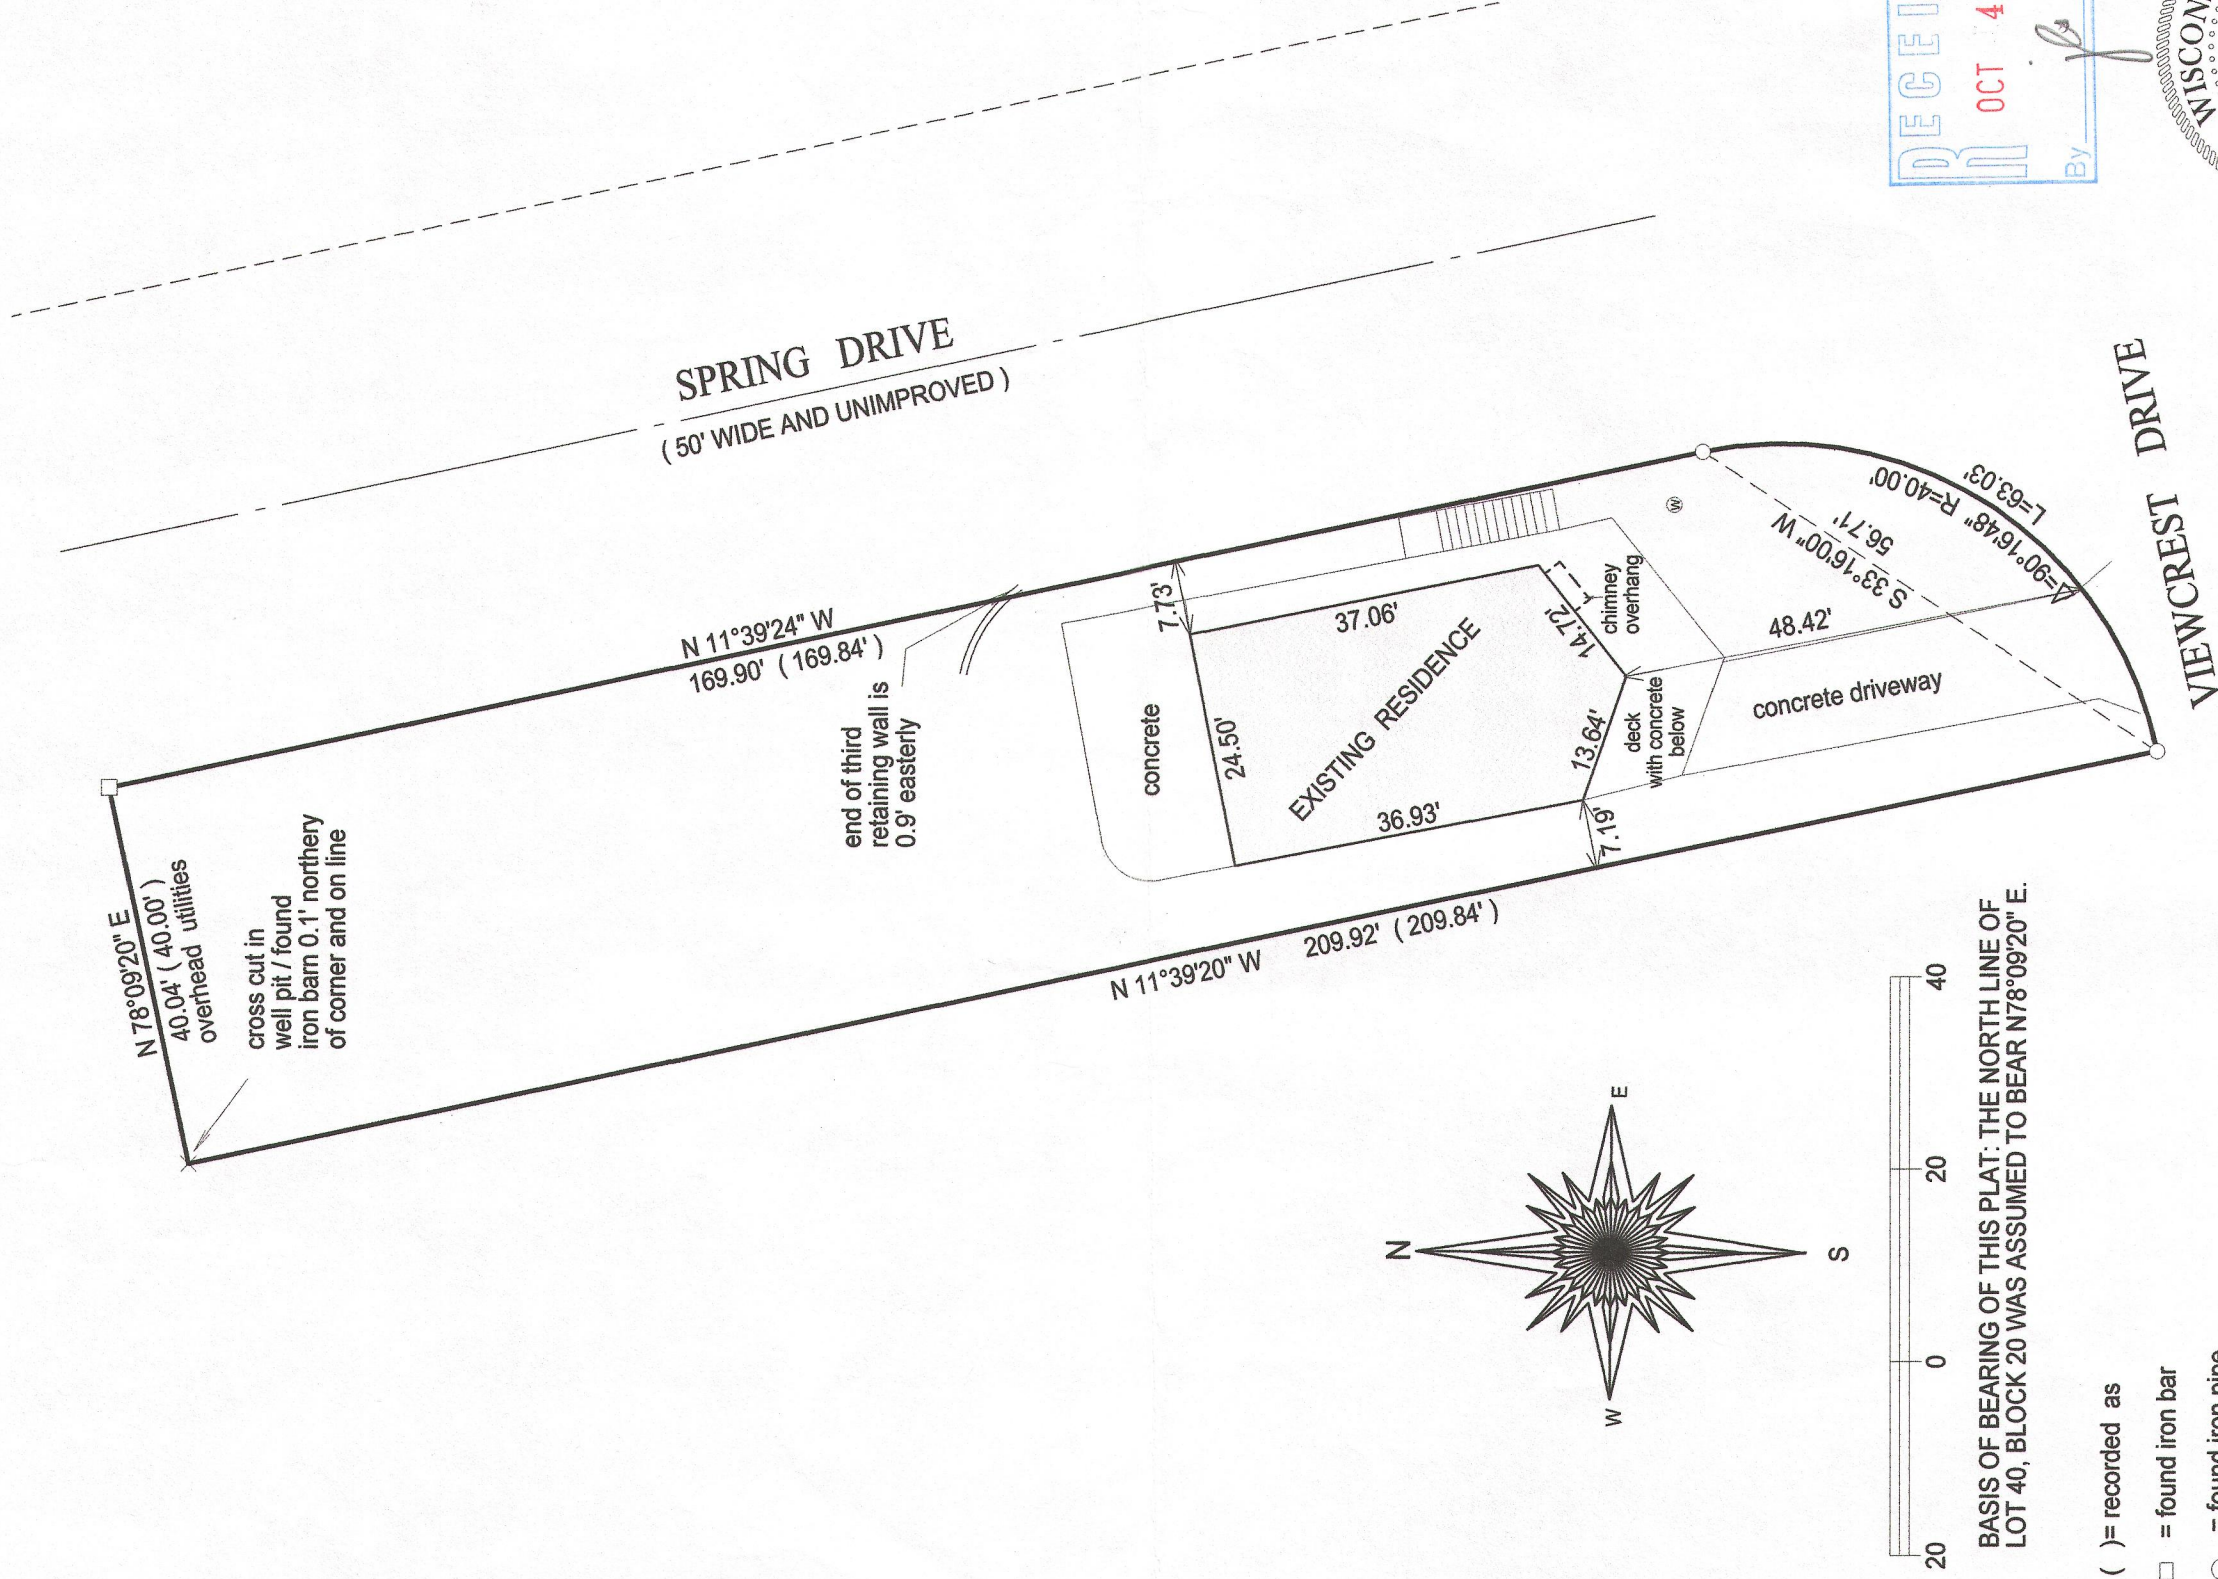

BASIS OF BEARING OF THIS PLAT: THE NORTH LINE OF
LOT 40, BLOCK 20 WAS ASSUMED TO BEAR N78°09'20" E.

- () = recorded as
□ = found iron bar
○ = found iron pipe
● = set iron pipe
■ = set iron bar

SCALE 1" = 20'


JOB # 13-110

TAX ID # FDLV00223

I hereby certify that I have surveyed the above- described property and the
above map is a true representation thereof and shows the size and
location of the property, its exterior boundaries, the location and
dimensions of all structures thereon, fences, appurtenant easements and
roadways and visible encroachments if any.

This survey is made for the present owners of the property, and those who
purchase, mortgage, or guarantee the title thereto, within one year from
the date hereof.

DATED THIS 15TH DAY OF JULY 2013.

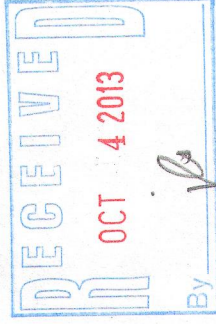

Jeffrey L. Kimps
JEFFREY L. KIMPS S - 2436
Wisconsin Registered Land Surveyor
(original if signed in red)

216-5066