
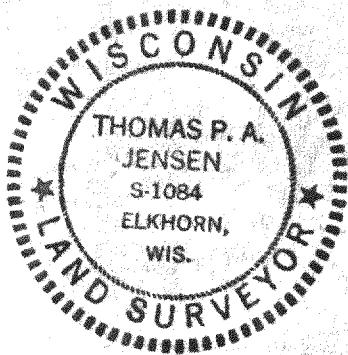


PLAT OF SURVEY

OF
LOT 15 OF BLOCK 2 OF DELMAR, A SUBDIVISION
LOCATED IN SECTION 27, TOWNSHIP 2 NORTH, RANGE
16 EAST, WALWORTH COUNTY, WISCONSIN

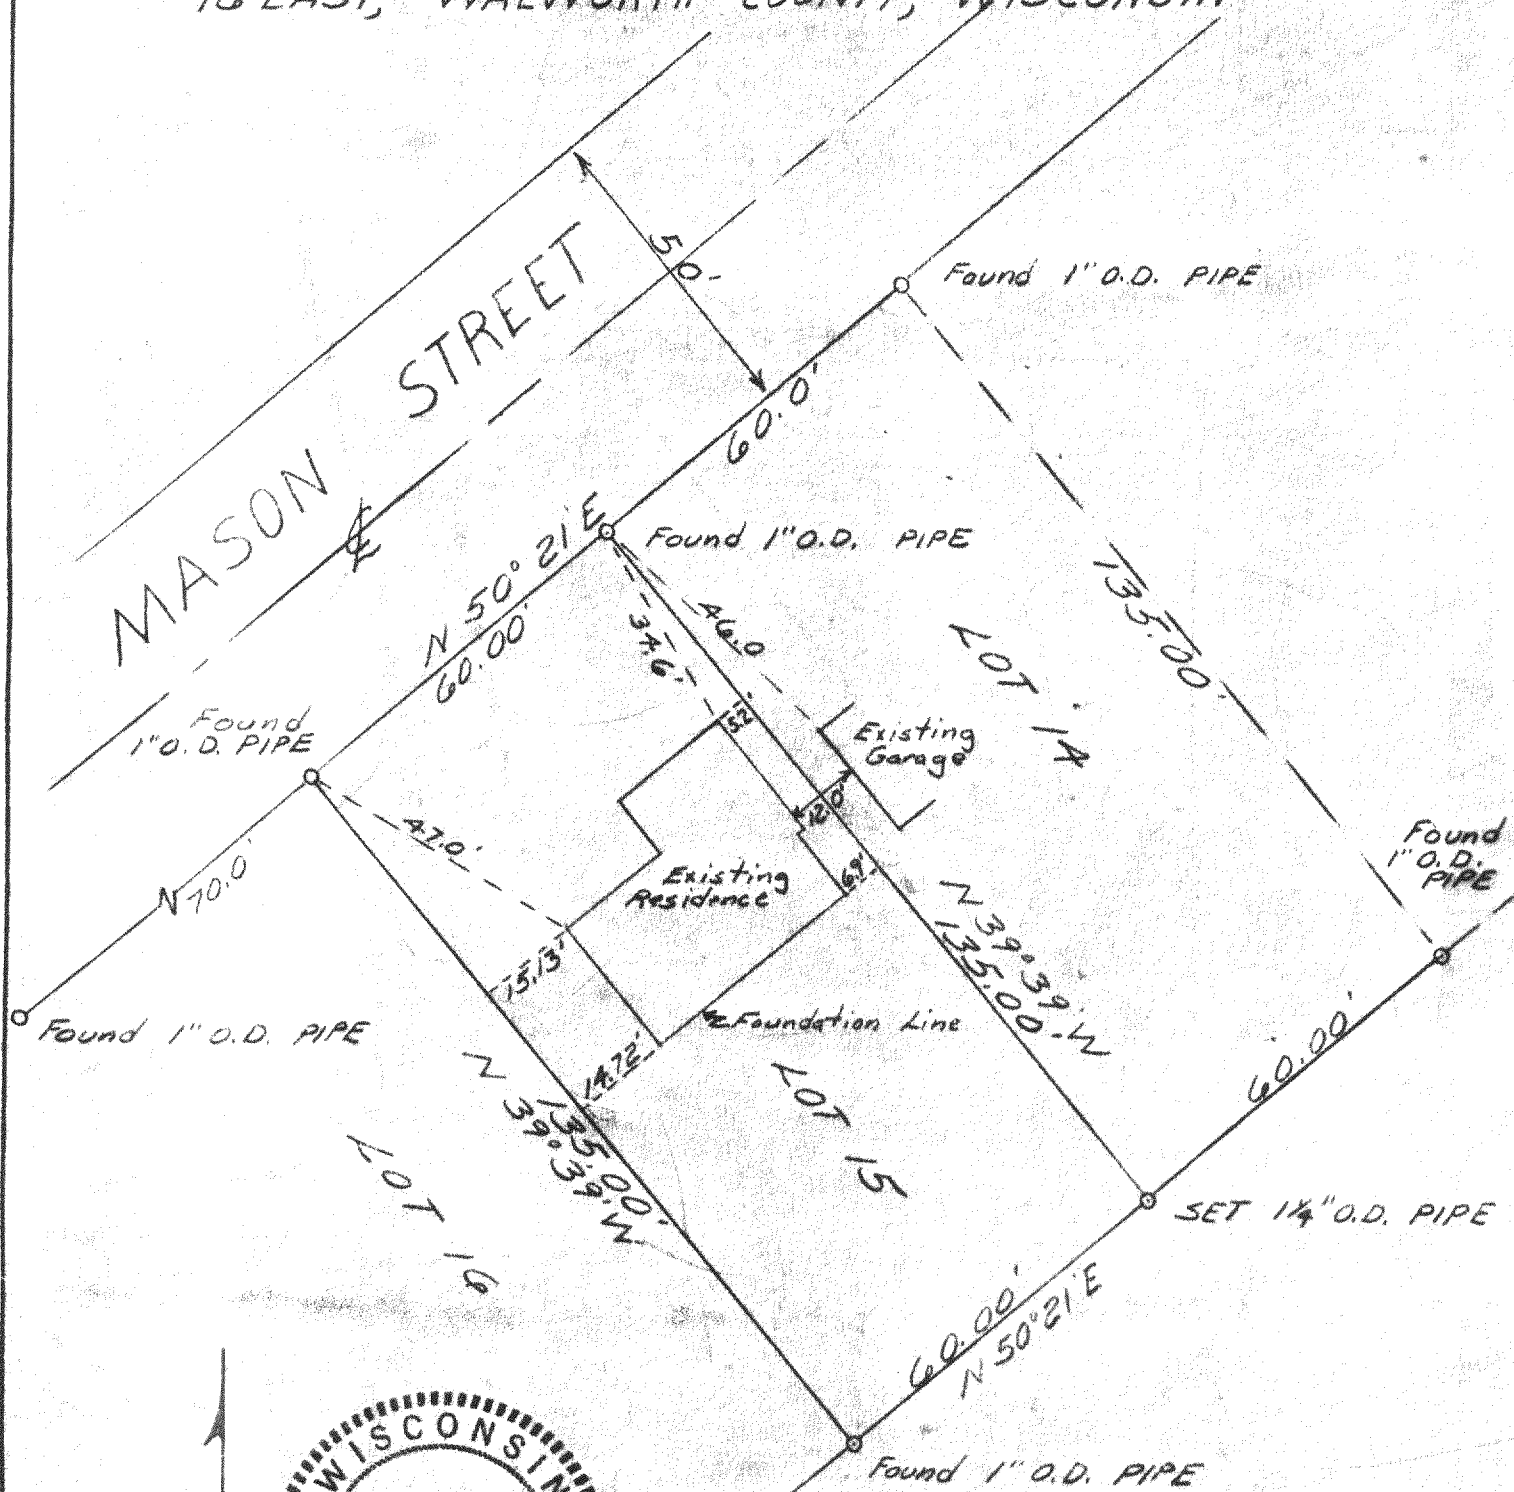

SURVEY AND PLAT BY
JENSEN & JOHNSON, INC.
CIVIL ENGINEERS AND SURVEYORS
Elkhorn, Wisconsin

LEGEND

- — Iron Pipe
 - — Concrete Monument
- Scale 1" = 30'

WE CERTIFY: That we have surveyed the above described property and that the plat shown hereon is an accurate survey and a true representation thereof and correctly shows the exterior boundary lines and all divisions of said property.

Date 16 JUNE 1975

Thomas P. A. Jensen

JENSEN & JOHNSON, INC.

Wisconsin Registered Land Surveyor, No. S-1084

FDM-11C