
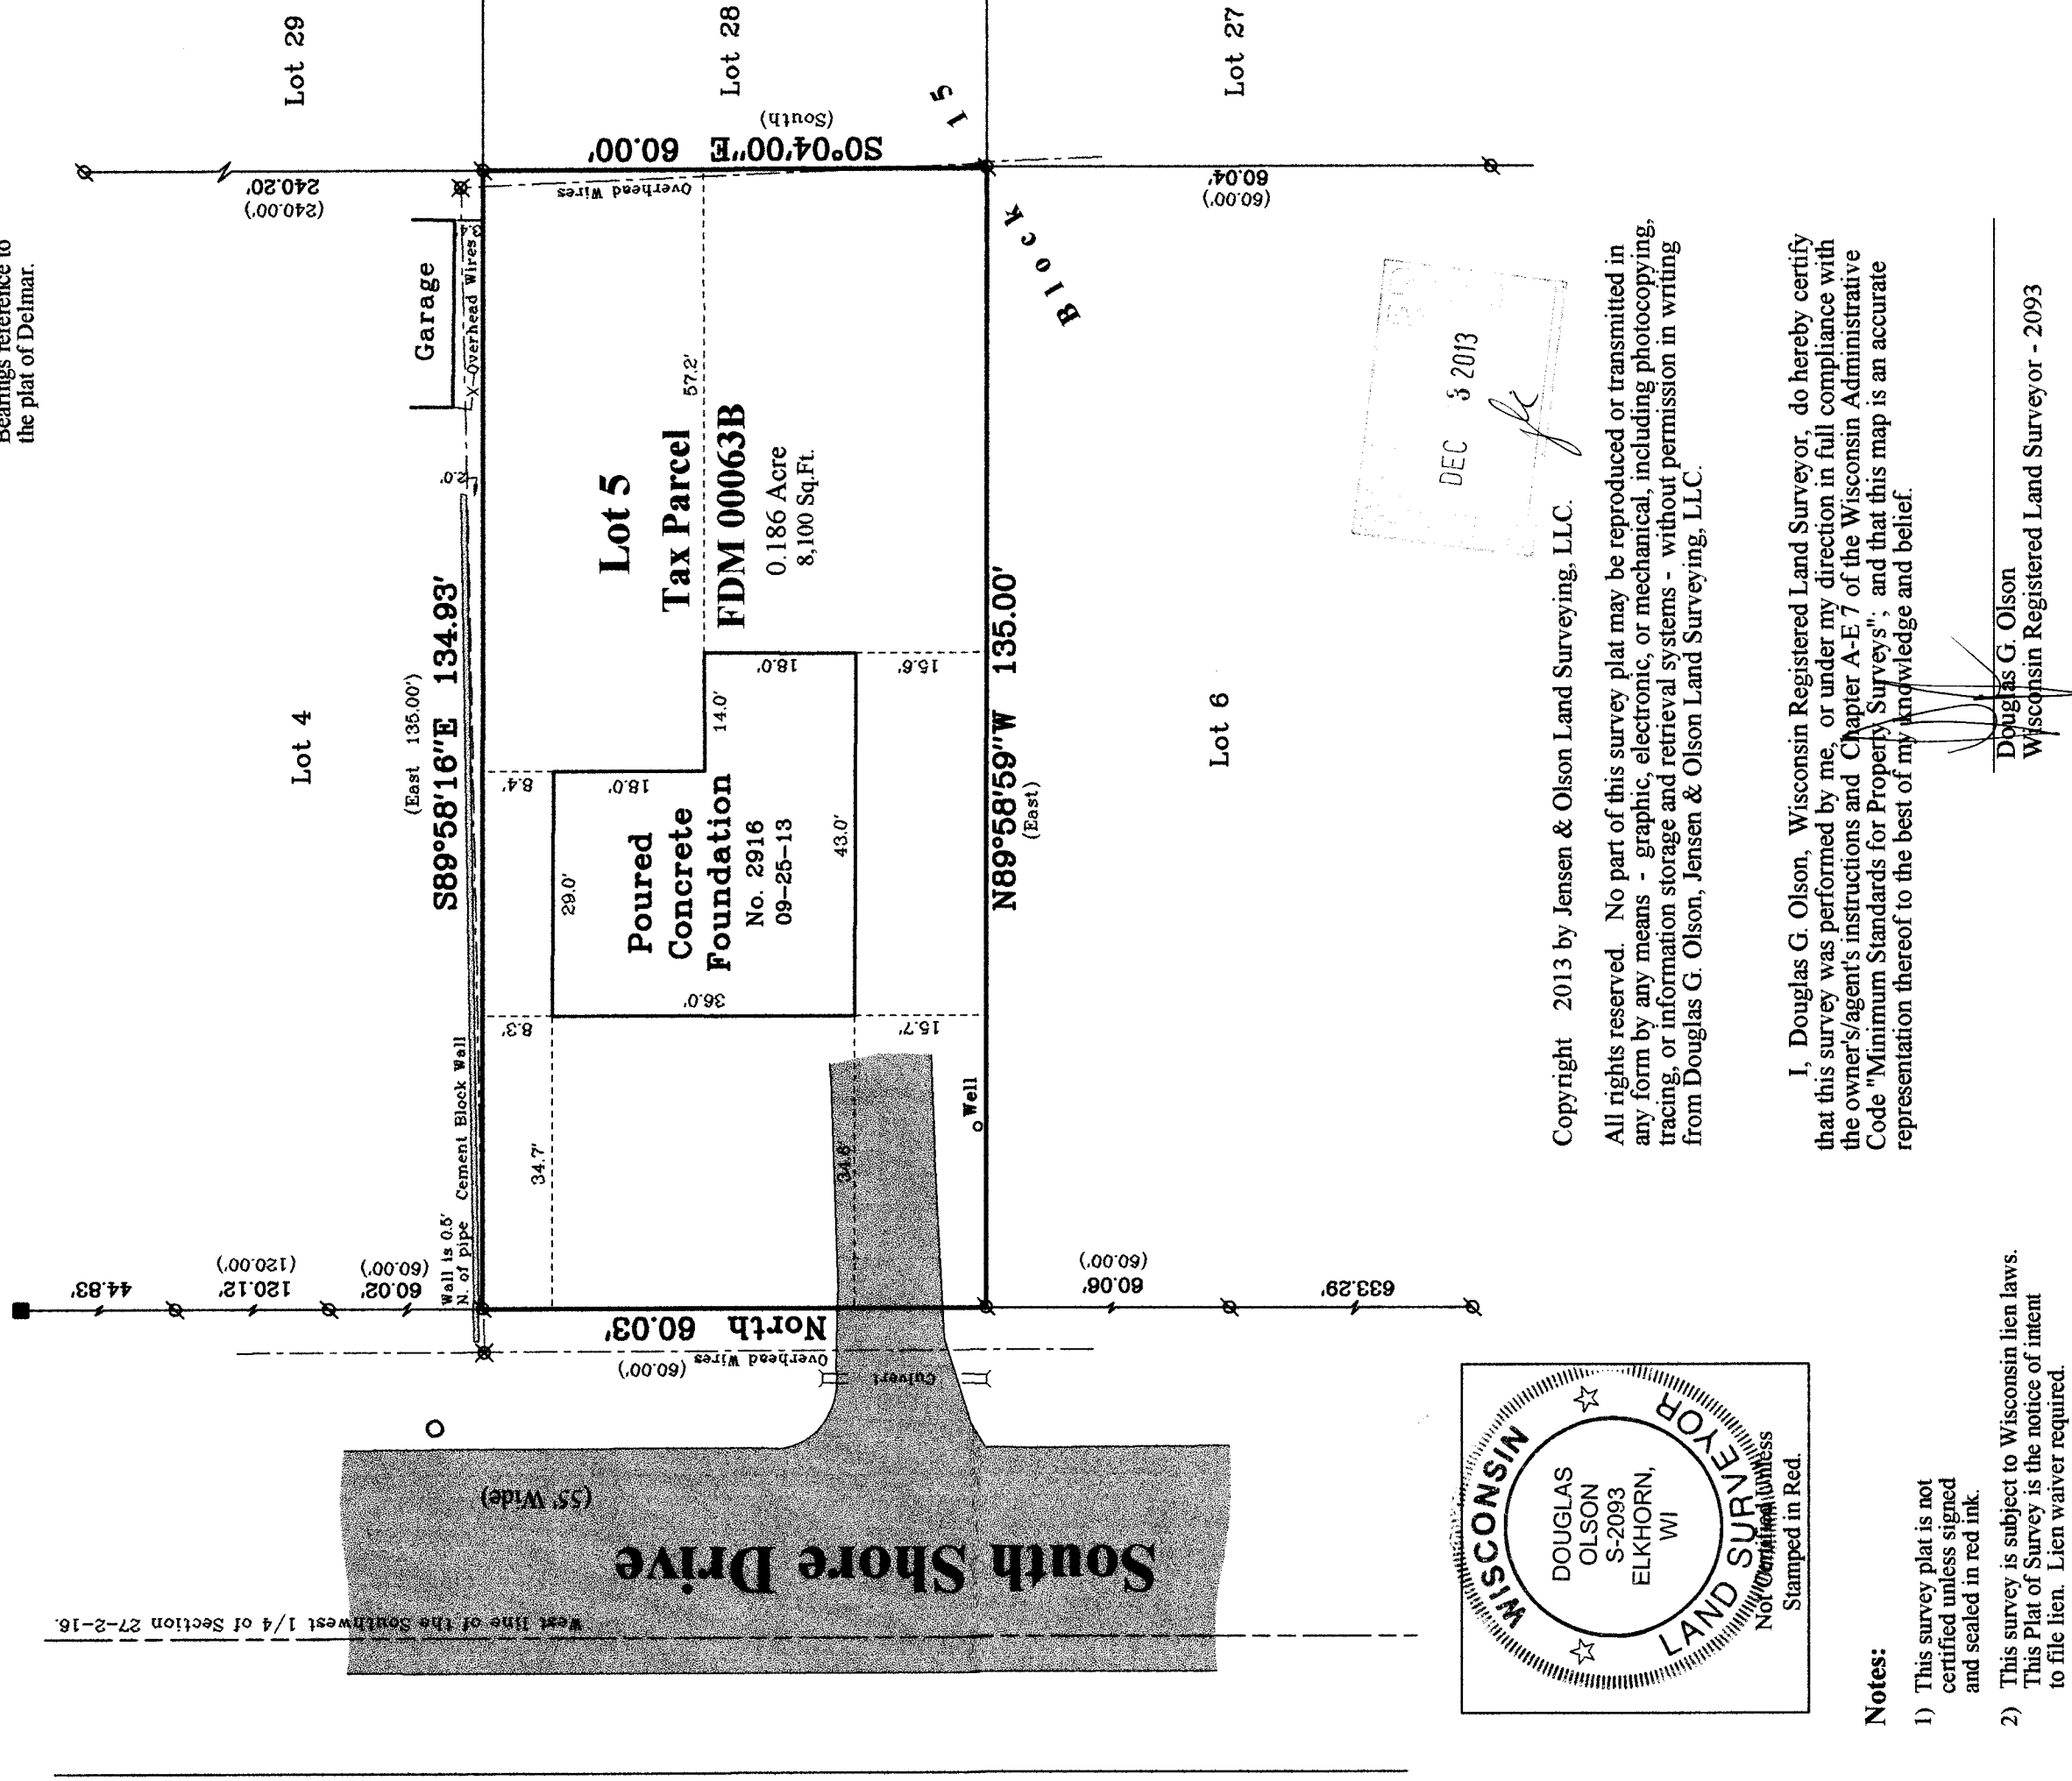


of

a subdivision located in the Southwest 1/4 of Section 27, Town 2 North, Range 16 East, Town of Delavan, Walworth County, Wisconsin.

Jorndt Builders, Inc.
168 Elkhorn Road
Williams Bay, Wisconsin. 53191

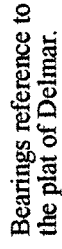

■ Found Concrete Monument
 Ø Found Iron Pipe
 () Recorded Information
 ✕ Utility Pole
 ○ Manhole
 Asphalt Surface

45 South Wisconsin Street * P.O. Box 322 * Elkhorn, Wisconsin. 53121

Telephone: (262) 723-3434 * Facsimile: (262) 723-8044

Email: jensen.olson@elknet.net

Survey date: September 25, 2013.

Revisions:

216-5075
Sheet

Sheet 1 of 1 Sheets.

FDN-63B

Scale: 1" = 20'

Job Reference Number:

2012.060