

LAND-MARK SURVEYING
Mark L. Miritz

Wisconsin Registered Land Surveyor S-2582

N9330 Knuteson Drive
Whitewater, WI 53190
Phone: (262) 495-3284
MARKMIRITZ@
LAND-MARKSURVEYING.COM



PLAT OF SURVEY

THE SOUTH 1/2 OF LOT 4, ALL OF LOT 5, AND THE NORTH 1/2 OF LOT 6,
BLOCK "O" OF DELAVAN LAKE ASSEMBLY GROUNDS, LOCATED IN THE
SOUTHEAST 1/4 OF SECTION 21, TOWN 2 NORTH, RANGE 16 EAST,
DELAVAL TOWNSHIP, WALWORTH COUNTY, WISCONSIN.

ORDERED BY: RUSSELL J. DEPIETRO
DEPIETRO DESIGN ASSOCIATES
212 1/2 EAST WALWORTH AVENUE
DELAVAL, WI 53115

NOTE:

THERE IS NO CURVE DATA ON THE ORIGINAL PLAT
OF DELAVAN LAKE ASSEMBLY GROUND. THE WESTERLY
LINES OF LOTS 4, 5, & 6, BLOCK "O" WERE SCALED OFF
THE ORIGINAL PLAT

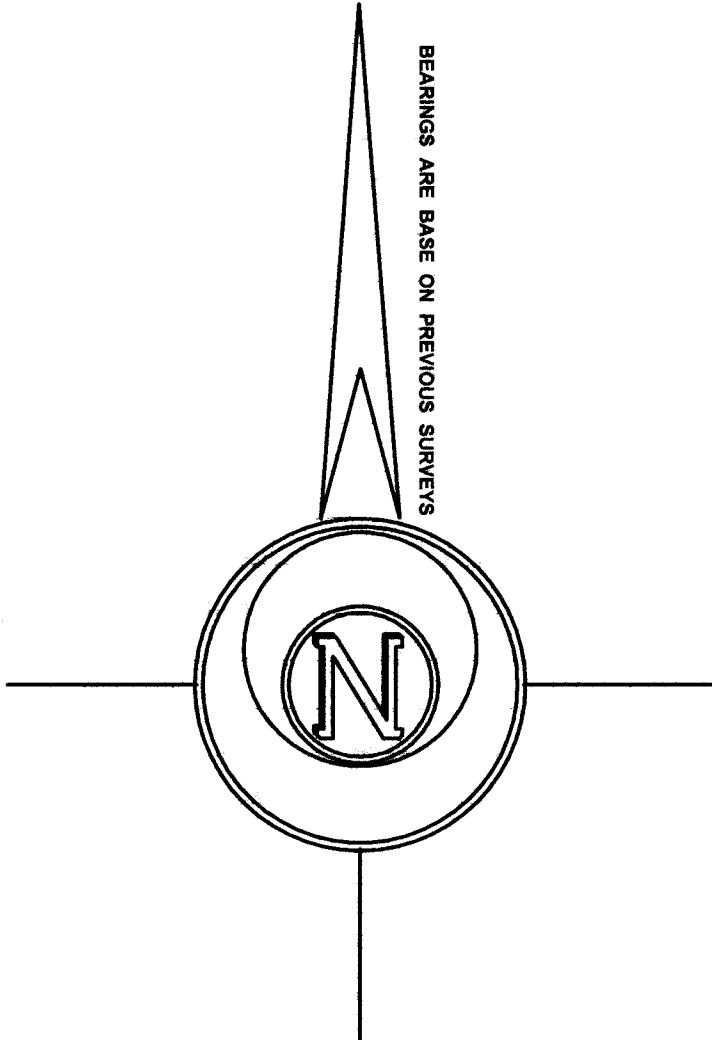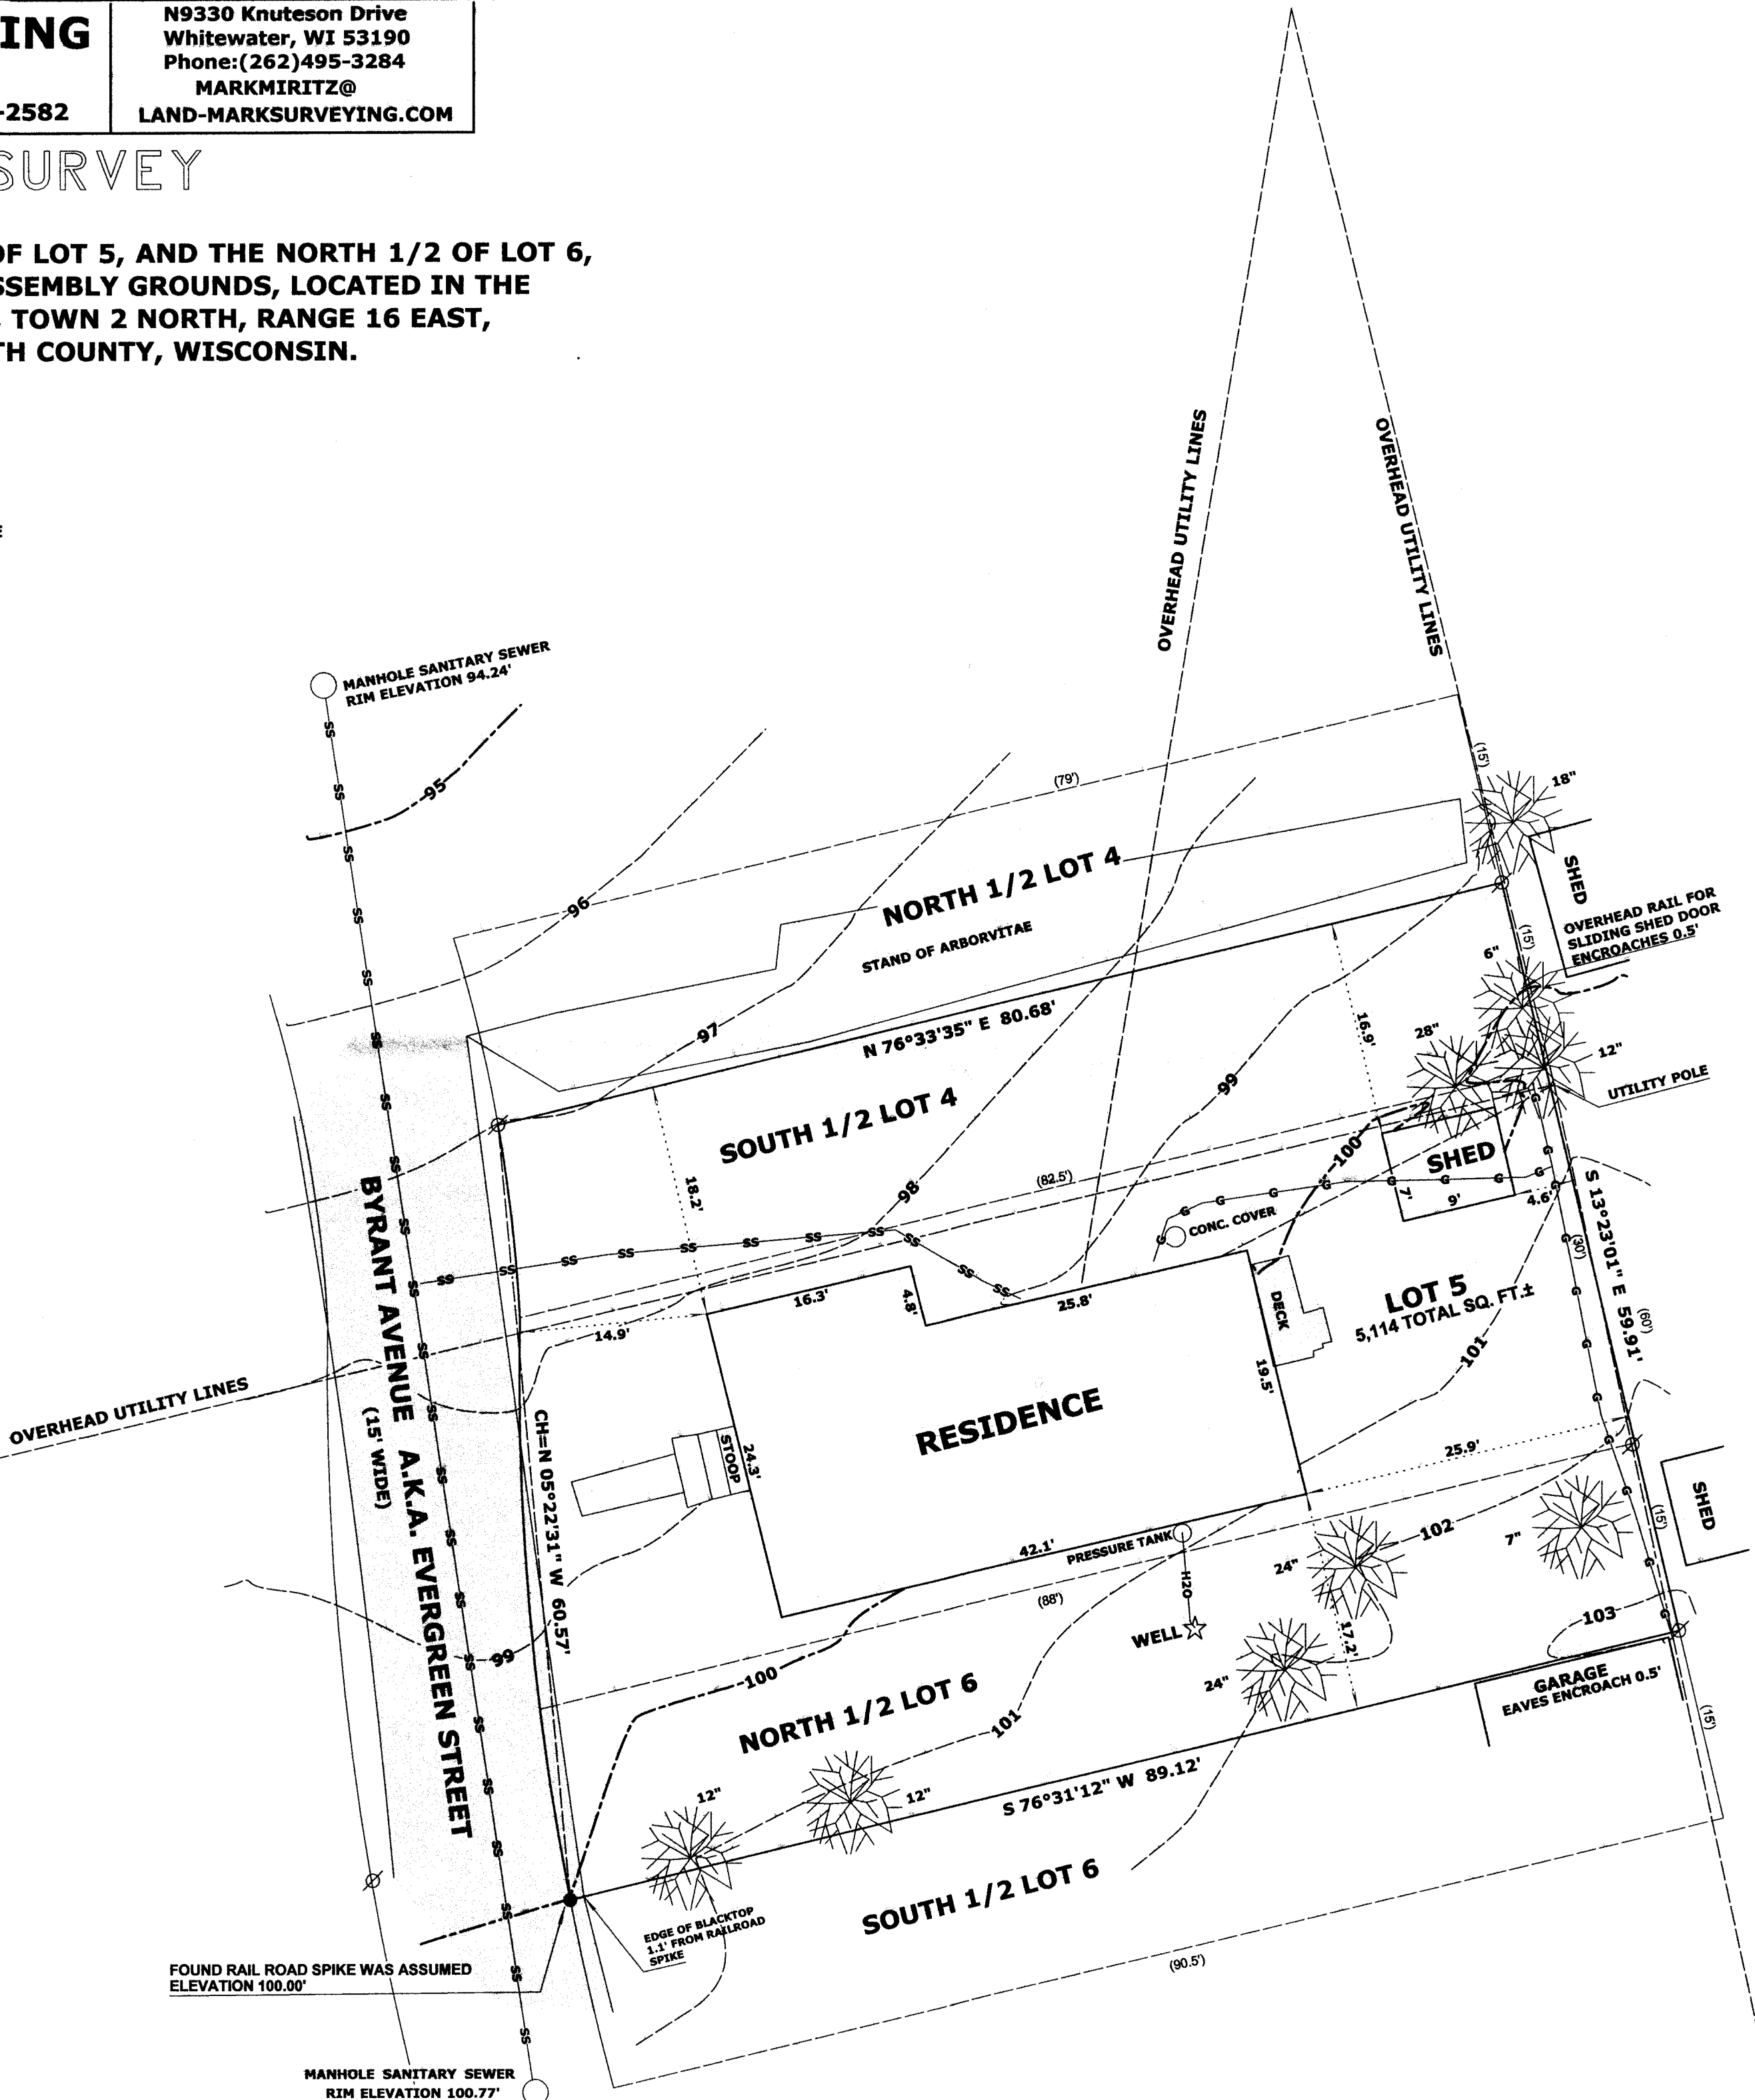


LEGEND

- TREE DIAMETER IN INCHES
- FOUND IRON PIPE
- FOUND RAIL ROAD SPIKE
- RECORDED AS DIMENSION
- UNDERGROUND SANITARY SEWER
- UNDERGROUND GAS LINE

SCALE: 1 INCH= 10 FEET

"I hereby certify that the above described property
has been surveyed by me or under my direction in
full compliance with the owner's/agent's instructions
and Chapter A-E 7 of the Wisconsin Administrative Code
"Minimum Standards for property surveys"; that the above
map is correct to the best of my knowledge and belief."

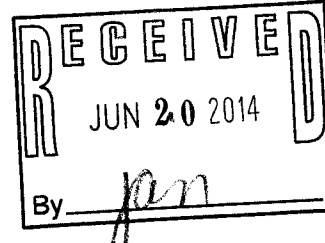

Mark L. Miritz
MARK L. MIRITZ
WISCONSIN REGISTERED
LAND SURVEYOR S-2582

DATE: APRIL 28, 2014 JOB NO. 14.403