



PREPARED FOR
LINDA TONGE
KEEFE REAL ESTATE
LAKE GENEVA WI

PLAT OF SURVEY

- OF -

PATHFINDER SURVEYING INC.
(formerly)
J.K. SURVEYING INC.
P.O BOX 322
LAKE GENEVA, WI. 53147
WWW.PATHFINDERSURVEYING.NET
262-248-8303

LOT 10 IN BLOCK "Z" OF THE DELAVAN LAKE ASSEMBLY GROUNDS, LOCATED
IN THE TOWN OF DELAVAN, COUNTY OF WALWORTH, AND STATE OF WISCONSIN;
AND BEING SOMETIMES DESCRIBED AS LOT 10 IN BLOCK "Z" OF THE DELAVAN
LAKE ASSEMBLY GROUNDS.

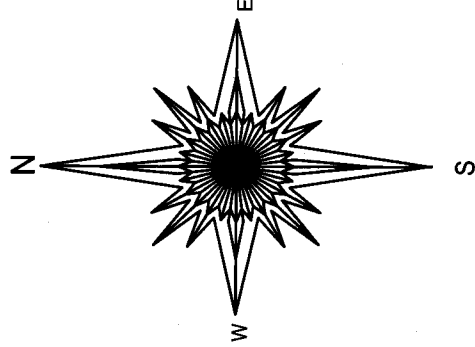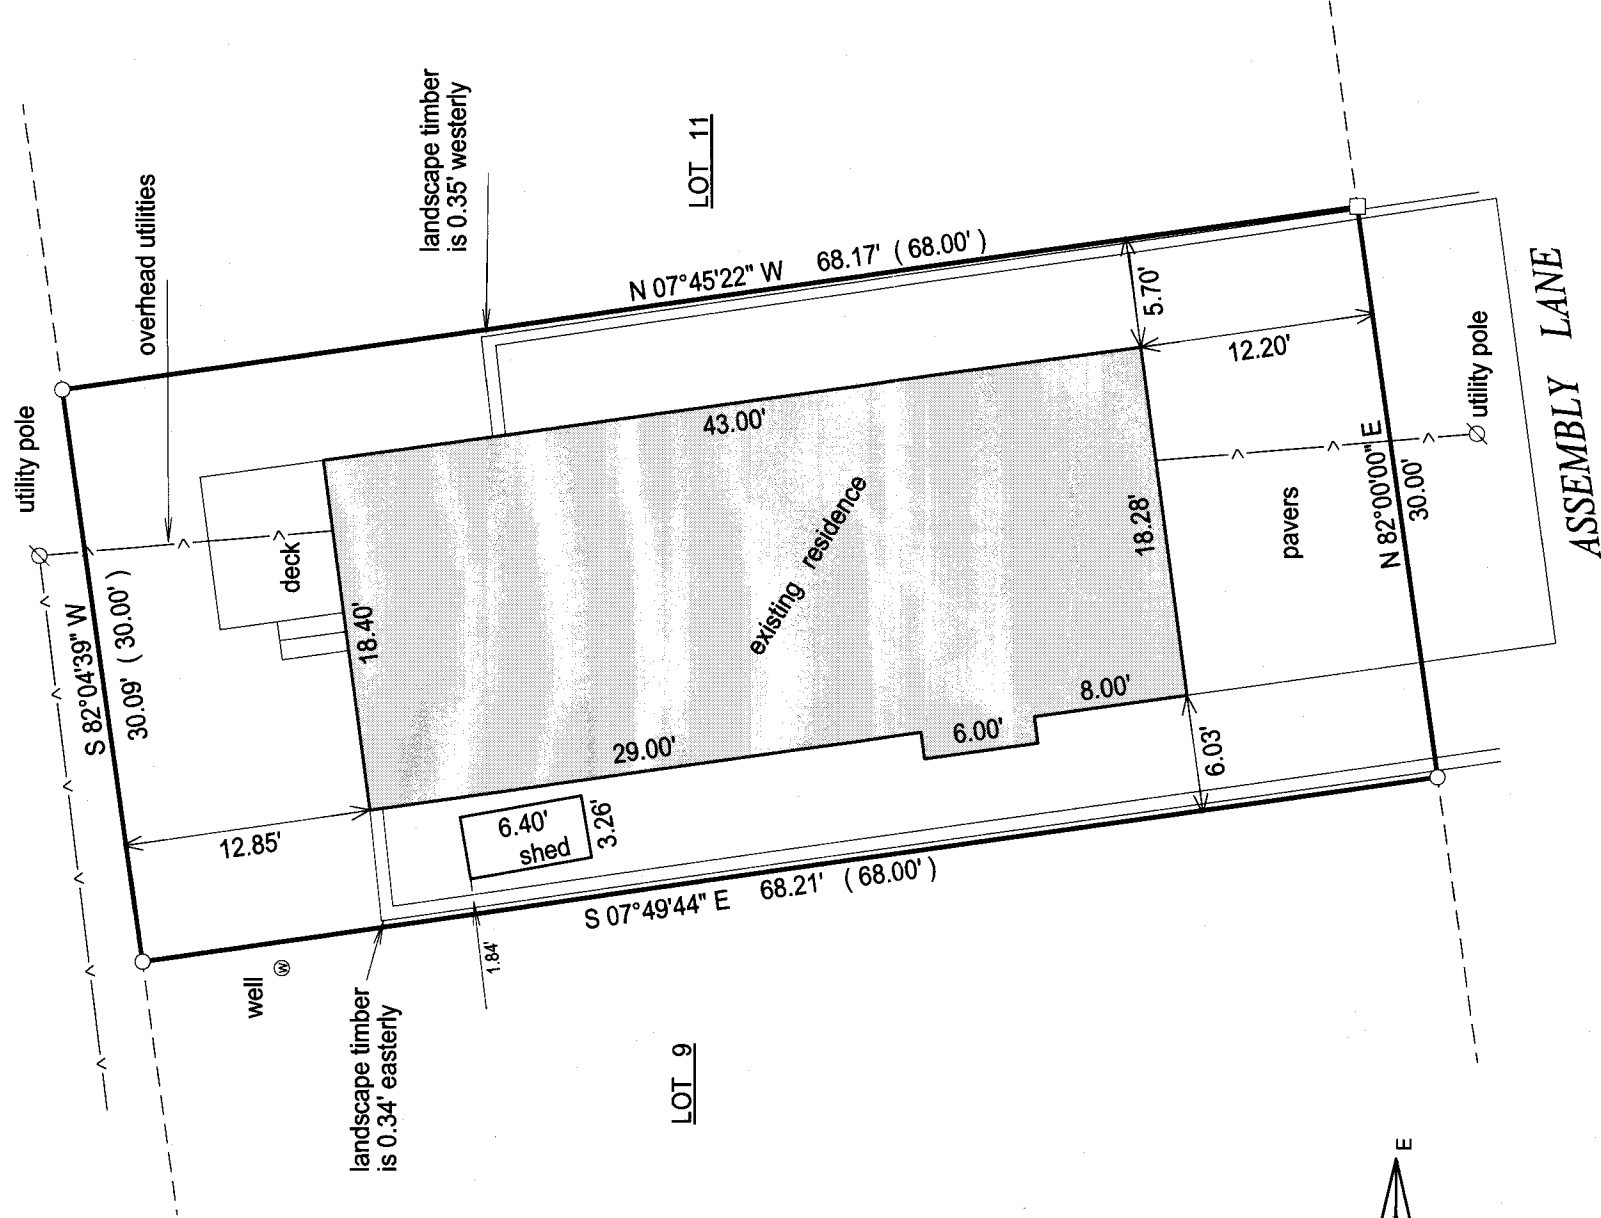


- () = recorded as
- = found iron bar
 - = found iron pipe
 - = set iron pipe
 - = set iron bar

SCALE 1" = 10'

JOB # 14-59

TAX ID #

FDLA 00222

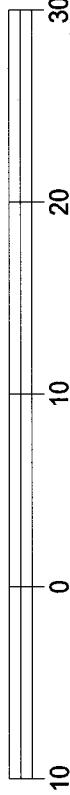

BASIS OF BEARING OF THIS PLAT: THE NORTHERLY LINE OF ASSEMBLY
LANE WAS ASSUMED TO BEAR N 82° E

I hereby certify that I have surveyed the above- described property and the
above map is a true representation thereof and shows the size and
location of the property, its exterior boundaries, the location and
dimensions of all structures thereon, fences, appurtenant easements and
roadways and visible encroachments if any.

This survey is made for the present owners of the property, and those who
purchase, mortgage, or guarantee the title thereto, within one year from
the date hereof.

DATED THIS 21ST DAY OF APRIL, 2014.

RECEIVED
JUN 13 2014
By *[Signature]*



JEFFREY L. KIMPS S - 2436
Wisconsin Registered Land Surveyor
(original if signed in red)

FDLA-222 216-5098