
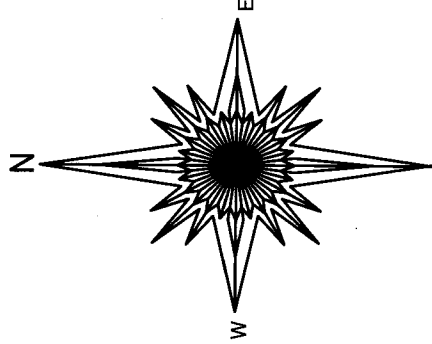


PLAT OF SURVEY

PATHFINDER SURVEYING INC.
(formerly)
J.K. SURVEYING INC.
P.O BOX 322
LAKE GENEVA, WI. 53147
WWW.PATHFINDERSURVEYING.NET
262-248-8303

- OF -

LOTS 11 AND 12, BLOCK 1 INLET OAKS SUBDIVISION No. 3, LOCATED
IN SECTIONS 15 AND 22, TOWN 2 NORTH, RANGE 16 EAST, TOWN OF
DELAVER, WALWORTH COUNTY, WISCONSIN.

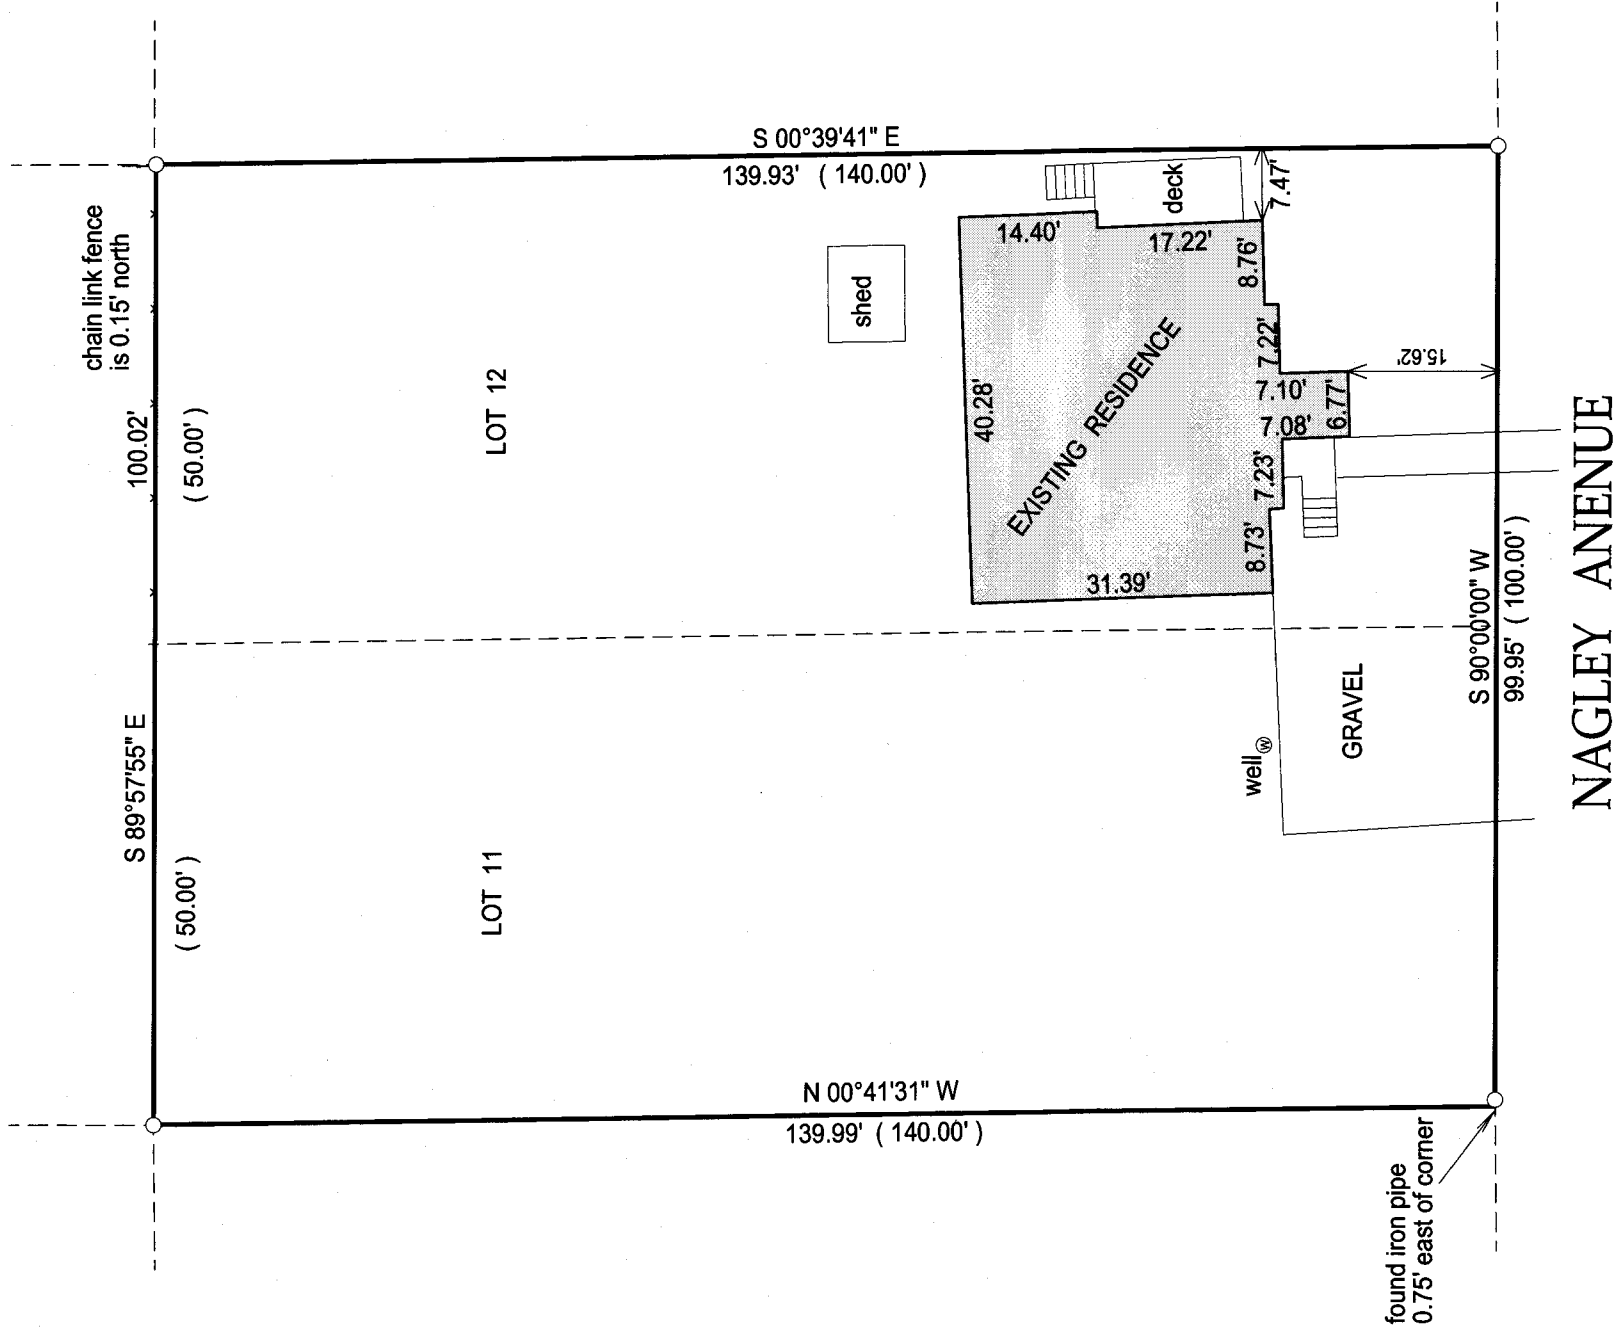

BASIS OF BEARING OF THIS PLAT: THE NORTH LINE OF NAGLEY AVE.
WAS ASSUMED TO BEAR WEST.

I hereby certify that I have surveyed the above- described property and the
above map is a true representation thereof and shows the size and
location of the property, its exterior boundaries, the location and
dimensions of all structures thereon, fences, apparent easements and
roadways and visible encroachments if any.

This survey is made for the present owners of the property, and those who
purchase, mortgage, or guarantee the title thereto, within one year from
the date hereof.

- () = recorded as
- = found iron bar
- = found iron pipe
- = set iron pipe
- = set iron bar



SCALE 1" = 20'

JOB # 14-72

TAX ID #

FIN3 00008

DATED THIS 7TH DAY OF MAY, 2014.

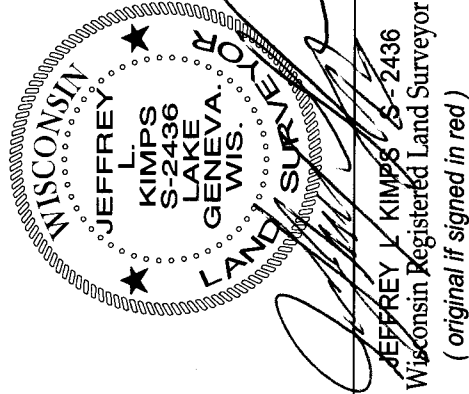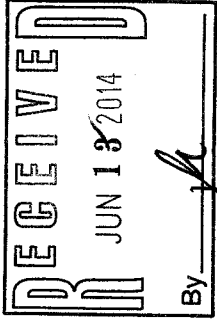

FIN3 -8 216-5099