



PLAT OF SURVEY OF LOTS 9 AND 10 OF WILLOW POINT PARK SUBDIVISION,
WHICH SUBDIVISION IS LOCATED IN THE SOUTHEAST $\frac{1}{4}$ OF FRACTIONAL
SECTION 29, T2N R16E OF WALWORTH COUNTY WISCONSIN.

AUG. 1944

Floyd L. Jensen
COUNTY SURVEYOR

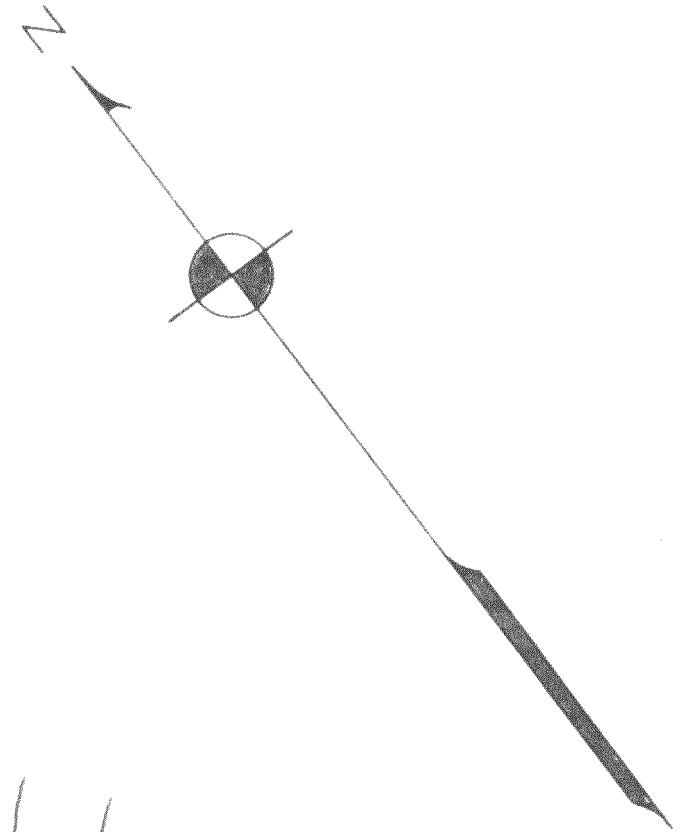

SCALE 1"=20'
0-IRON PIPE

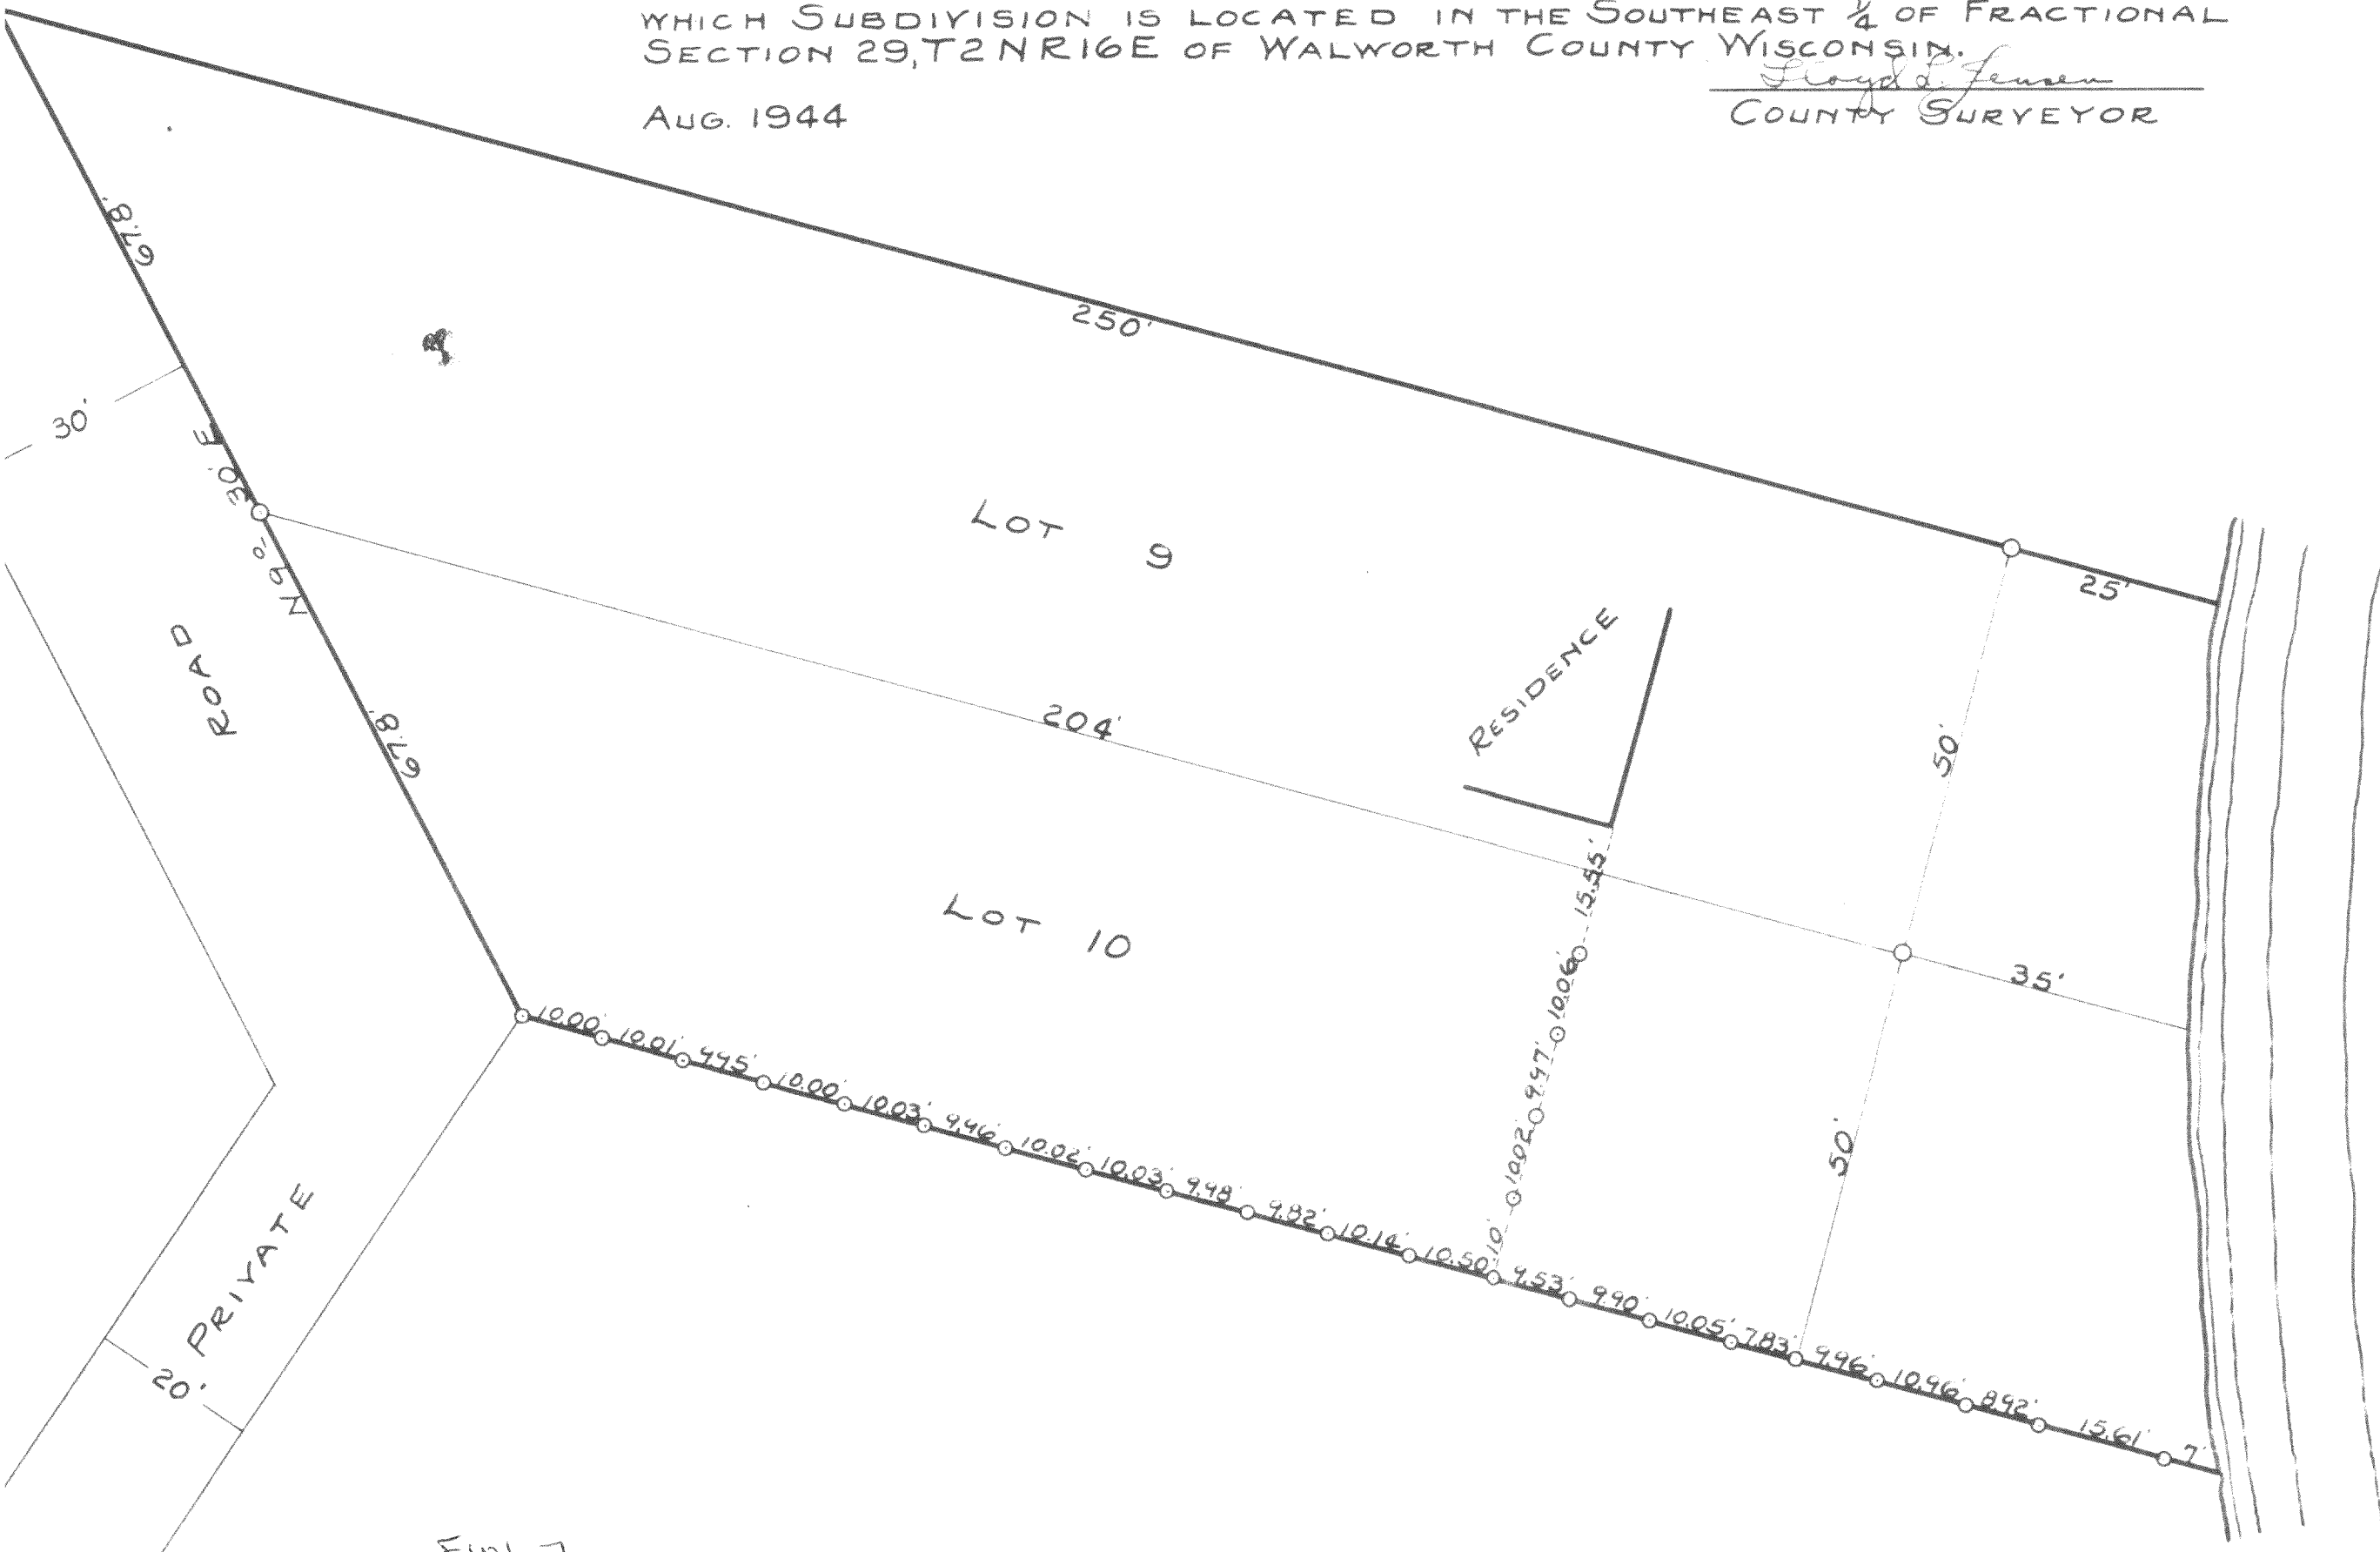

DEHAVAN LAKE

216-51.1