


PREPARE FOR:
MARY KILKENNY
KEEFE REAL ESTATE
DELAN, WI.

PLAT OF SURVEY

- OF -

LOT 20 ELKWOOD, A SUBDIVISION OF PART OF THE NE 1/4 OF THE NE 1/4 OF SECTION
13, TOWN 2 NORTH, RANGE 16 EAST, TOWN OF DELAVAN, WALWORTH COUNTY, WISCONSIN.

PATHFINDER SURVEYING INC.
(formerly)
J.K. SURVEYING INC.
P.O BOX 322
LAKE GENEVA, WI. 53147
WWW.PATHFINDERSURVEYING.NET
262-248-8303

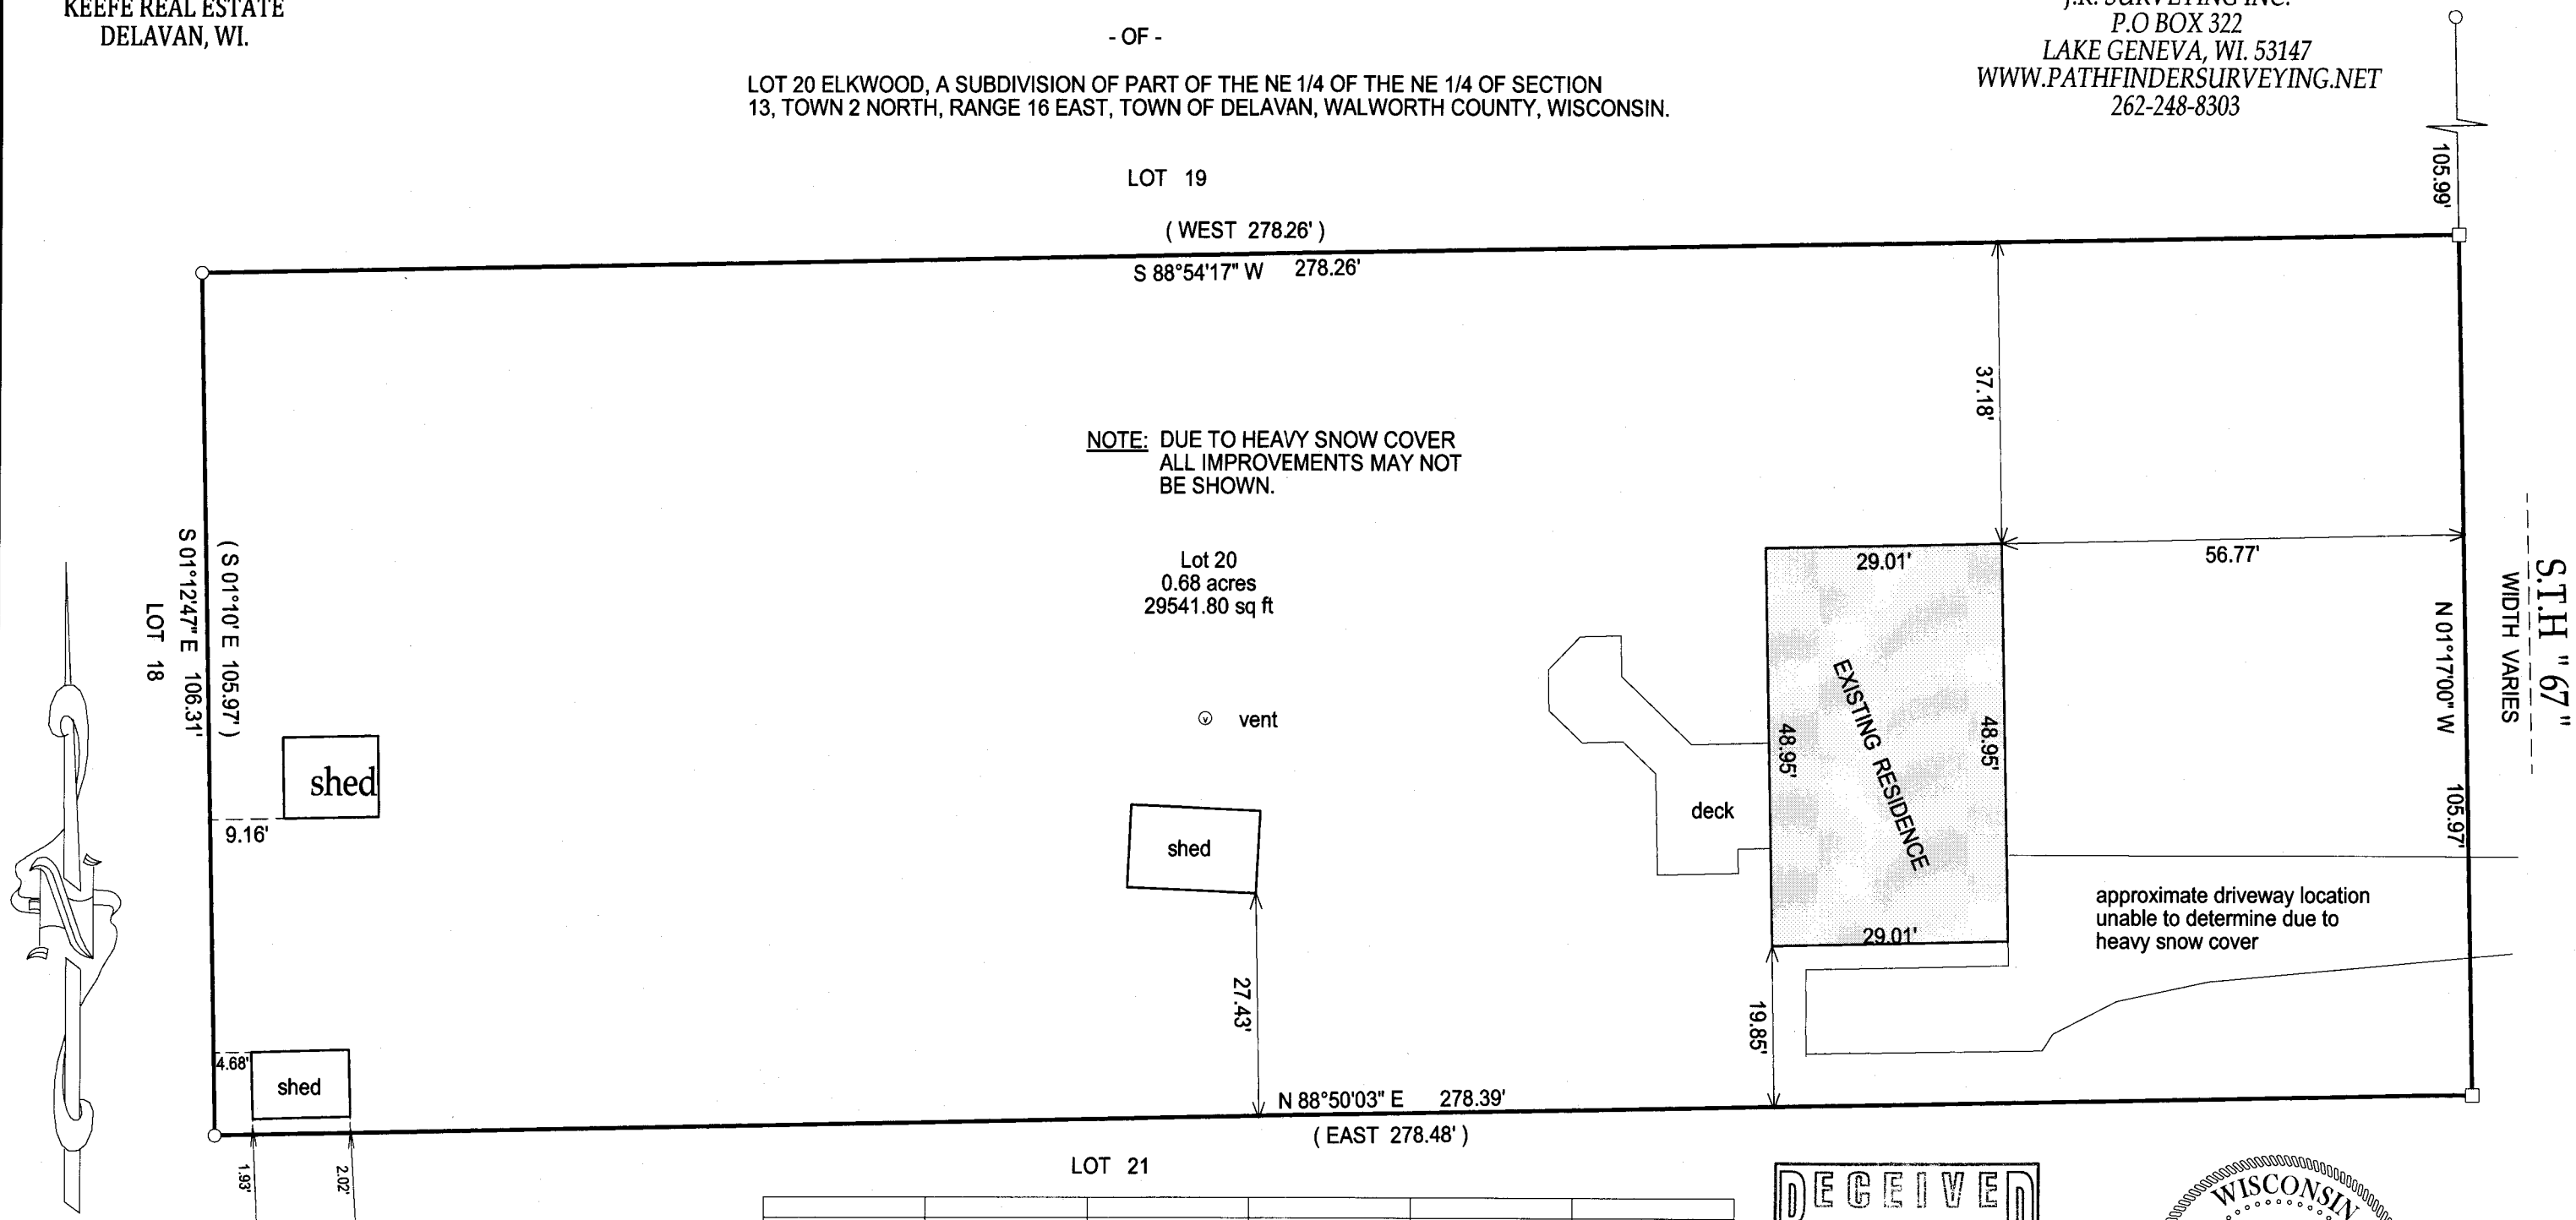


- () = recorded as
- = found iron bar
- = found iron pipe
- = set iron pipe
- = set iron bar

SCALE 1" = 20'

JOB # 13-250

TAX ID # FEW00020

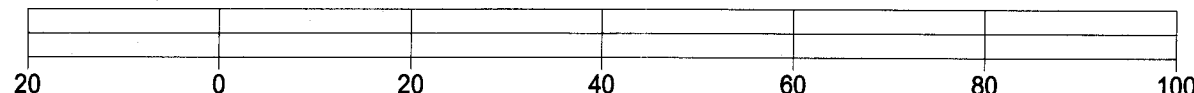


BASIS OF BEARING OF THIS PLAT: THE WEST LINE OF S.T.H. "67" WAS ASSUMED TO
BEAR N0°17' W AS SHOWN ON THE RECORD PLAT OF ELKWOOD.

"I hereby certify that I have surveyed the above described property and that the above
map is a true representation of its exterior boundary and shows the size and location of
all visible structures, apparent easements and encroachments if any."

This survey is made for the present owners of the property, and those who
purchase, mortgage, or guarantee the title thereto, within one year from
the date hereof.

DATED THIS 23rd day of December, 2013.

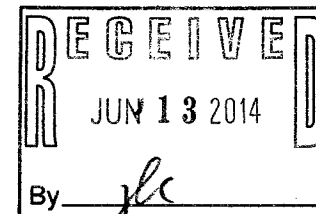

JEFFREY L. KIMPS S-2436
Wisconsin Registered Land Surveyor
(original if signed in red)

FEW -20 216-5119