



-OF-

LOT 5, LAKE GENEVA AIRE ESTATES, ACCORDING TO THE RECORDED PLAT THEREOF. SAID LAND BEING IN THE VILLAGE OF BLOOMFIELD, COUNTY OF WALWORTH AND STATE OF WISCONSIN.

LOT 5, LAKE GENEVA AIRE ESTATES, ACCORDING TO THE RECORDED PLAT THEREOF. SAID LAND BEING IN THE VILLAGE OF BLOOMFIELD, COUNTY OF WALWORTH AND STATE OF WISCONSIN.

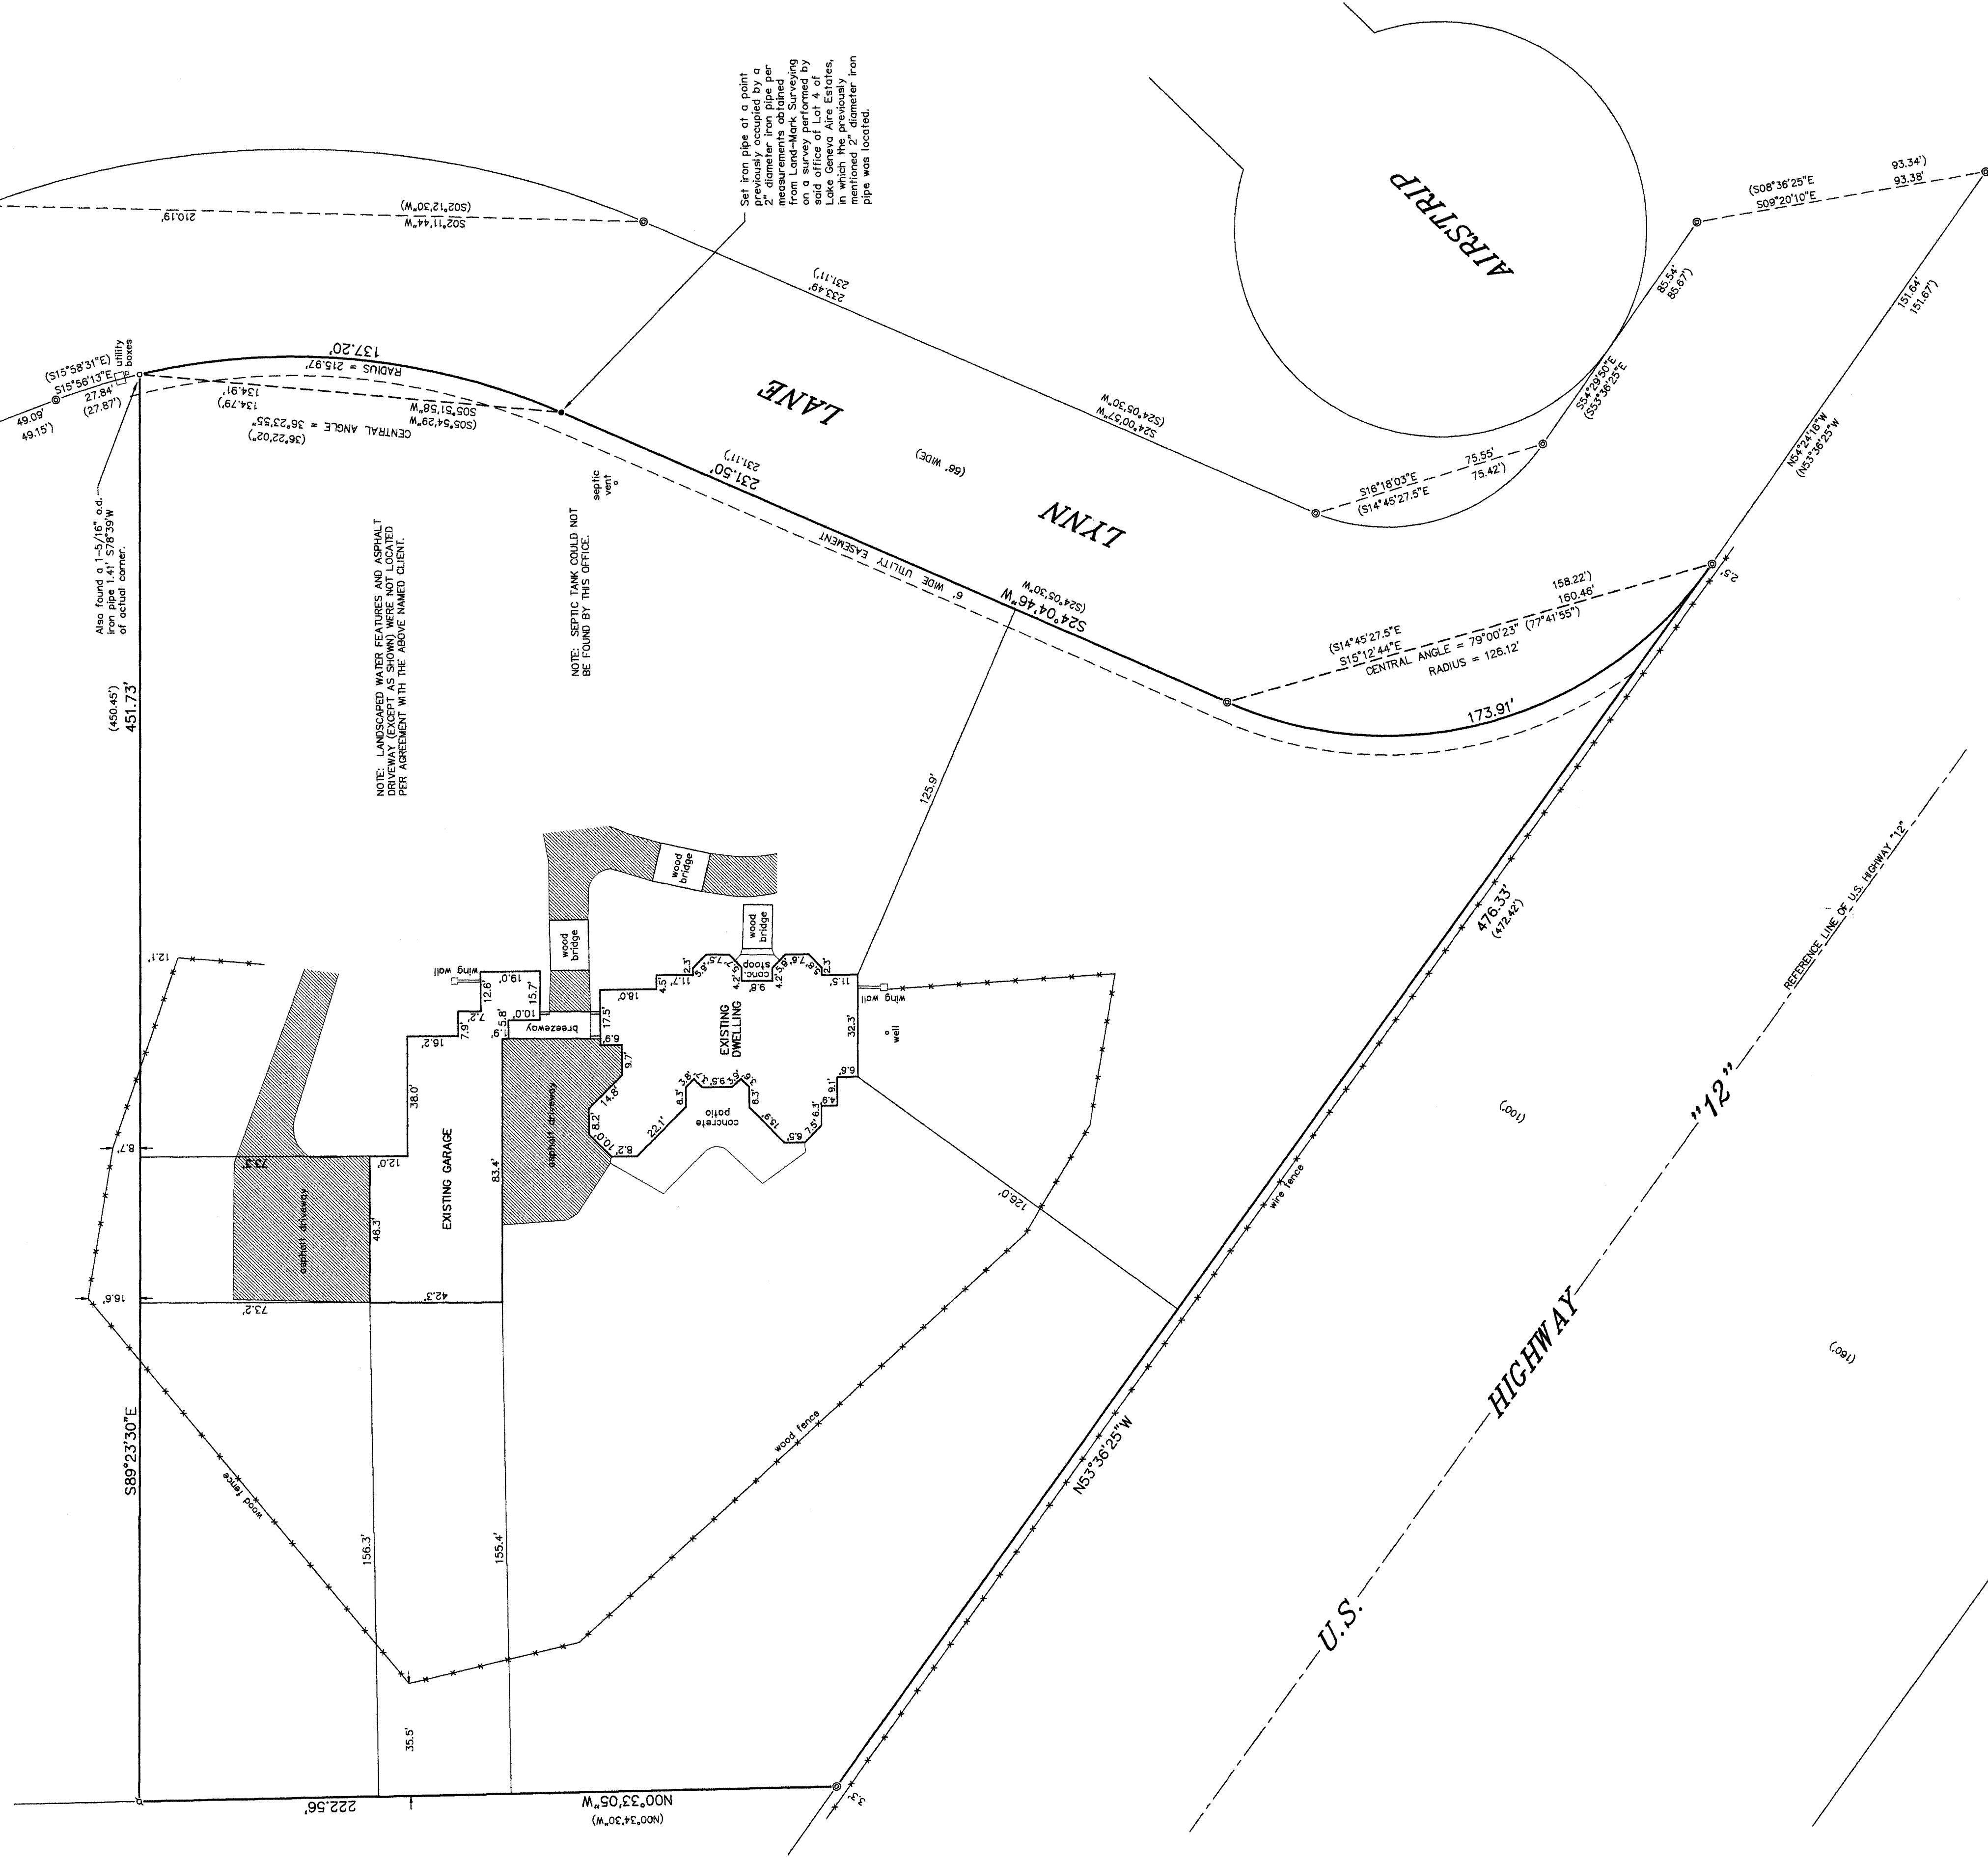

BEARINGS HEREON RELATE TO THE NORTH LINE OF LOT 5 OF LAKE GENEVA AIRE ESTATES. ASSUMED BEARING OF SOUTH 89°23'30" EAST AS PLATTED.

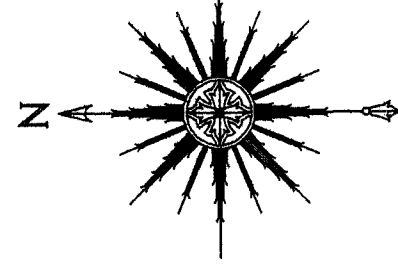

LEGEND

- ⊙ FOUND 2" I.D. OR O.D. IRON PIPE
- ⌘ FOUND 1-1/2" O.D. IRON PIPE
- FOUND 1-1/4" DIA. PINCHED PIPE
- SET 1-5/16" O.D. IRON PIPE
- () RECORDED AS

"I HEREBY CERTIFY THAT I HAVE SURVEYED THE ABOVE DESCRIBED PROPERTY AND THAT THE ABOVE MAP IS A CORRECT REPRESENTATION THEREOF AND SHOWS THE SIZE AND LOCATION OF THE PROPERTY, ITS EXTERIOR BOUNDARIES, THE LOCATION OF ALL VISIBLE STRUCTURES AND DIMENSIONS OF ALL PRINCIPAL BUILDINGS THEREON, BOUNDARY FENCES, APPARENT EASEMENTS, ROADWAYS AND ENCROACHMENTS, IF ANY."

"THIS SURVEY IS MADE FOR THE USE OF THE PRESENT OWNERS OF THE PROPERTY, AND THOSE WHO PURCHASE, MORTGAGE, OR GUARANTEE THE TITLE THERETO WITHIN ONE YEAR FROM DATE HEREOF."

THIS IS NOT AN ORIGINAL PRINT
UNLESS THIS SEAL IS RED.

Thomas L. Satter

LAND SURVEYS, MAPPING AND PLANNING

LAND SURVEYS, MAPPING AND PLANNING
272 ORIGIN STREET
BURLINGTON, WI 53105
262-661-4239

JUNE 30, 2014 061408
DATE JOB NUMBER

8LA-5

118-3179