


PREPARED FOR
STEVEN HAWS

PLAT OF SURVEY

- OF -

PATHFINDER SURVEYING INC.
(formerly)
J.K. SURVEYING INC.
P.O BOX 322
LAKE GENEVA, WI. 53147
WWW.PATHFINDERSURVEYING.NET
262-248-8303

LOT 15 OF BLOCK 1, DELMAR SUBDIVISION; A SUBDIVISION
OF PART OF GOVERNMENT LOT 3, PART OF THE SOUTHWEST 1/4
OF THE SOUTHWEST 1/4, ALL OF THE SOUTHEAST 1/4 OF THE SOUTHWEST
1/4, AND PART OF THE NORTHEAST 1/4 OF THE SOUTHWEST 1/4 OF SECTION
27, TOWNSHIP 2 NORTH, RANGE 16 EAST OF THE 4TH PRINCIPLE MERIDIAN,
WALWORTH COUNTY, WISCONSIN

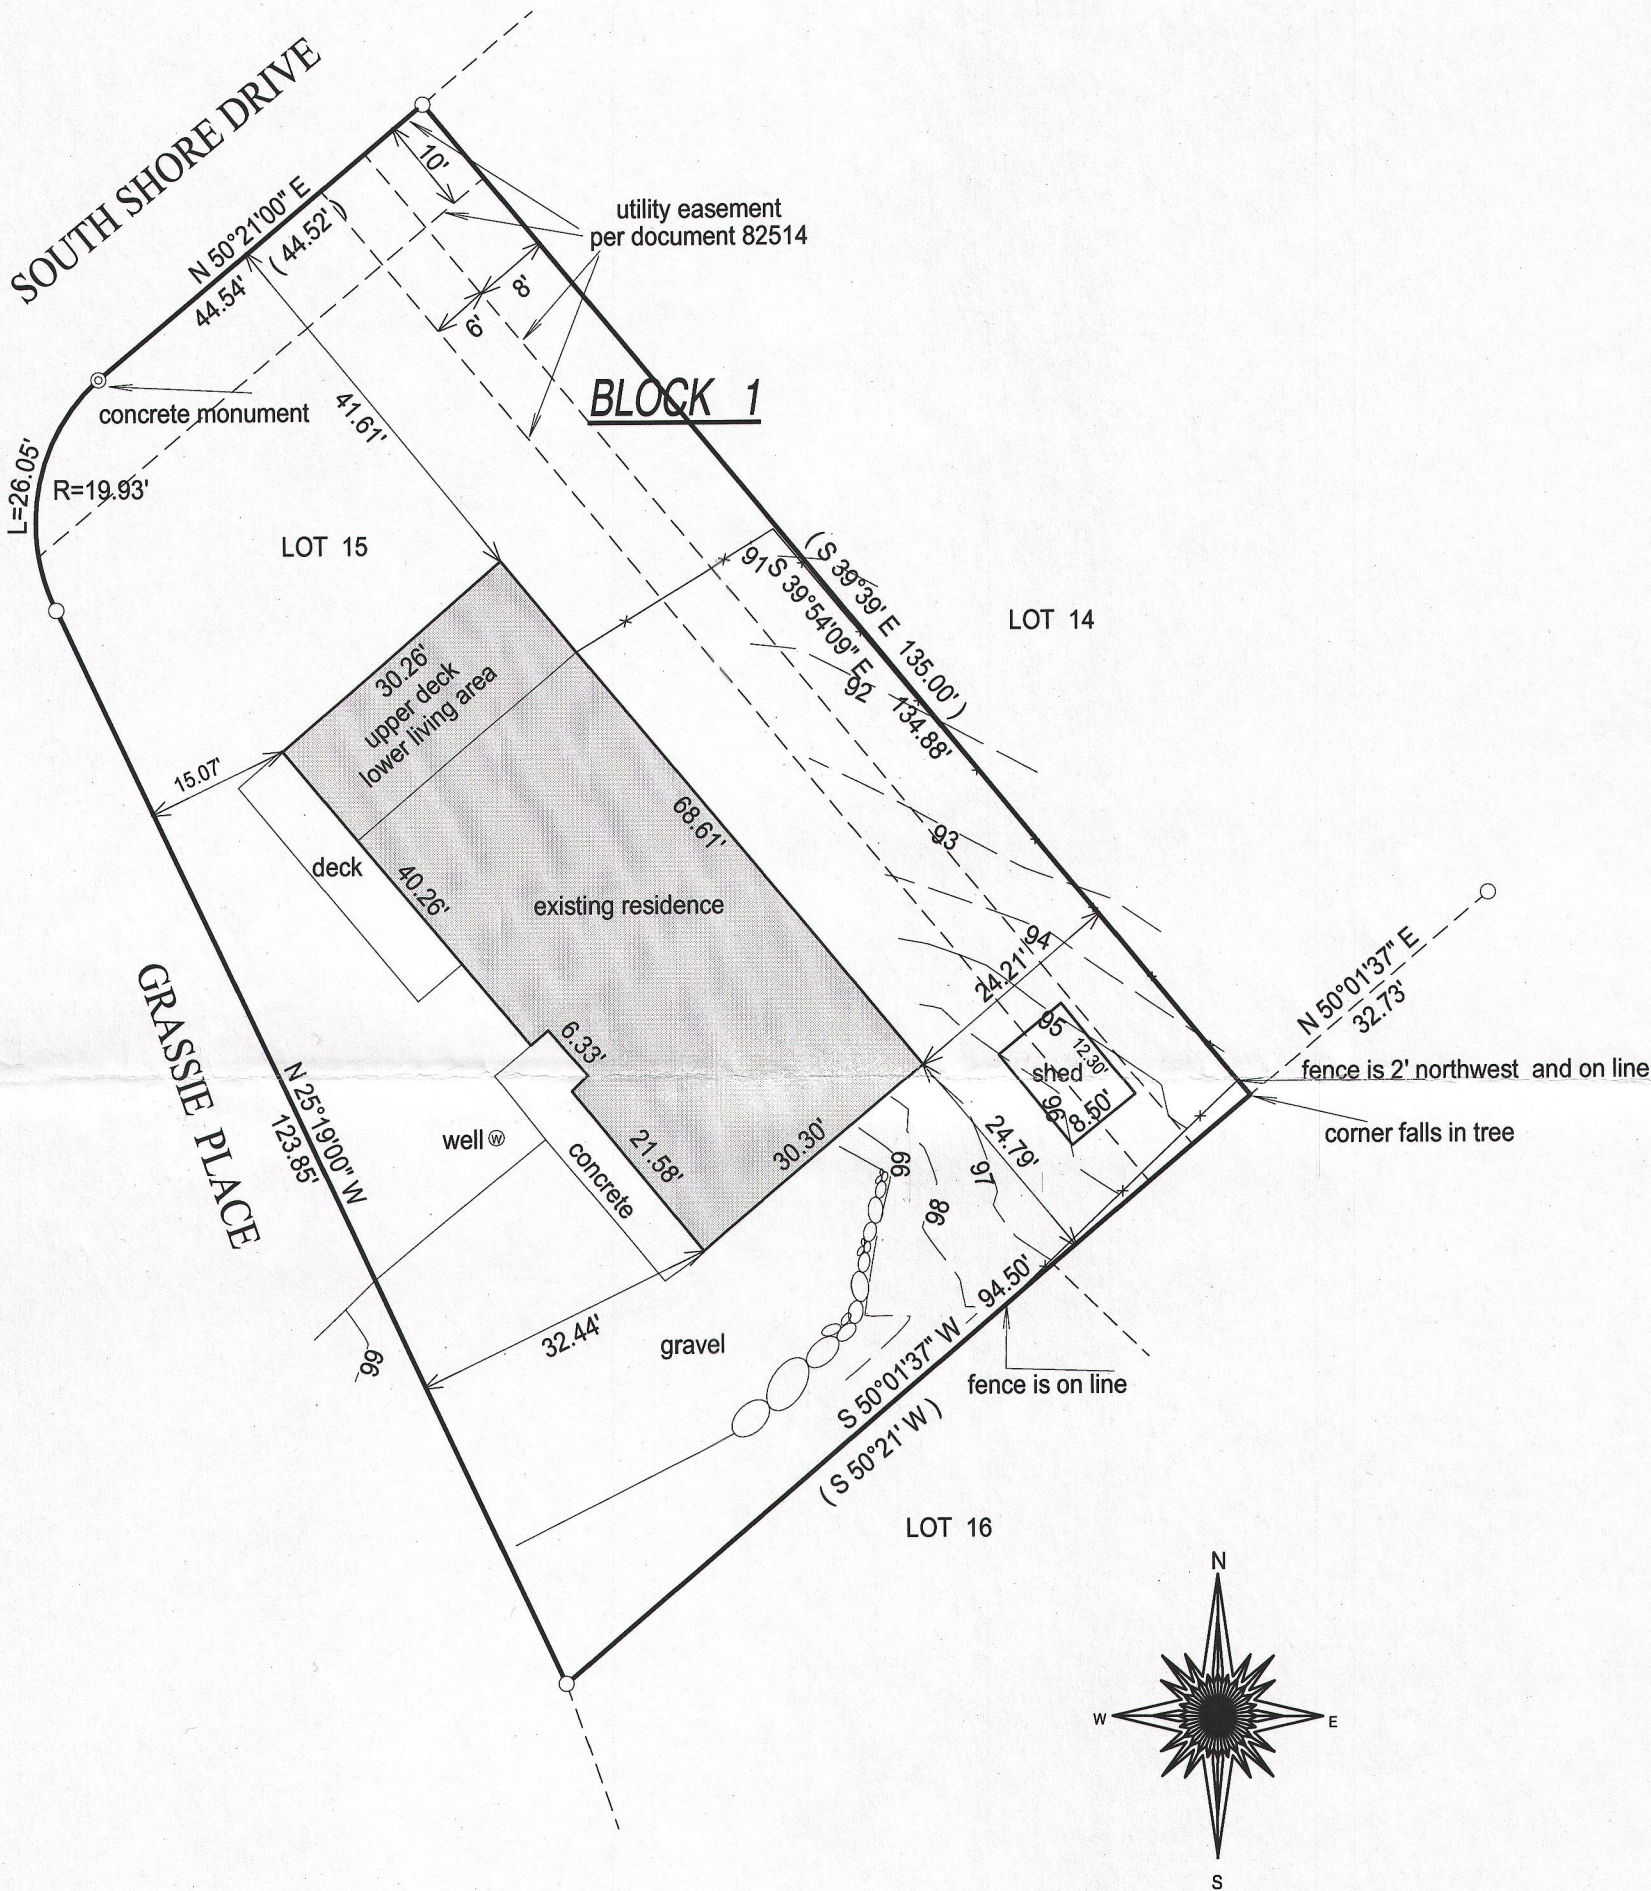


- () = recorded as
- = found iron bar
- = found iron pipe
- = set iron pipe
- = set iron bar

SCALE 1" = 20'

JOB # 14-289

TAX ID #
FDM00004A

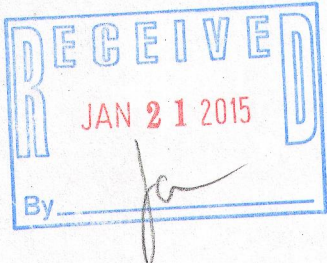


I hereby certify that I have surveyed the above- described property and the above map is a true representation thereof and shows the size and location of the property, its exterior boundaries, the location and dimensions of all structures thereon, fences, apparrant easements and roadways and visible encroachments if any.

This survey is made for the present owners of the property, and those who purchase, mortgage, or guarantee the title thereto, within one year from the date hereof.

DATED THIS 4TH DAY OF DECEMBER, 2014.

BASIS OF BEARING OF TIS PLAT: THE SOUTHERLY LINE OF SOUTH SHORE DR. WAS ASSUMED TO BEAR N50°21' E AS SHOWN ON THE RECORD PLAT.

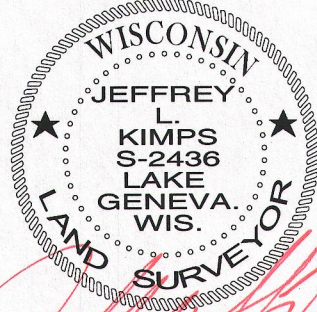

JEFFREY L. KIMPS S - 2436
Wisconsin Registered Land Surveyor
(original if signed in red)

FdM -4A

216-5163