


PREPARED FOR:
ONEIDA WHEELER
SHOREWEST REALTY
DELAVER, WI.

PLAT OF SURVEY

- OF -

LOTS 111, 112, 113, AND A PARCEL DESIGNATED AS OUTLOT, ALL IN KRUMHAA'S
SECOND ADDITION TO RAVENSWOOD, A SUBDIVISION LOCATED IN SECTION 31,
TOWN 1 NORTH, RANGE 16 EAST, WALWORTH COUNTY, WISCONSIN.


PATHFINDER SURVEYING INC.
(formerly)
J.K. SURVEYING INC.
P.O. BOX 322
LAKE GENEVA, WI. 53147
WWW.PATHFINDERSURVEYING.NET
262-248-8303

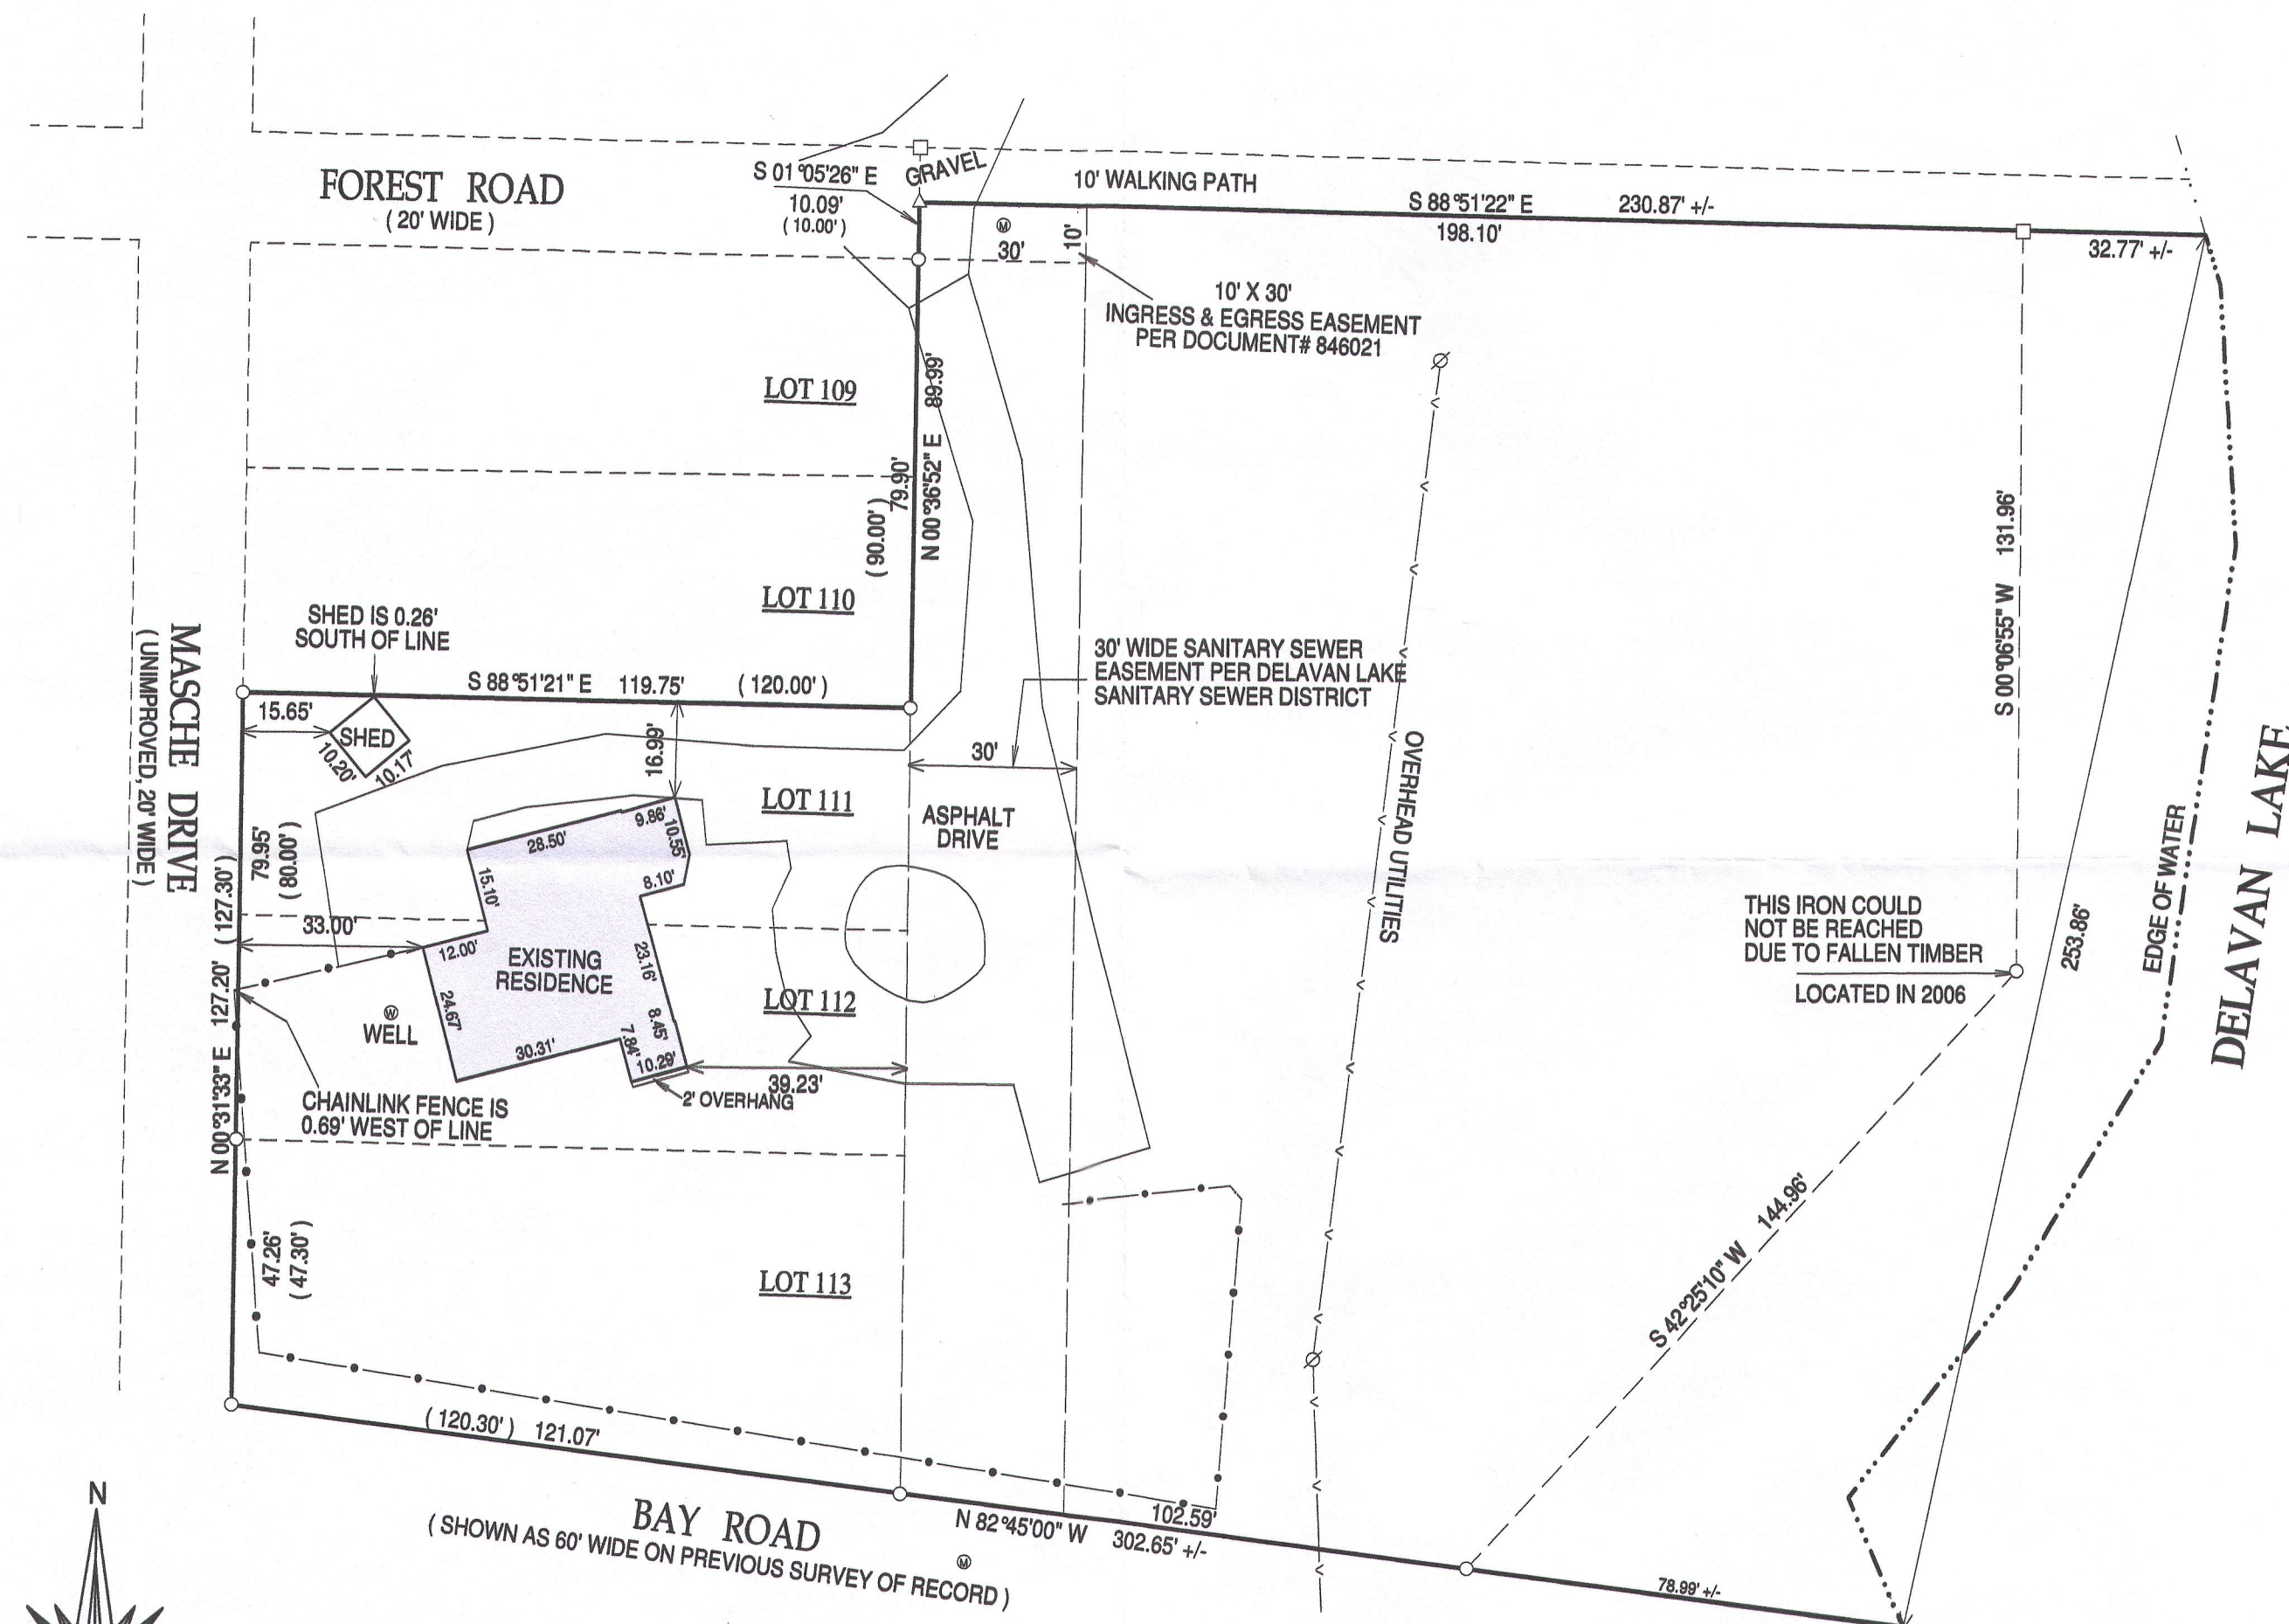

- ⊗ = manhole
 - ⊙ = power pole
 - () = recorded as
 - = found iron bar
 - = found iron pipe
 - = set iron pipe
 - = set iron bar
- SCALE: 1" = 30'

JOB #: 06-067/2014



TAX ID #: FRAZ 00009
00010
00064

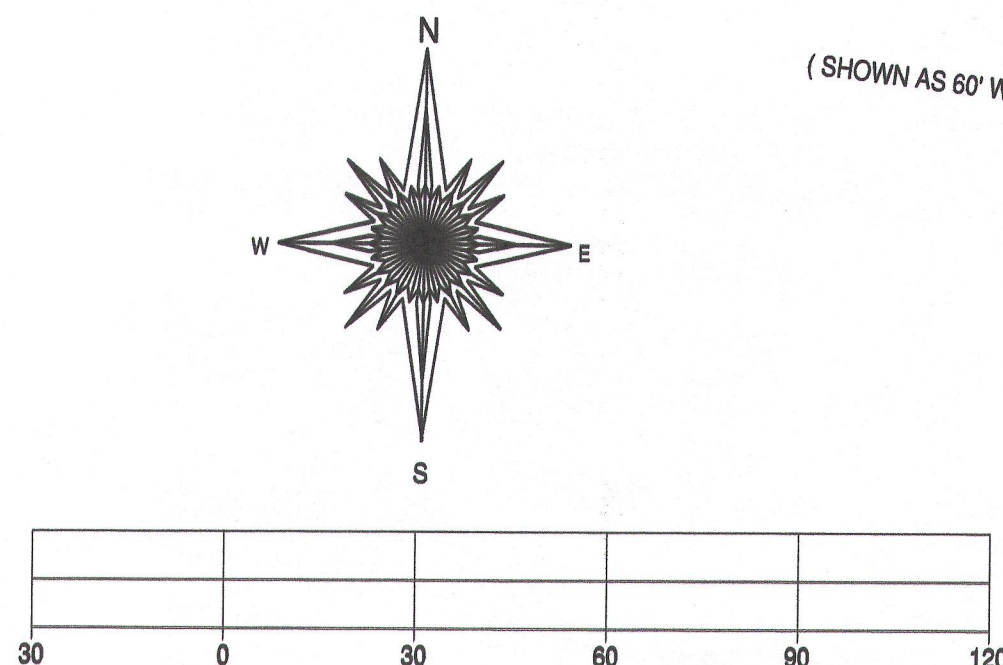

BEARINGS ARE REFERENCED TO THE NORTHERLY LINE
OF BAY ROAD RECORDED AS S 82°45' E PER RECORD PLAT.

"I hereby certify that I have surveyed the above described property and that the above map, to the best of my knowledge and belief, is a true representation thereof and shows the size and location of all visible structures, apparent easements and encroachments if any." This survey is made for the present owners of the property, and those who purchase, mortgage, or guarantee the title thereto, within one year from the date hereof.

REVISED 12/15/2014 SURVEY UPDATE

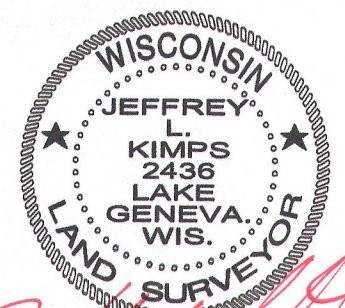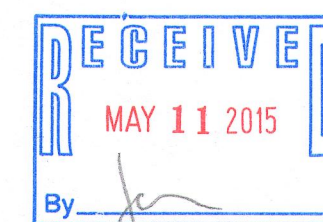

JEFFREY L. KIMPS S-2436
Wisconsin Registered Land Surveyor
(original if signed in red)

DATED THIS 8th DAY OF MARCH, 2006.

FRA2-9
FRA2-10
FRA2-64

216-5186