
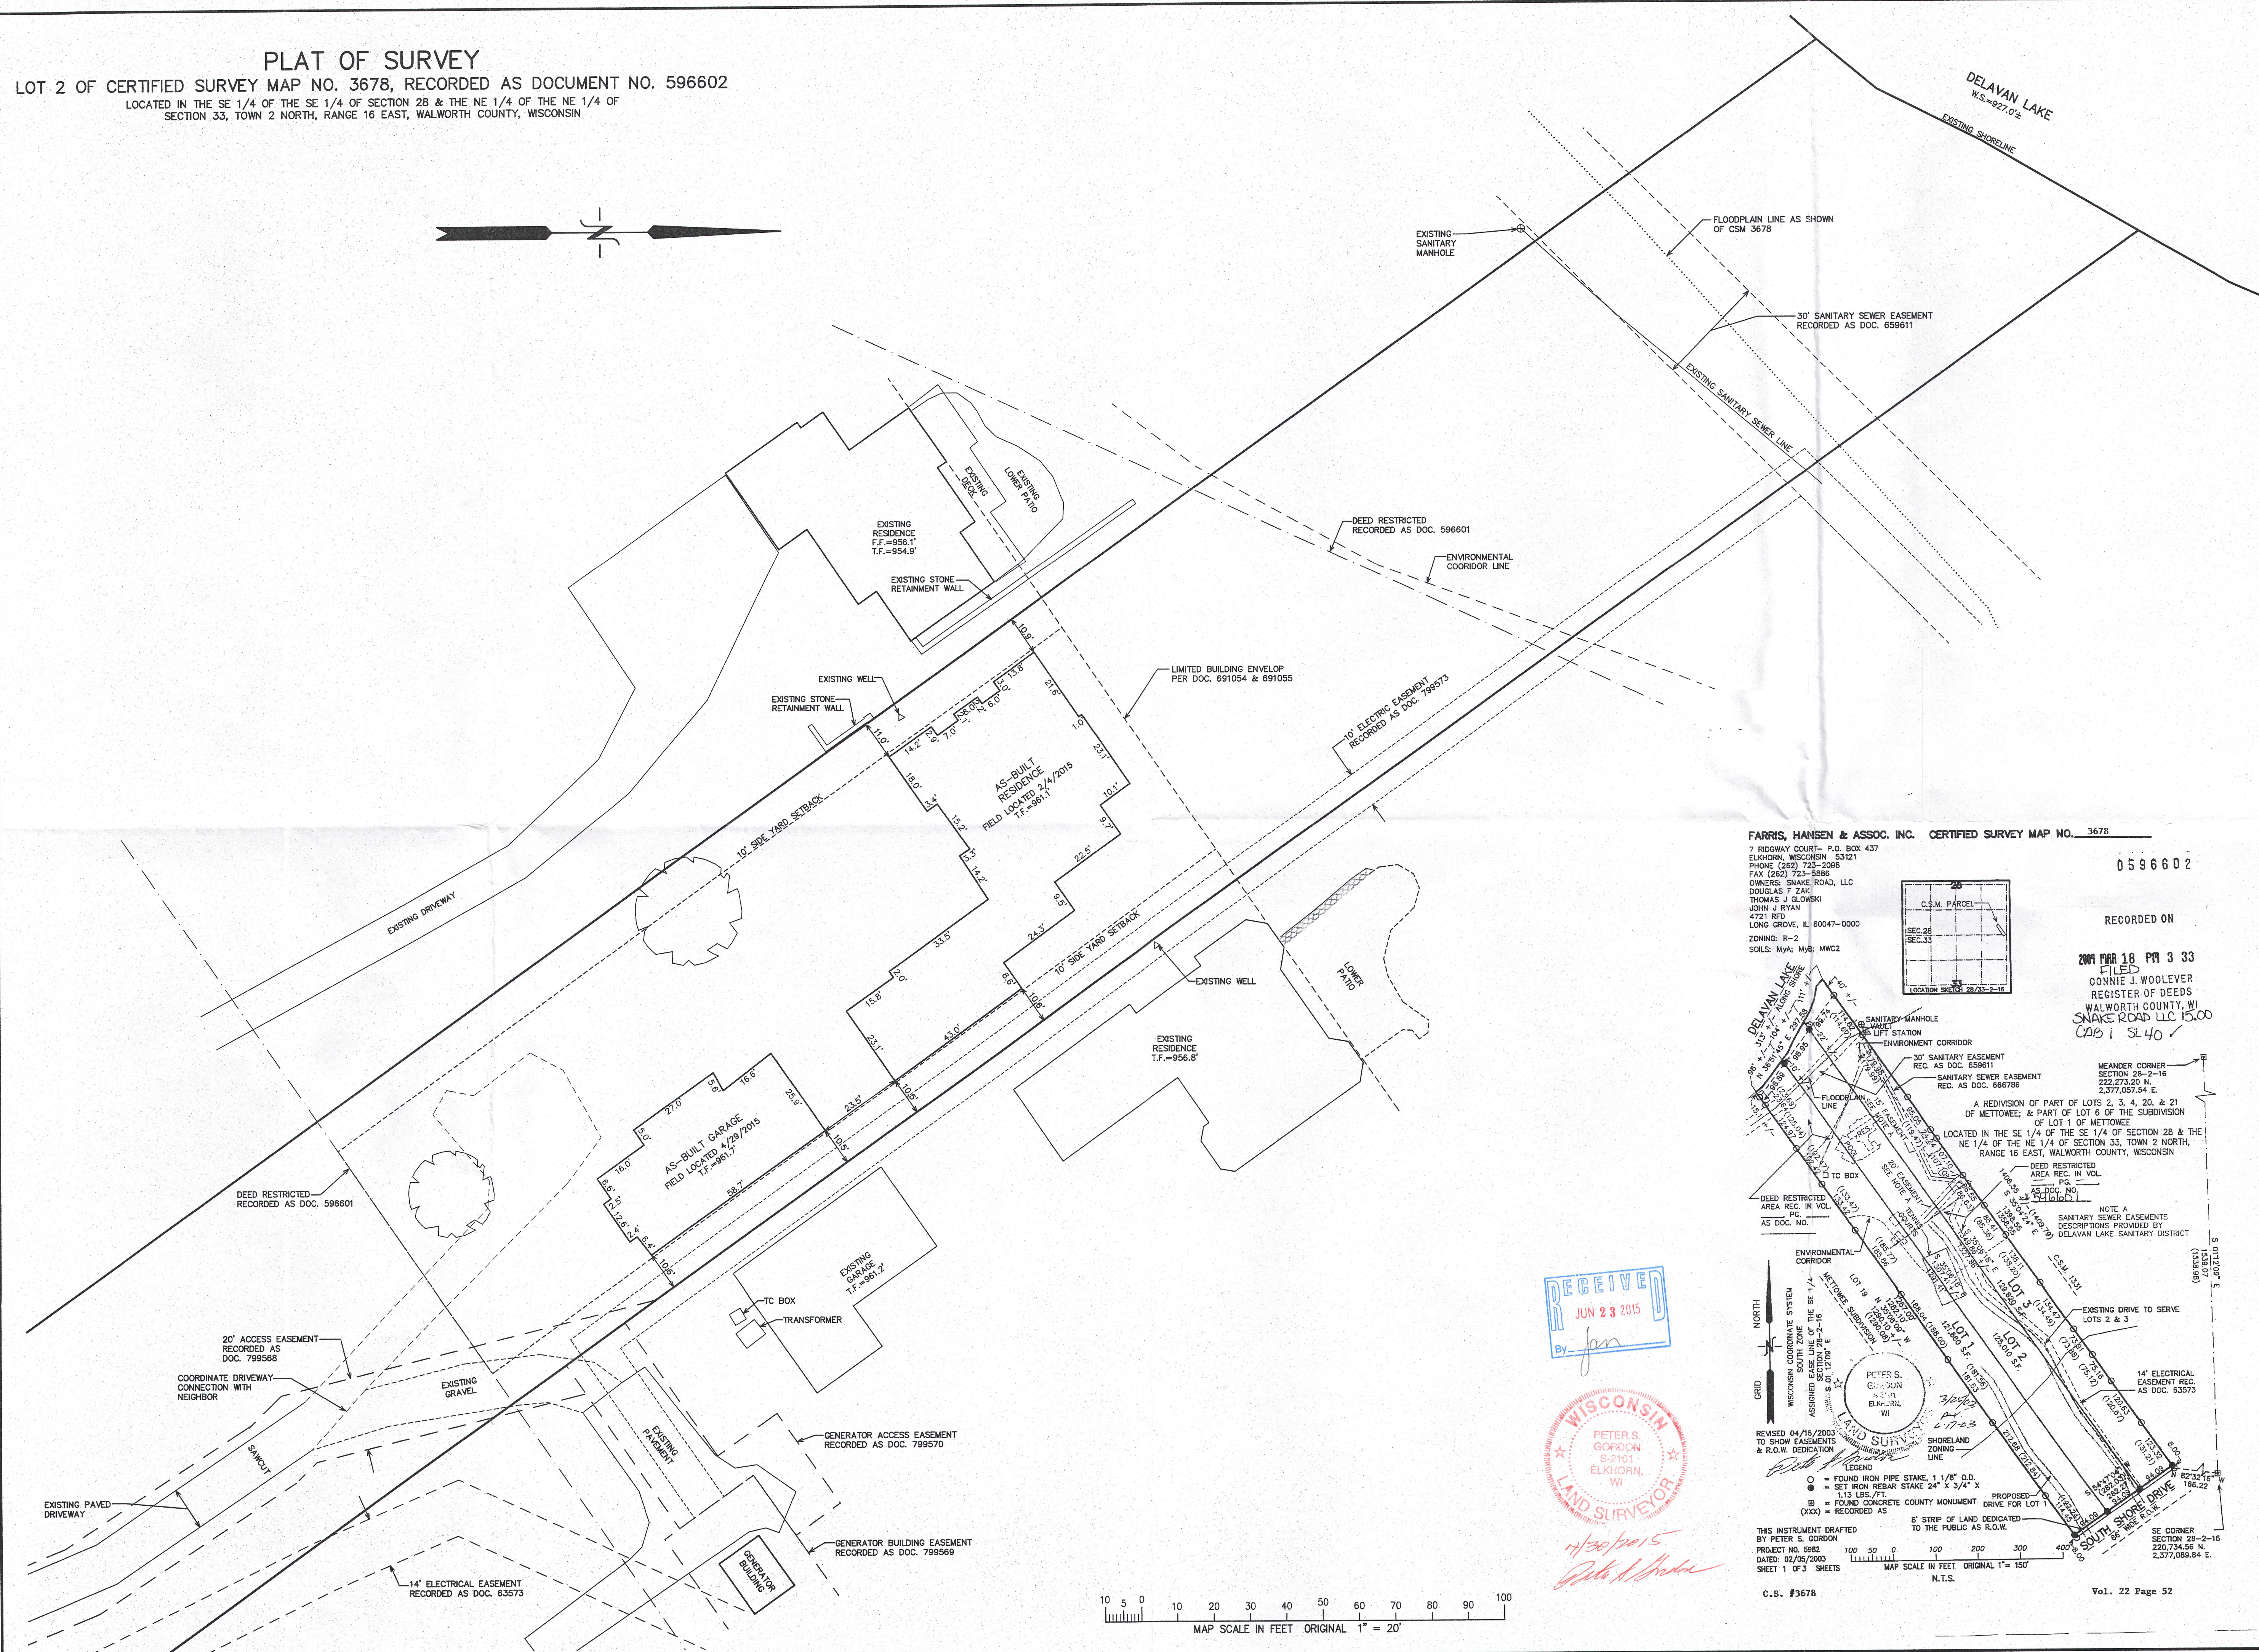


LOT 2 OF CERTIFIED SURVEY MAP NO. 3678, RECORDED AS DOCUMENT NO. 596602
LOCATED IN THE SE 1/4 OF THE SE 1/4 OF SECTION 28 & THE NE 1/4 OF THE NE 1/4 OF
SECTION 33, TOWN 2 NORTH, RANGE 16 EAST, WALWORTH COUNTY, WISCONSIN

LOCATED IN THE SE 1/4 OF THE SE 1/4 OF SECTION 28 & THE NE 1/4 OF THE NE 1/4 OF SECTION 33, TOWN 2 NORTH, RANGE 16 EAST, WALWORTH COUNTY, WISCONSIN

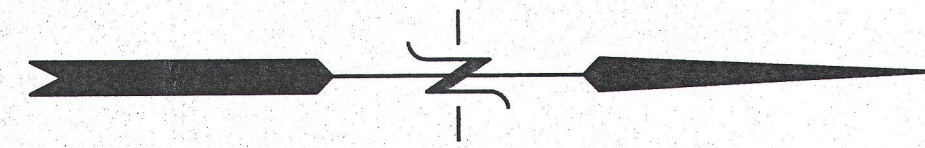

FARRIS, HANSEN & ASSOC. INC. CERTIFIED SURVEY MAP NO. 3678

7 RIDGWAY COURT— P.O. BOX
ELKHORN, WISCONSIN 53121
PHONE (262) 723-2098
FAX (262) 723-5886
OWNERS: SNAKE ROAD, LLC
DOUGLAS F ZAK
THOMAS J GLOWSKI
JOHN J RYAN
4721 RFD
LONG GROVE, IL 60047-0000
ZONING: R-2
SOILS: MyA; MyB; MWC2

0596602

RECORDED ON

2004 MAR 18 PM 3 33
FILED
CONNIE J. WOOLEVER
REGISTER OF DEEDS
WALWORTH COUNTY, WI
SNAKE ROAD LLC 15.00
CAB 1 SL40 ✓

MEANDER CORNER
SECTION 28-2-16
222,273.20 N.
2,377,057.54 E.

NOTE A
SANITARY SEWER EASEMENTS
DESCRIPTIONS PROVIDED BY
DE LA VAN LAKE SANITARY DISTRICT

EXISTING DRIVE TO SERVE
LOTS 2 & 3

14' ELECTRICAL

EASEMENT REC.
AS DOC. 63573

123.35
(131.35) 8.00

[illegible]

SECTION 28-2-10
220,734.56 N.
2,377,089.84 E.

Vol. 22 Page 52

FA 3678-2 216-5204

APR 30 2013

4/30/2015 X:\Projects\5982\ASBUILT_LOT2

RECEIVED
JUN 23 2015
By Jan

17/30/2015
Dette A. Gordon

— WORK ORDERED BY —
JORNDT BUILDERS, INC.
168 ELKHORN ROAD
WILLIAMS BAY, WI 53191

FARRIS, HANSEN & ASSOCIATES, INC.
ENGINEERING — ARCHITECTURE — SURVEYING
7 RIDGWAY COURT P.O. BOX 437
ELKHORN, WISCONSIN 53121

REVISIONS
4/7/2015-KB ADJUST PROPOSED GARAGE & DRIVE
4/30/2015-KB TO SHOW SIZE & L OF AS-BUILT GAR & RESIDENCE

PROJECT NO.	5982.02
DATE	11/19/201
SHEET NO.	1 OF 1