


PLAT OF SURVEY -OF-

LOTS 31 AND 32 IN KRUMHAAR'S ADDITION TO RAVENSWOOD, ACCORDING TO THE RECORDED PLAT THEREOF. SAID LAND BEING IN THE TOWN OF DELAVAN, COUNTY OF WALWORTH AND STATE OF WISCONSIN.



SURVEY FOR: SHIRLEY COULMAN OF KEEFE REAL ESTATE
SURVEY ADDRESS: 4225 MAPLE DRIVE, DELAVAN, WI 53115

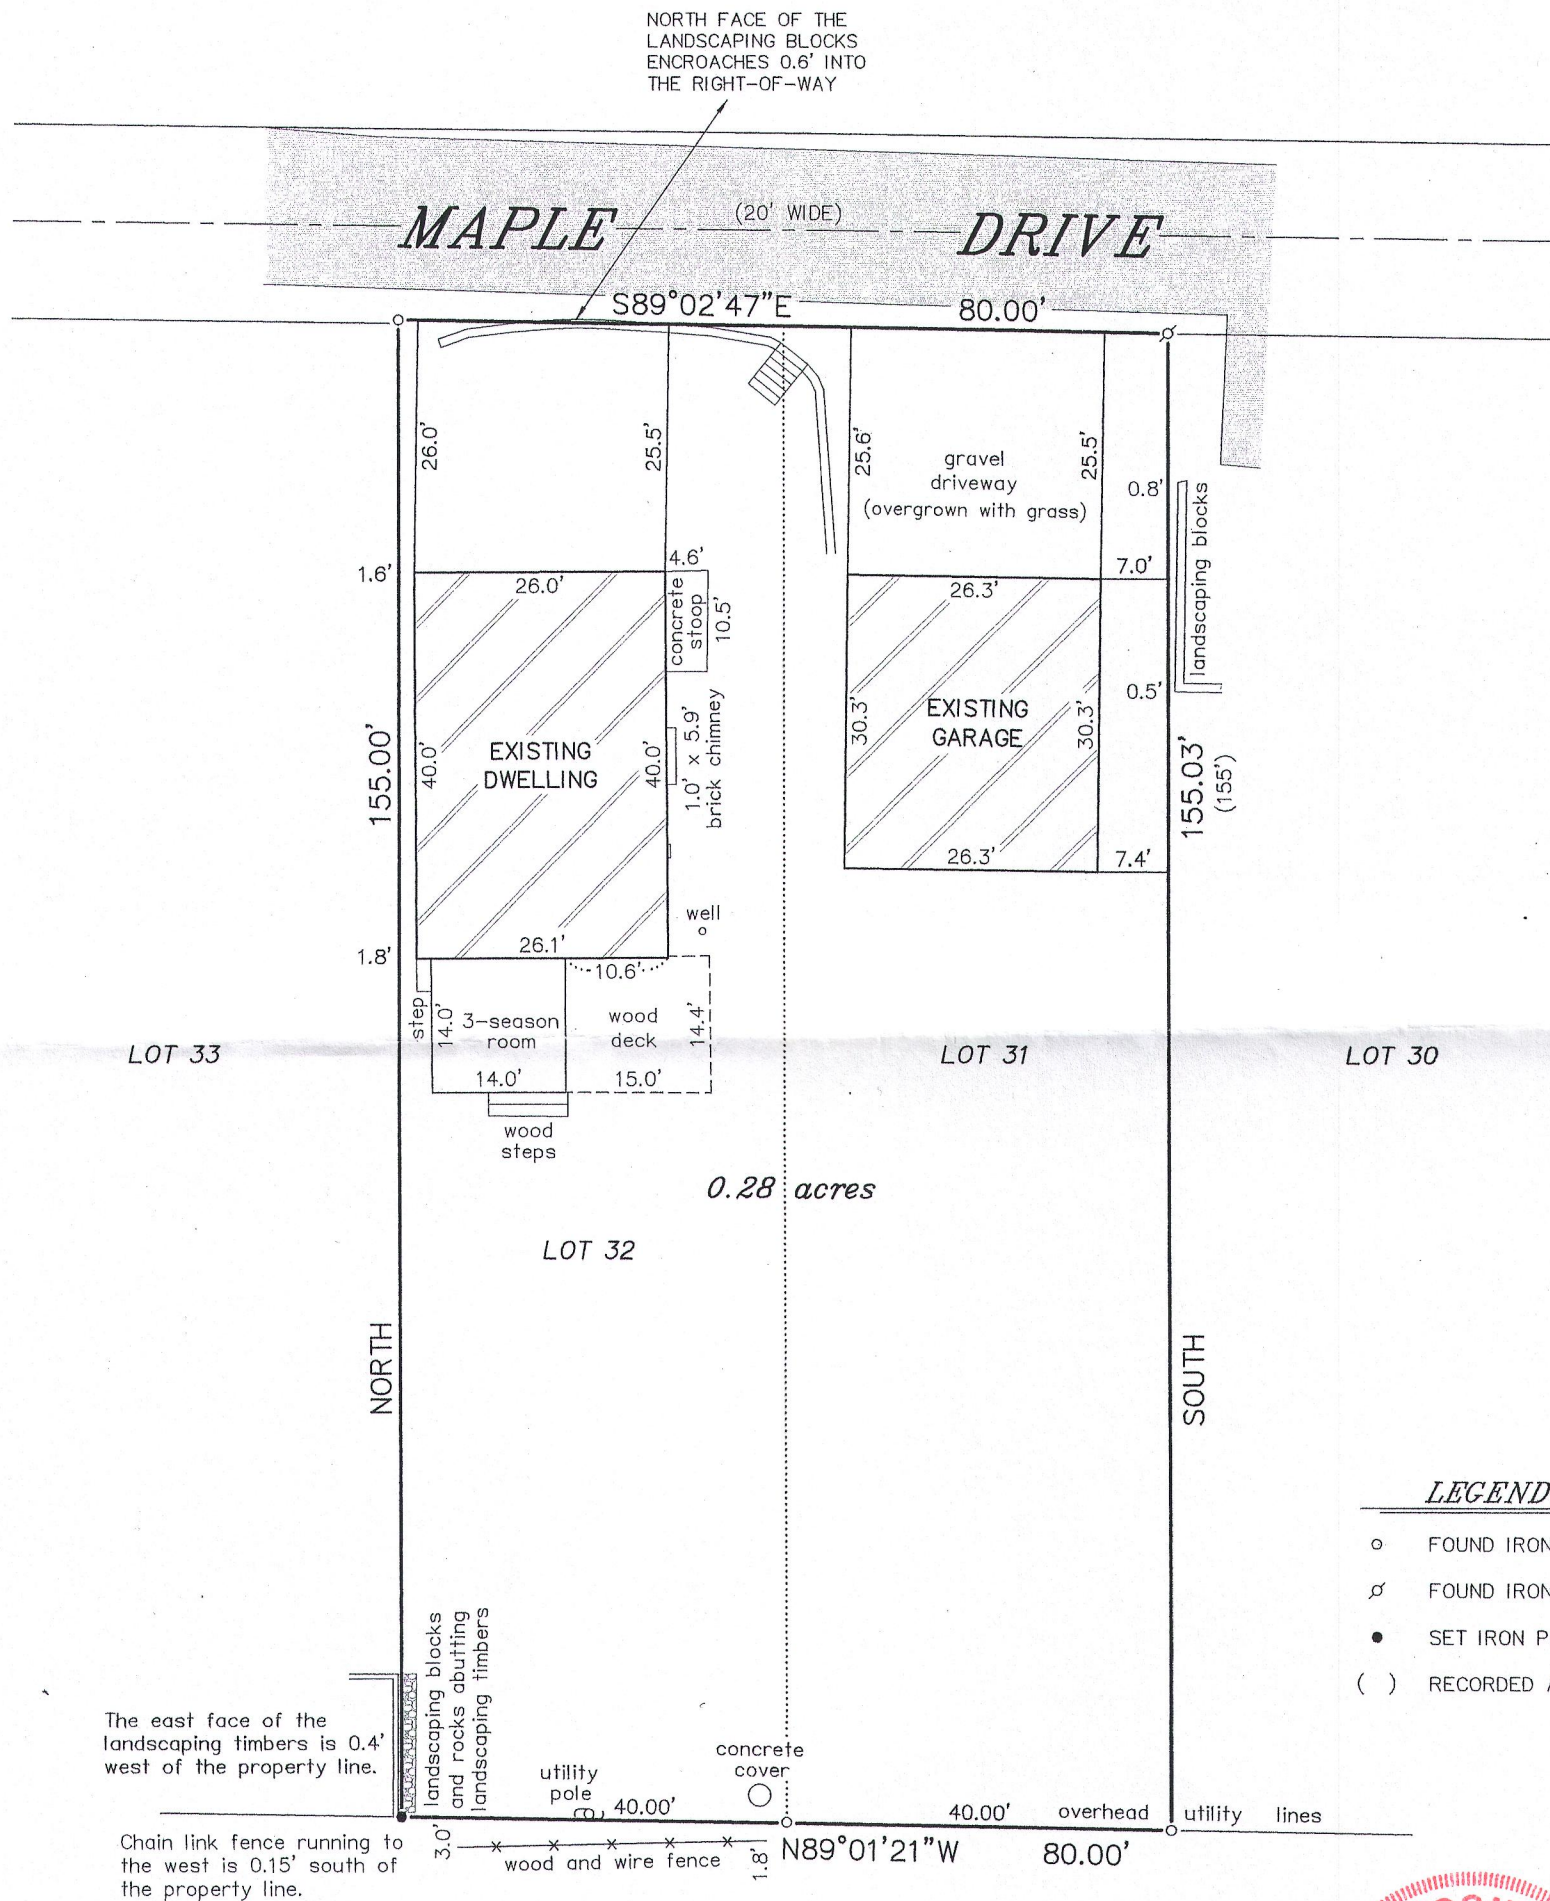

LEGEND

- FOUND IRON PIPE
- ⊘ FOUND IRON ROD
- SET IRON PIPE
- () RECORDED AS

BEARINGS HEREON RELATE TO THE EAST LINE OF LOT 31 OF KRUMHAAR'S ADDITION TO RAVENSWOOD. ASSUMED BEARING OF SOUTH.

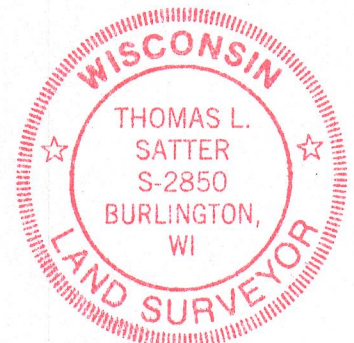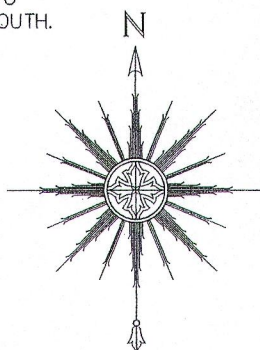

THIS IS NOT AN ORIGINAL PRINT
UNLESS THIS SEAL IS RED.

Thomas L. Satter
THOMAS L. SATTER S-2850

SATTER SURVEYING, LLC
LAND SURVEYS, MAPPING AND PLANNING
272 ORIGIN STREET
BURLINGTON, WI 53105
262-661-4239

0 10' 20' 40'
SCALE: 1" = 20'

SEPTEMBER 4, 2015
DATE

081512
JOB NUMBER

FRA-28 216-5226