



PREPARED FOR:
BRUCE KAMP

PLAT OF SURVEY


- OF -

PATHFINDER SURVEYING INC.
(formerly)
J.K. SURVEYING INC.
P.O. BOX 322
LAKE GENEVA, WI.
262-248-8303

LOT 19 OF WOODLAND SHORES SUBDIVISION, LOCATED IN TOWN 2
NORTH, RANGE 16 EAST OF THE FOURTH PRINCIPAL MERIDIAN, TOWN
OF DELAVAN, COUNTY OF WALWORTH COUNTY, STATE OF WISCONSIN

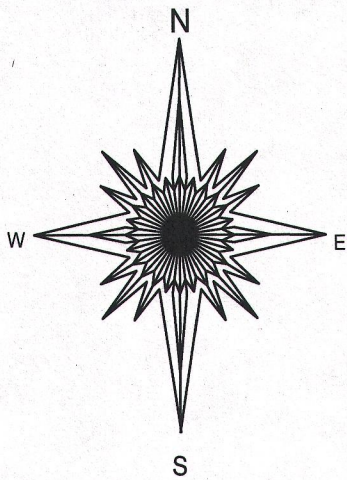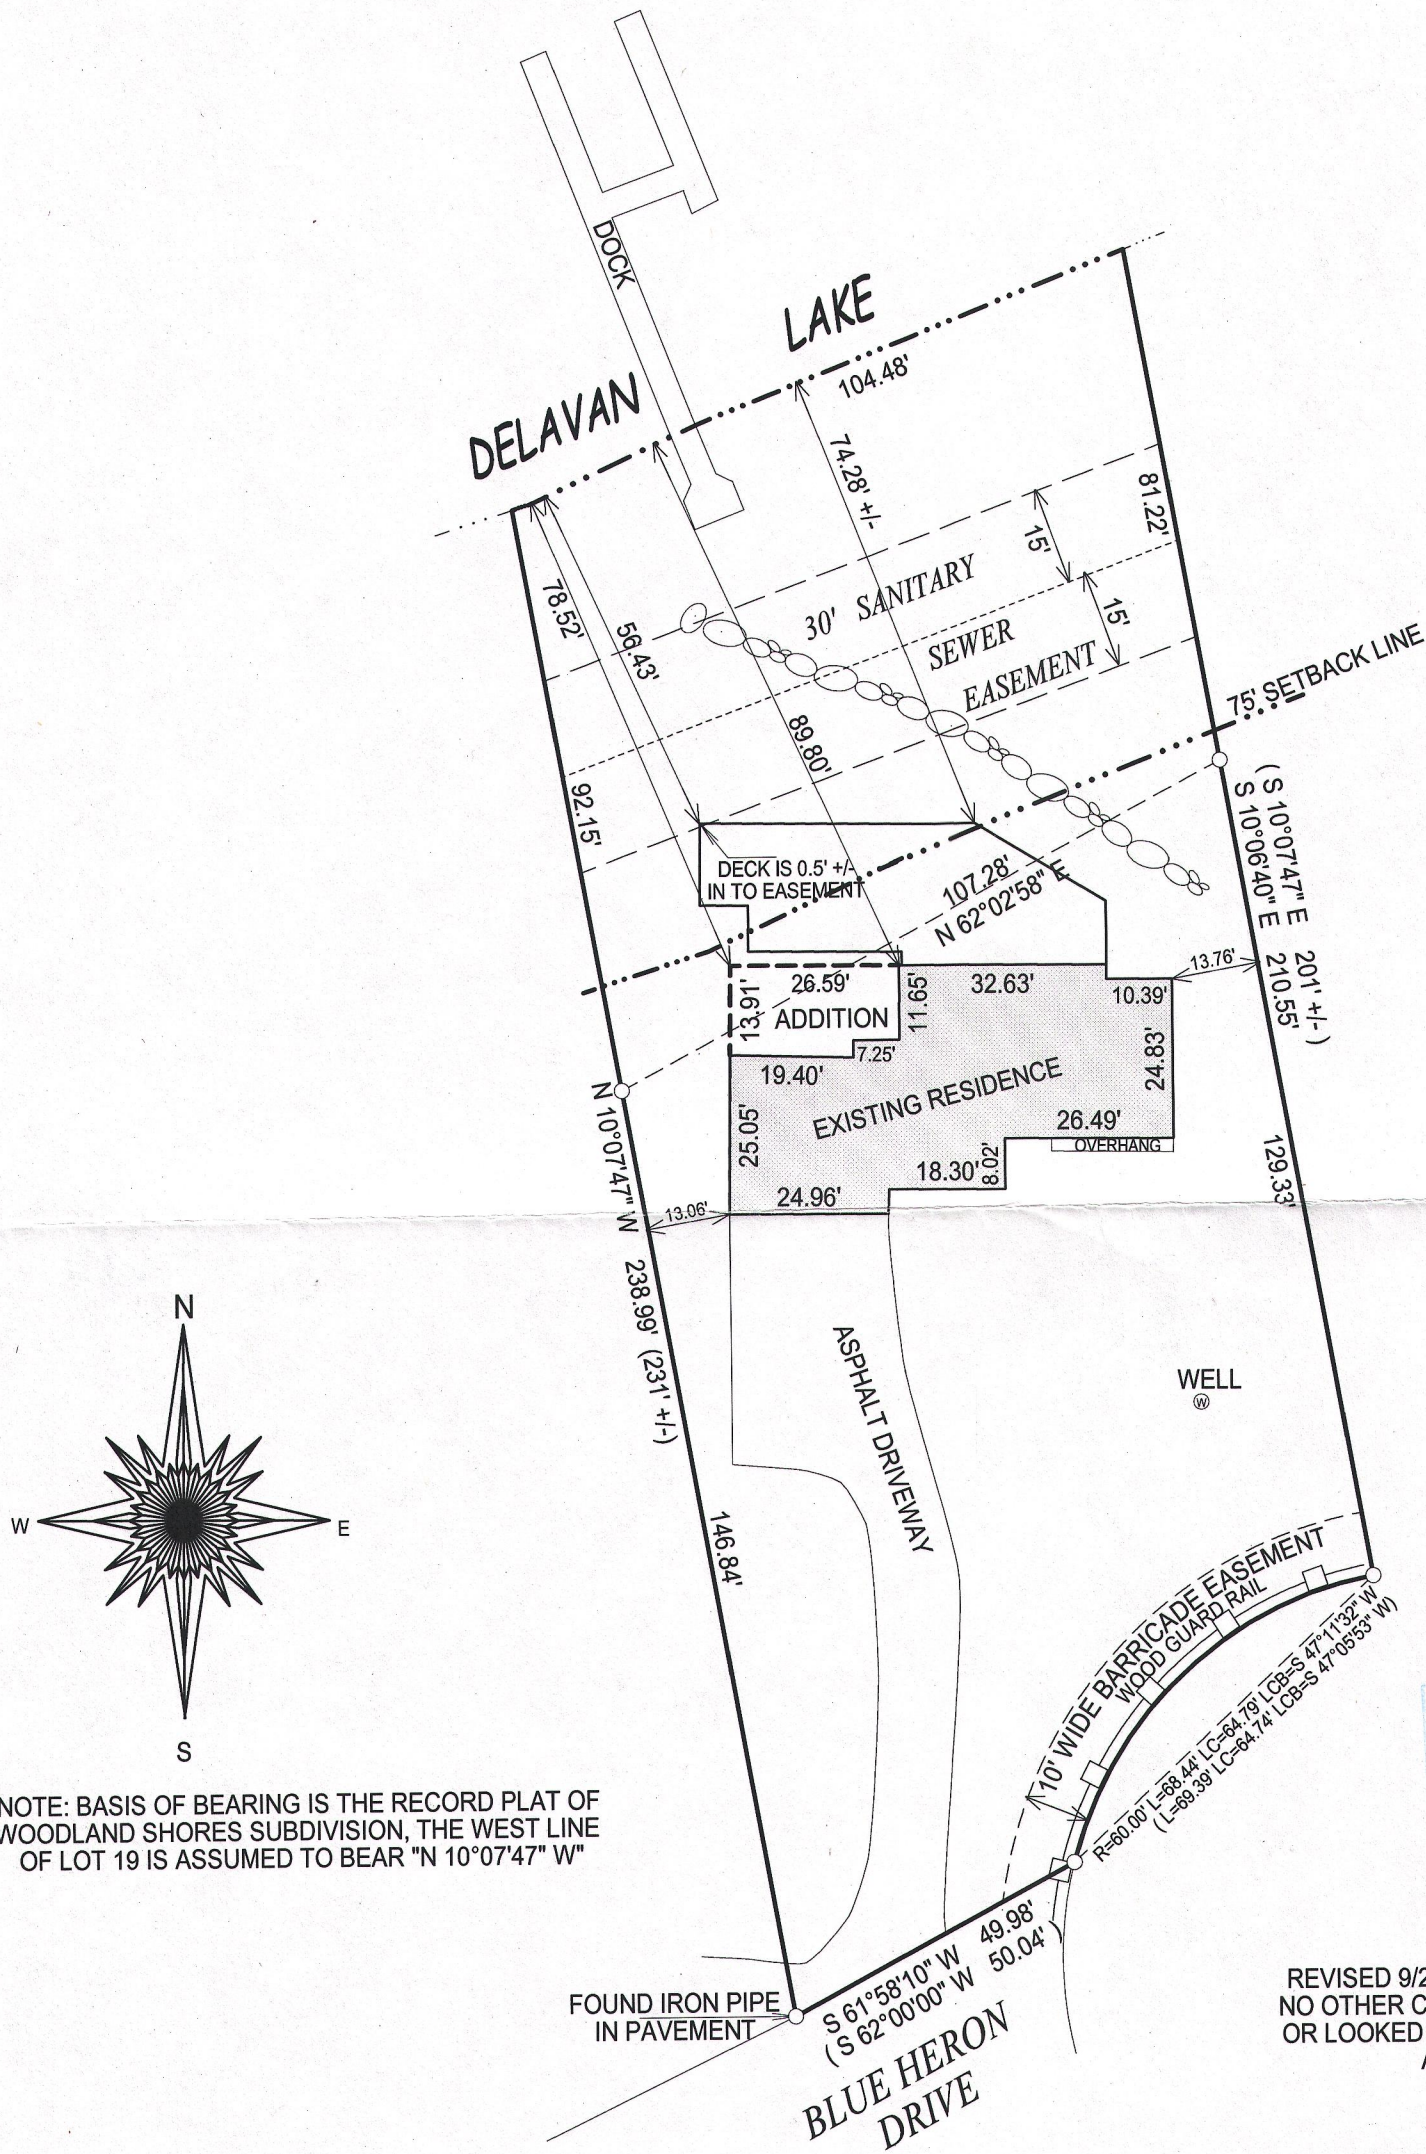


NOTE: BASIS OF BEARING IS THE RECORD PLAT OF
WOODLAND SHORES SUBDIVISION, THE WEST LINE
OF LOT 19 IS ASSUMED TO BEAR "N 10°07'47" W"

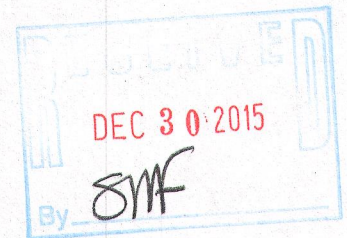

REVISED 9/21/2015 ADDITION AS BUILT
NO OTHER CHANGES WERE OBSERVED
OR LOOKED FOR, THIS IS AN ADDITION
AS BUILT ONLY

- () = recorded as
- = found iron bar
- = found iron pipe
- = set iron pipe
- = set iron bar

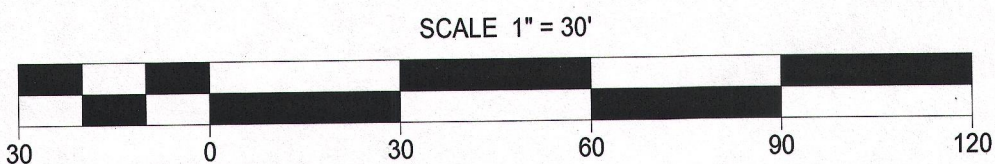


"I hereby certify that I have surveyed the above described property and that the above
map is a true representation of its exterior boundary and shows the size and location of
all visible structures, apparent easements and encroachments if any."

This survey is made for the present owners of the property, and those who
purchase, mortgage, or guarantee the title thereto, within one year from
the date hereof.

JOB # 10-175

TAX ID # FWLS 00019

DATED THIS 7th, DAY OF DECEMBER, 2010.

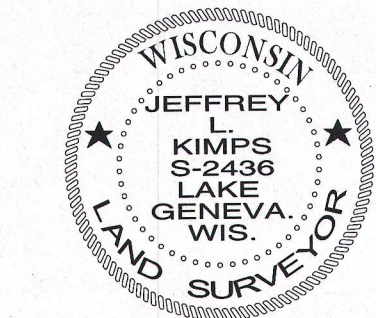

JEFFREY L. KIMPS S - 2436
Wisconsin Registered Land Surveyor
(original if signed in red)