
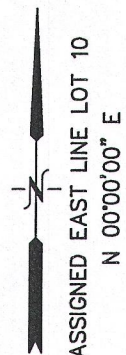
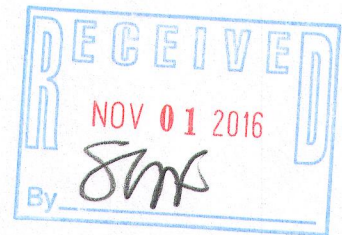


FARRIS, HANSEN & ASSOC. INC.

7 RIDGWAY COURT- P.O. BOX 437
ELKHORN, WISCONSIN 53121
PHONE (262) 723-2098
FAX (262) 723-5886


PLAT OF SURVEY
LOT 10 OF BLOCK 14 OF INLET OAKS SUBDIVISION NO. 5
LOCATED IN THE SE 1/4 SECTION 15, TOWN 2 NORTH, RANGE 16 EAST
WALWORTH COUNTY, WISCONSIN

ORDERED BY: JASON DOWNING
528 VALENCIA DRIVE
DELAVER, WI. 53115

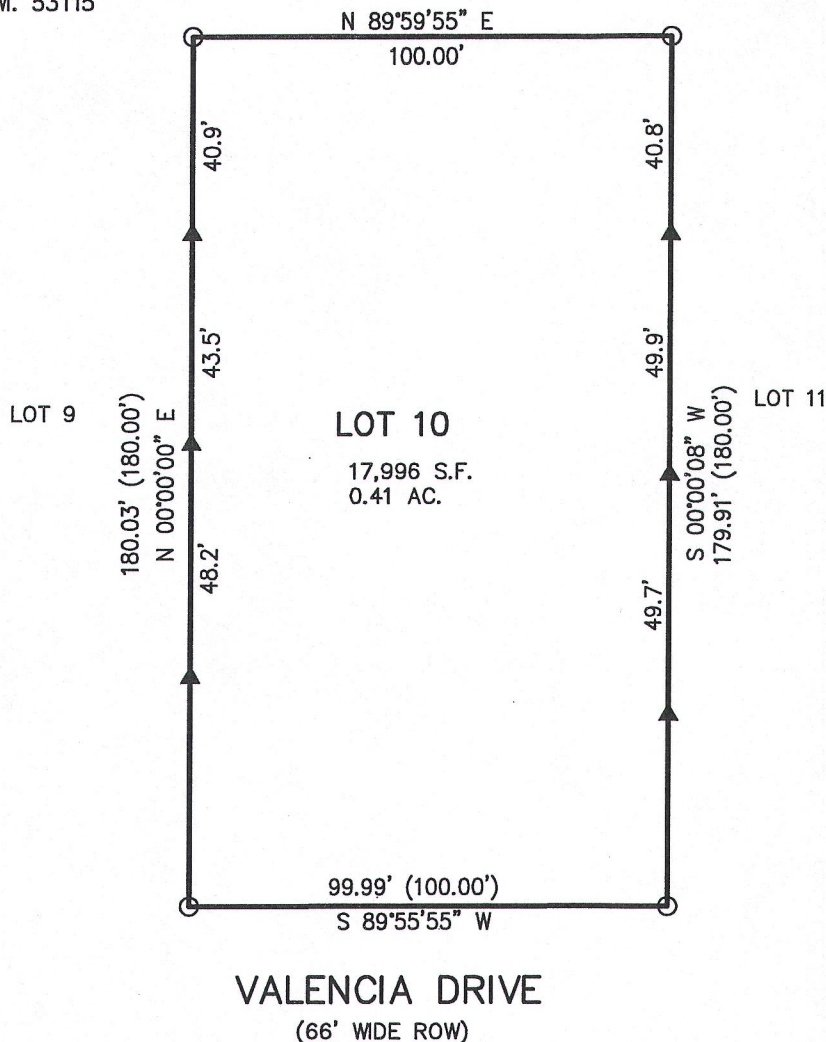

LEGEND

- = FOUND IRON PIPE STAKE
- ▲ = SET LATHE ON LINE
- (XXX) = RECORDED AS

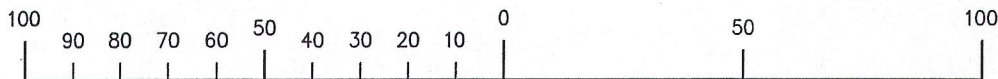


MAP SCALE IN FEET ORIGINAL 1" = 40'

NOTE: COPIES OF THIS MAP TO WHICH THE FOLLOWING CERTIFICATE WILL APPLY SHOW SURVEYOR'S ORIGINAL SEAL AND SIGNATURE IN RED INK. COPIES BY ANY OTHER MEANS MAY HAVE ALTERATIONS WHICH DO NOT REPRESENT THE SURVEYOR'S WORK PRODUCT.

I HEREBY CERTIFY THAT THE ABOVE DESCRIBED PROPERTY HAS BEEN SURVEYED UNDER MY DIRECTION AND THAT THE ABOVE MAP IS A TRUE REPRESENTATION THEREOF AND SHOWS THE SIZE AND LOCATION OF THE PROPERTY AND ITS EXTERIOR BOUNDARIES. THIS SURVEY IS MADE FOR THE USE OF THE PRESENT OWNERS OF THE PROPERTY, AND ALSO THOSE WHO PURCHASE, MORTGAGE, OR GUARANTEE THE TITLE THERETO WITHIN ONE YEAR FROM THE DATE HEREOF.

DATED: SEPTEMBER 26, 2016

PETER S. GORDON R.L.S. 2101

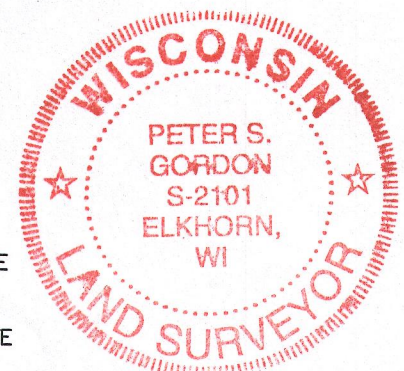

PROJECT NO. 9610
DATED: 09-26-2016
SHEET 1 OF 1 SHEETS

SEP 26 2016 FIN 5-48

216-5327