


HAROLD H. KOLB

REGISTERED PROFESSIONAL LAND SURVEYOR
LAKE GENEVA, WISCONSIN

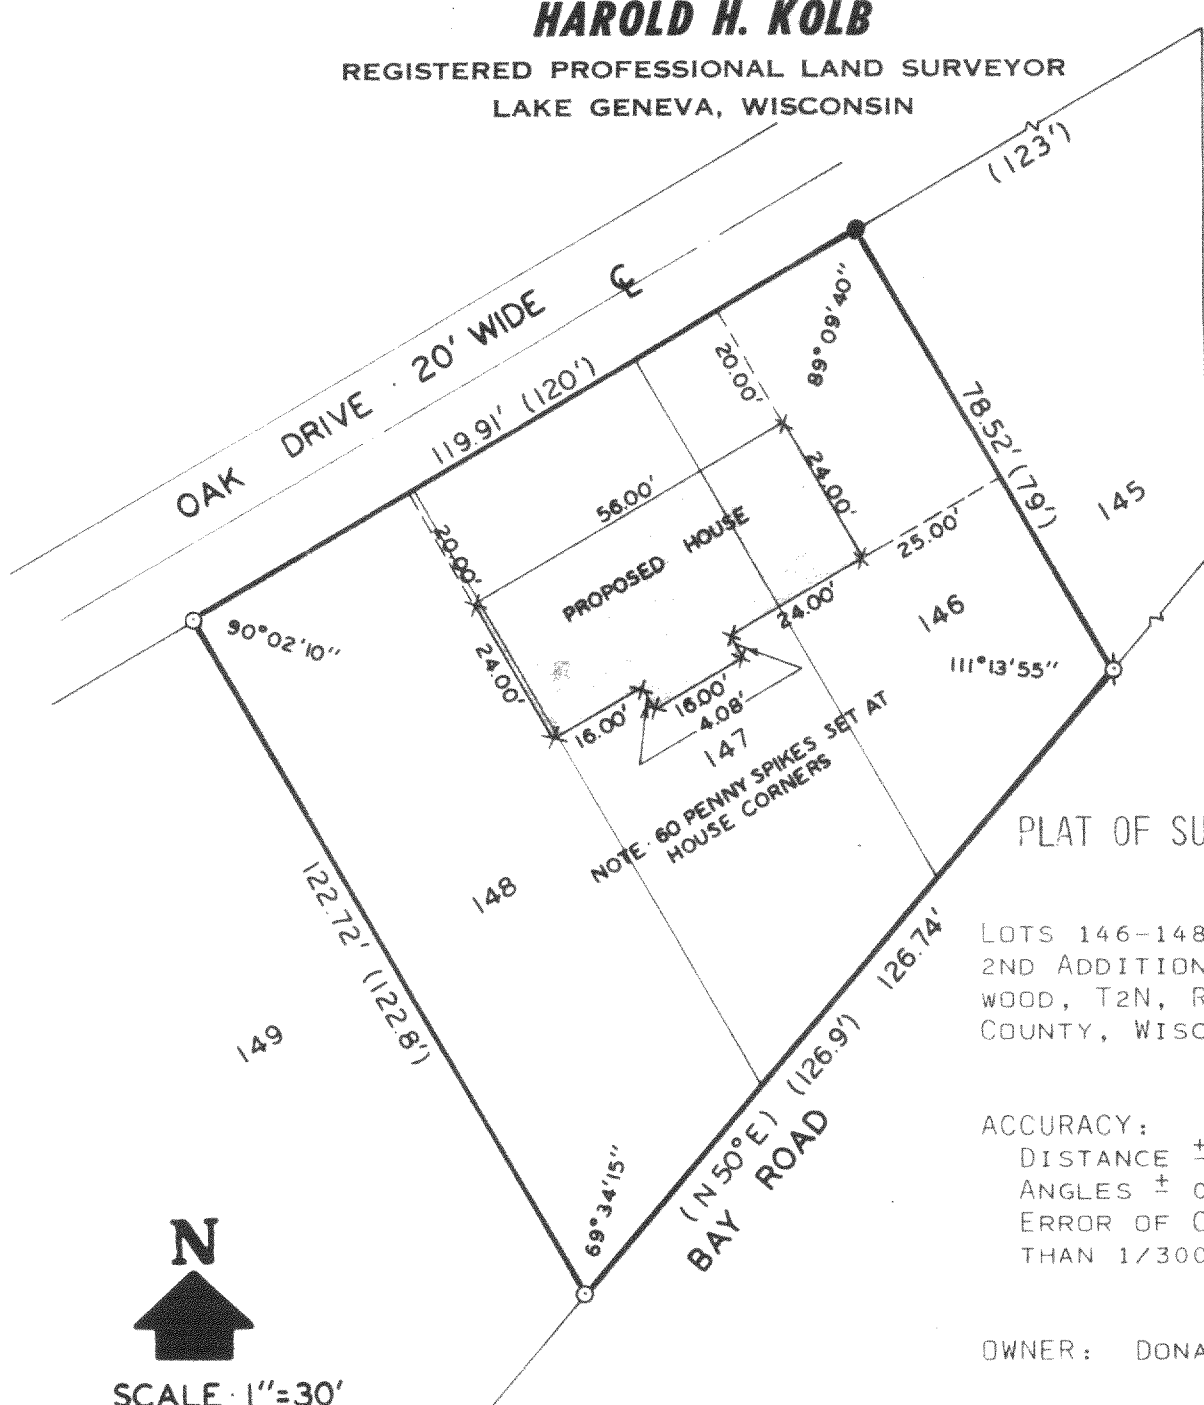

RAVENWOOD DR. 20' WIDE

PLAT OF SURVEY OF

LOTS 146-148, KRUMHAARS'
2ND ADDITION TO RAVEN-
WOOD, T2N, R16E, WALWORTH
COUNTY, WISCONSIN.

ACCURACY:
DISTANCE $\pm 0.01'$
ANGLES $\pm 05''$
ERROR OF CLOSURE LESS
THAN $1/3000$

OWNER: DONALD DEICHSEL

N
SCALE 1"=30'
LEGEND

- φ — IRON PIPE FOUND
- — IRON ROD FOUND
- — CONCRETE MONUMENT WITH CUT CROSS
- x — SPIKE
- () — AS PLATTED

I, HAROLD H. KOLB, DO HEREBY CERTIFY THAT I HAVE
SURVEYED THE PROPERTY HEREON DESCRIBED ACCORDING
TO THE OFFICIAL RECORDS, AND THAT THE PLAT HEREON
IS A CORRECT REPRESENTATION OF THE LOT LINES.

Eugene A. Blomquist For
HAROLD H. KOLB
WISCONSIN REGISTERED LAND SURVEYOR, S-187
DATE NOV. 19, 1975

FRA2-39

216-540