


PREPARED FOR:  
DIANE KRAUSE  
@ PROPERTIES  
LAKE GENEVA, WI. 53147

PATHFINDER SURVEYING INC.  
(formerly)  
J.K. SURVEYING INC.  
P.O. BOX 322  
LAKE GENEVA, WI. 53147  
WWW.PATHFINDERSURVEYING.NET  
262-248-8303

## PLAT OF SURVEY

- OF -

LOT 30, DUTCH MEADOWS SUBDIVISION, ACCORDING TO THE RECORD  
PLAT THEREOF. SAID LAND BEING IN THE TOWN OF DELAVAN, COUNTY  
OF WALWORTH AND STATE OF WISCONSIN.

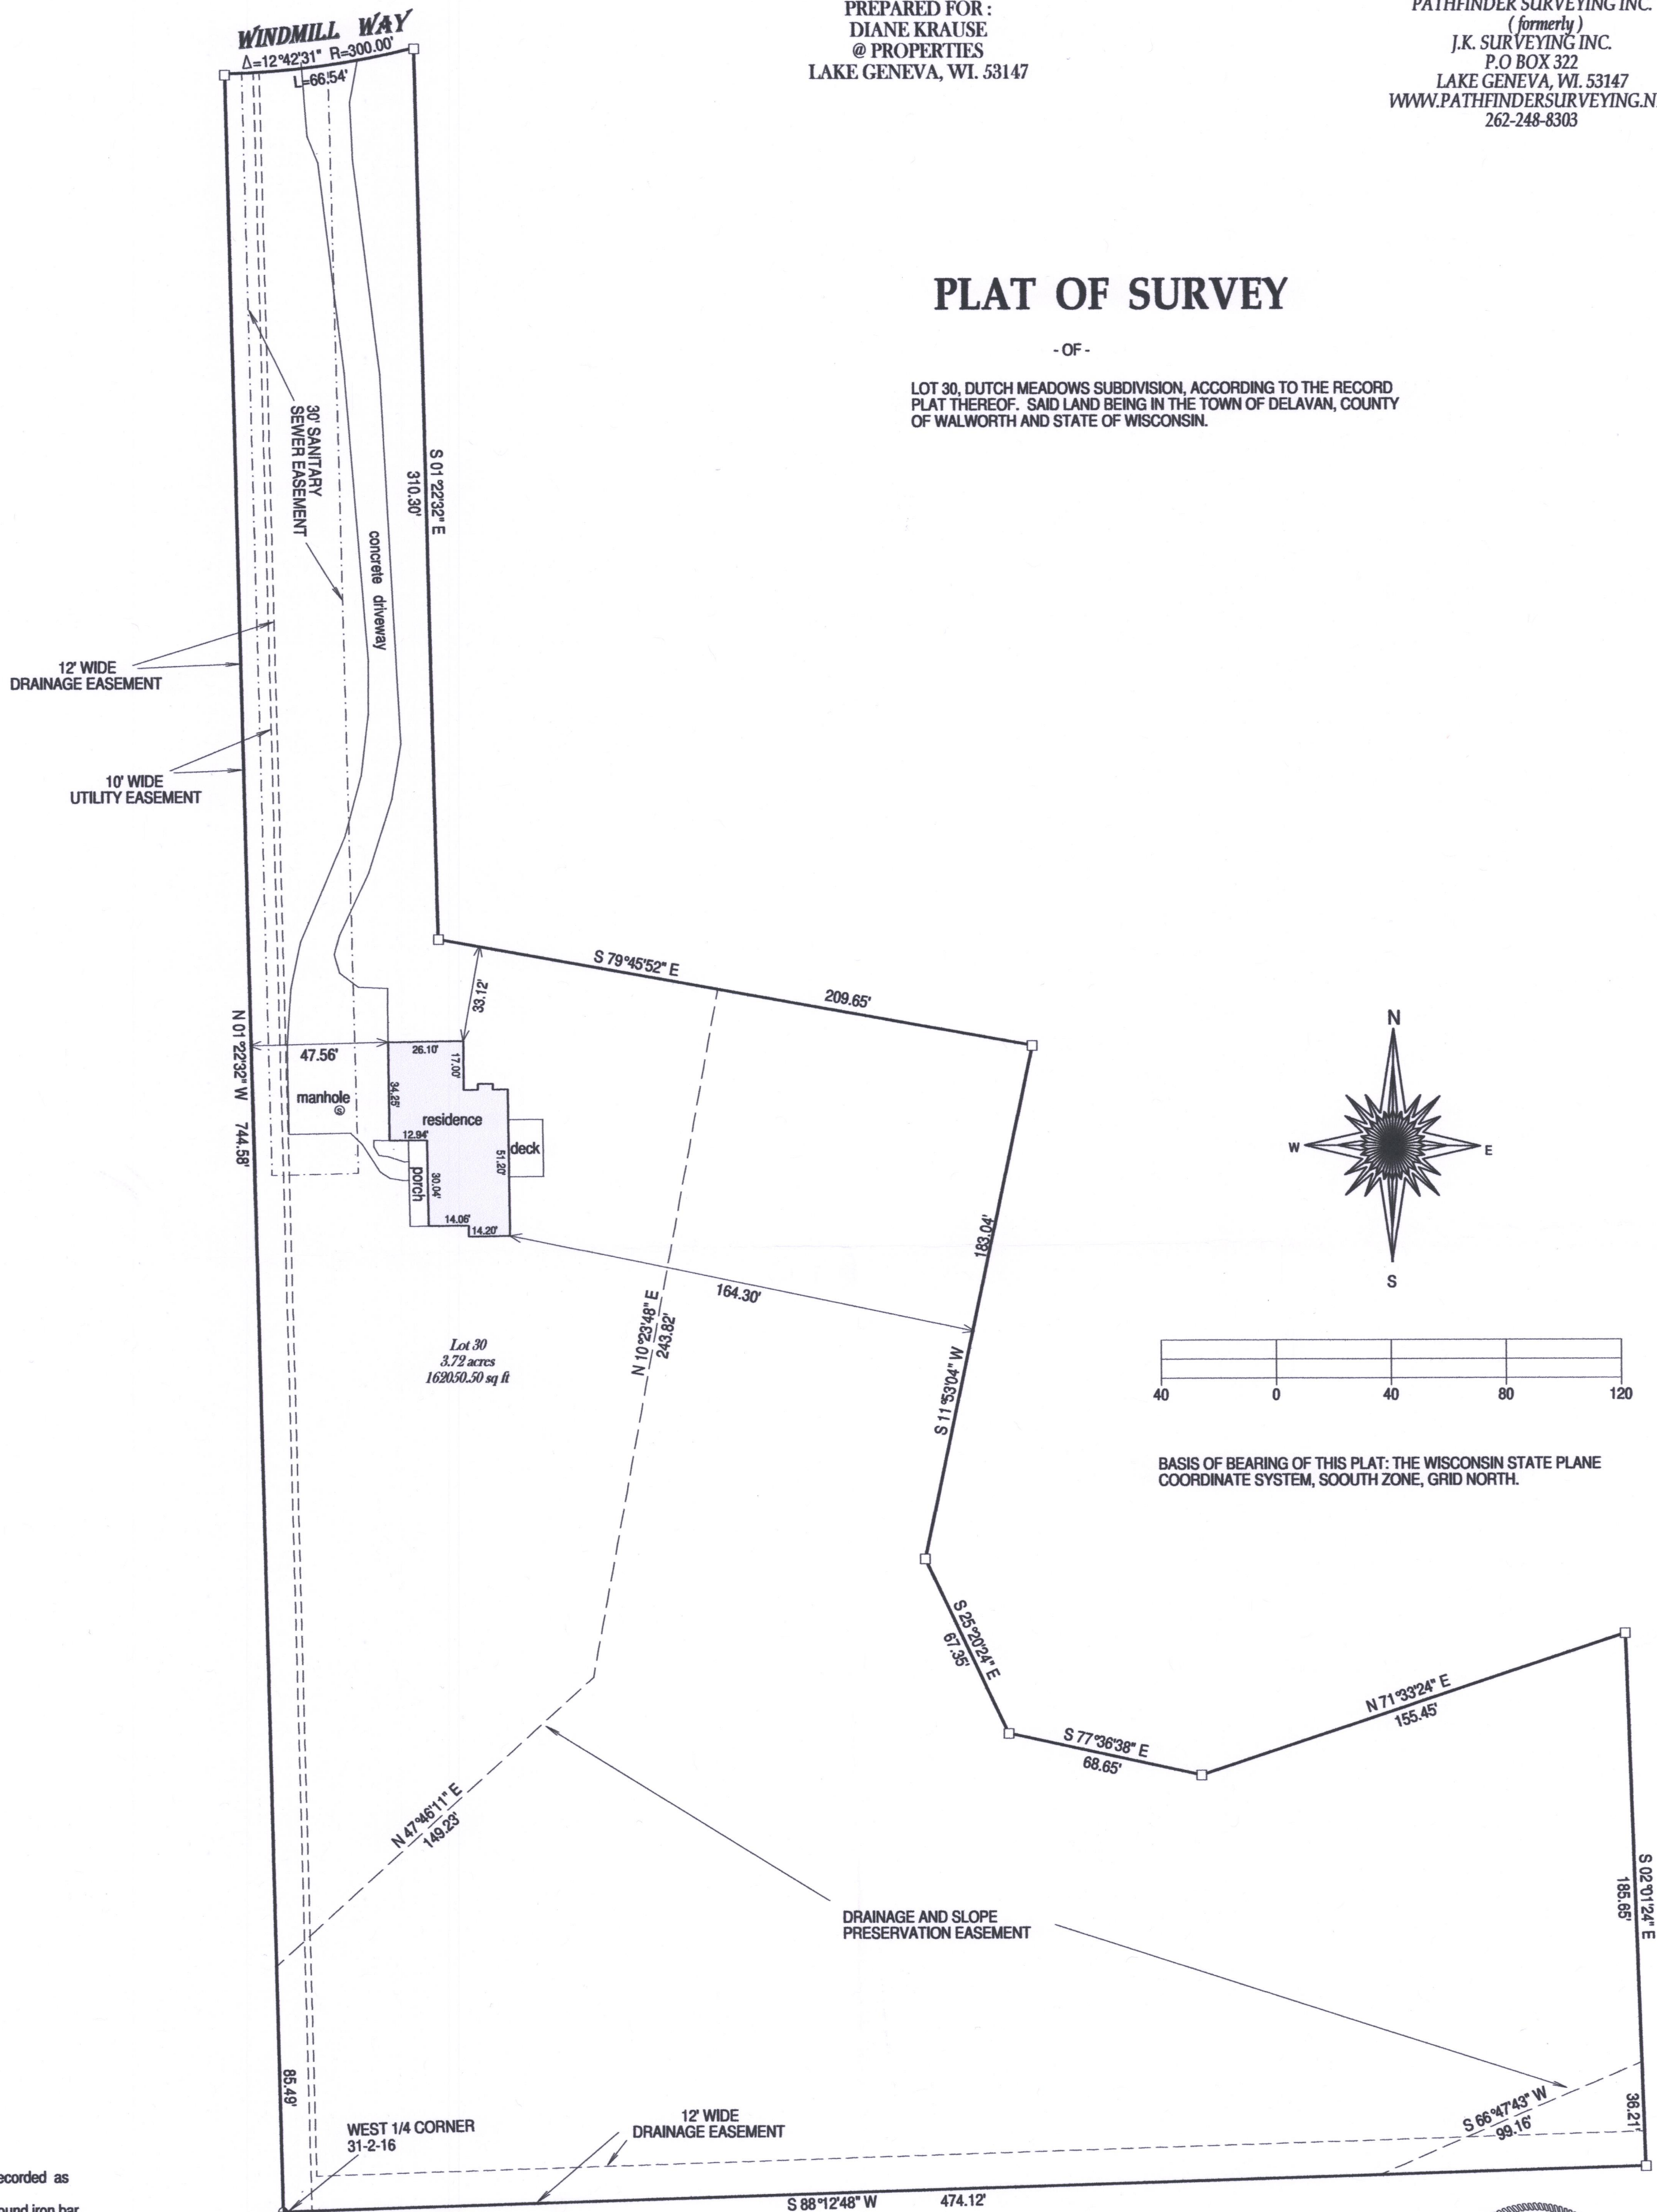

- ( ) = recorded as
- = found iron bar
- = found iron pipe
- = set iron pipe
- = set iron bar

SCALE 1" = 40'


JOB # 17-141A

TAX ID # FDUT 00030

I hereby certify that I have surveyed the above-described property and the above map is a true representation thereof and shows the size and location of the property, its exterior boundaries, the location and dimensions of all structures thereon, fences, appurtenant easements and roadways and visible encroachments if any.

This survey is made for the present owners of the property, and those who purchase, mortgage, or guarantee the title thereto, within one year from the date hereof.

DATED THIS 2ND DAY OF JUNE, 2017.

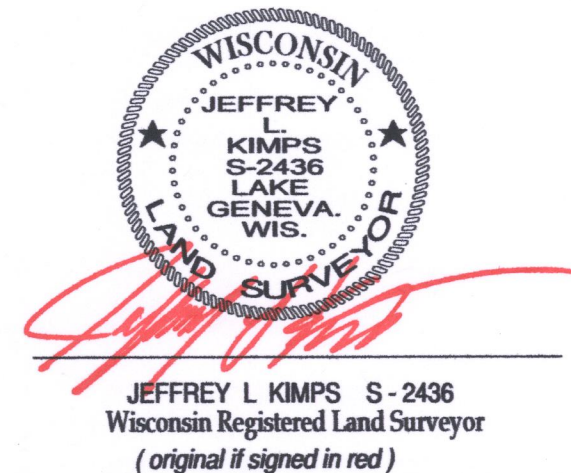

JEFFREY L. KIMPS S-2436  
Wisconsin Registered Land Surveyor  
(original if signed in red)

FdUT-30

216-5401