

LEGEND


- FOUND CONCRETE MONUMENT
- FOUND IRON PIPE
- FOUND IRON ROD
- FOUND MASONRY NAIL
- SET IRON PIPE
- ⊕ SANITARY SEWER MANHOLE
- ⊕ UTILITY POLE
- ⊕ UTILITY BOX
- ⊕ LAMP POST
- () RECORDED AS
- OVERHEAD UTILITY LINES
- - - BURIED ELECTRIC LINE
- - - BURIED GAS LINE
- DECIDUOUS TREE
- CONIFEROUS TREE

NOTE: THIS OFFICE IS NOT AN EXPERT IN TREE IDENTIFICATION AND SOME OF THE TREES DEPICTED HEREON MAY BE LABELED AS AN INCORRECT SPECIES.

NOTE: THE 100 YEAR FLOOD ELEVATION IS 929.0' PER FEMA FIRM MAP NUMBER 55127C03010 WITH AN EFFECTIVE DATE OF OCTOBER 2, 2009. THE 929.0' CONTOUR LIES BETWEEN THE TOP OF RIP-RAP AND THE WATER'S EDGE OR THE TOP OF SEAWALL AND THE WATER'S EDGE.

NOTE: THE EASEMENTS AS SHOWN HEREON ARE BASED ON RECORDS FOUND IN THE PROCESS OF RESEARCHING THIS PARCEL. REFER TO A CURRENT TITLE REPORT FOR ANY OTHER POTENTIAL EASEMENTS, RESTRICTIONS OR COVENANTS WHICH MAY AFFECT THIS PROPERTY.

NOTE: THE PROJECT BENCHMARK IS THE MEANDER CORNER LOCATED ON THE EAST-WEST 1/4 SECTION LINE, BEING THE WEST WITNESS CORNER FOR THE CENTER OF SECTION 28-2-16. SAID CORNER IS A BRASS CAPPED GALVANIZED IRON PIPE WITH AN ELEVATION OF 934.20' PER DOSSIER SHEET LAST DATED JANUARY 23, 1996.

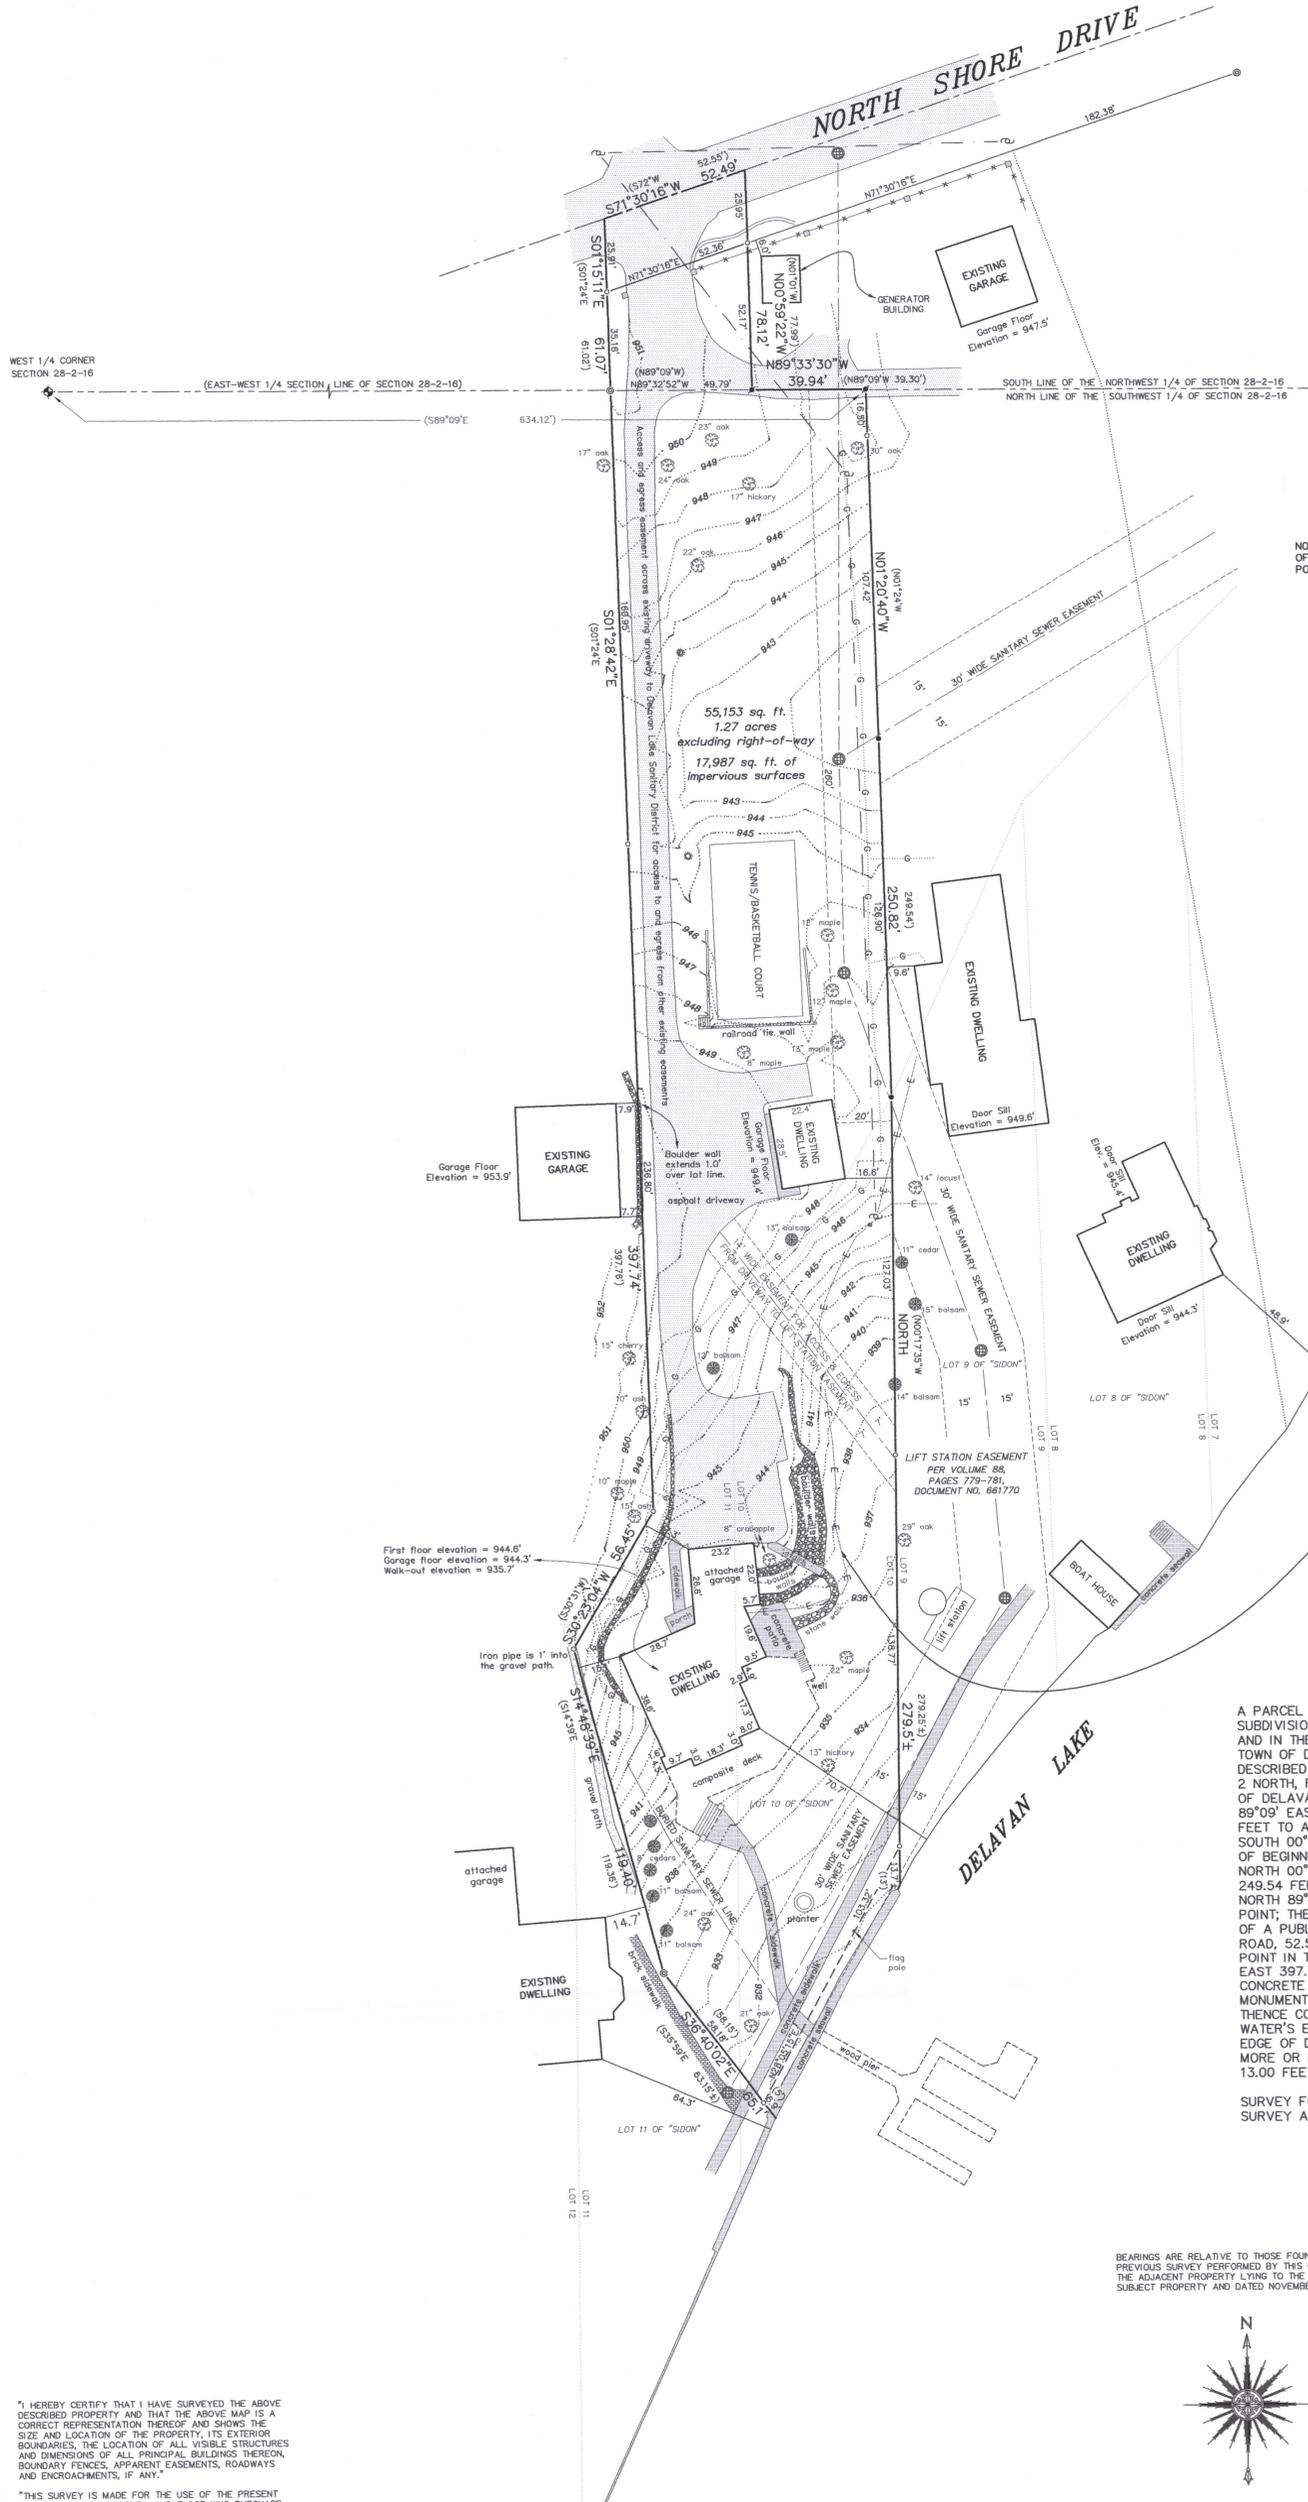


**PLAT OF SURVEY
-OF-**

A PARCEL OF LAND WHICH IS A PART OF LOTS 10 AND 11 OF SIDON'S SUBDIVISION AND OTHER UNPLATTED LAND ALL LOCATED IN THE SOUTHWEST 1/4 AND IN THE NORTHWEST 1/4 OF SECTION 28, TOWNSHIP 2 NORTH, RANGE 16 EAST, TOWN OF DELAVAN, WALWORTH COUNTY, WISCONSIN, MORE PARTICULARLY DESCRIBED AS: BEGINNING AT THE WEST 1/4 CORNER OF SECTION 28, TOWNSHIP 2 NORTH, RANGE 16 EAST OF THE FOURTH PRINCIPAL MERIDIAN, IN THE TOWNSHIP OF DELAVAN, COUNTY OF WALWORTH, STATE OF WISCONSIN, RUN THENCE SOUTH 89°09' EAST ON THE NORTH LINE OF THE SOUTHWEST 1/4 OF SECTION 28, 634.12 FEET TO A POINT; THENCE SOUTH 01°24' EAST 249.54 FEET TO A POINT; THENCE SOUTH 00°17'35" WEST 266.25 FEET TO A POINT, SAID POINT MARKS THE PLACE OF BEGINNING OF THE PARCEL OF LAND HEREINAFTER DESCRIBED; RUN THENCE NORTH 00°17'35" EAST 266.25 FEET TO A POINT; THENCE NORTH 01°24' WEST 249.54 FEET TO A POINT IN THE EAST AND WEST 1/4 SECTION LINE; THENCE NORTH 89°09' WEST ON THE EAST AND WEST 1/4 SECTION LINE 39.30 FEET TO A POINT; THENCE NORTH 01°01' WEST 77.99 FEET TO A POINT IN THE CENTERLINE OF A PUBLIC ROAD; THENCE SOUTH 72° WEST ALONG THE CENTERLINE OF SAID ROAD, 52.59 FEET TO A POINT; THENCE SOUTH 01°24' EAST 61.02 FEET TO A POINT IN THE EAST AND WEST 1/4 SECTION LINE; THENCE CONTINUE SOUTH 01°24' EAST 397.76 FEET TO A POINT; THENCE SOUTH 30°31' WEST 56.45 FEET TO A CONCRETE MONUMENT; THENCE SOUTH 14°39' EAST 119.36 FEET TO A CONCRETE MONUMENT; THENCE SOUTH 35°59' EAST 58.15 FEET TO A CONCRETE MONUMENT; THENCE CONTINUE SOUTH 35°59' EAST 5.00 FEET, MORE OR LESS TO THE WATER'S EDGE OF DELAVAN LAKE; THENCE NORTHEASTERLY ALONG THE WATER'S EDGE OF DELAVAN LAKE TO A POINT THAT IS SOUTH 00°17'35" WEST 13.00 FEET, MORE OR LESS FROM THE PLACE OF BEGINNING; THENCE NORTH 00°17'35" EAST 13.00 FEET MORE OR LESS TO THE PLACE OF BEGINNING.

SURVEY FOR: FRANK & DONNA MALY
SURVEY ADDRESS: 2548 NORTH SHORE DRIVE, DELAVAN, WI 53115

BEARINGS ARE RELATIVE TO THOSE FOUND ON A PREVIOUS SURVEY PERFORMED BY THIS OFFICE OF THE ADJACENT PROPERTY LYING TO THE EAST OF THE SUBJECT PROPERTY AND DATED NOVEMBER 30, 2016.

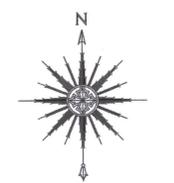

0 15' 30' 60'
SCALE: 1" = 30'



THIS IS NOT AN ORIGINAL PRINT UNLESS THIS SEAL IS RED.

Thomas L. Satter
THOMAS L. SATTER S-2850
SEPTEMBER 6, 2017 071706
DATE JOB NUMBER

"I HEREBY CERTIFY THAT I HAVE SURVEYED THE ABOVE DESCRIBED PROPERTY AND THAT THE ABOVE MAP IS A CORRECT REPRESENTATION THEREOF AND SHOWS THE SIZE AND LOCATION OF THE PROPERTY, ITS EXTERIOR BOUNDARIES, THE LOCATION OF ALL VISIBLE STRUCTURES AND DIMENSIONS OF ALL PRINCIPAL BUILDINGS THEREON, BOUNDARY FENCES, APPARENT EASEMENTS, ROADWAYS AND ENCROACHMENTS, IF ANY."

"THIS SURVEY IS MADE FOR THE USE OF THE PRESENT OWNERS OF THE PROPERTY, AND THOSE WHO PURCHASE, MORTGAGE, OR GUARANTEE THE TITLE THERETO WITHIN ONE YEAR FROM DATE HEREOF."

SATTER SURVEYING, LLC
LAND SURVEYS, MAPPING AND PLANNING
272 ORIGIN STREET
BURLINGTON, WI 53105
262-661-4239

F&I-10 216-5416