
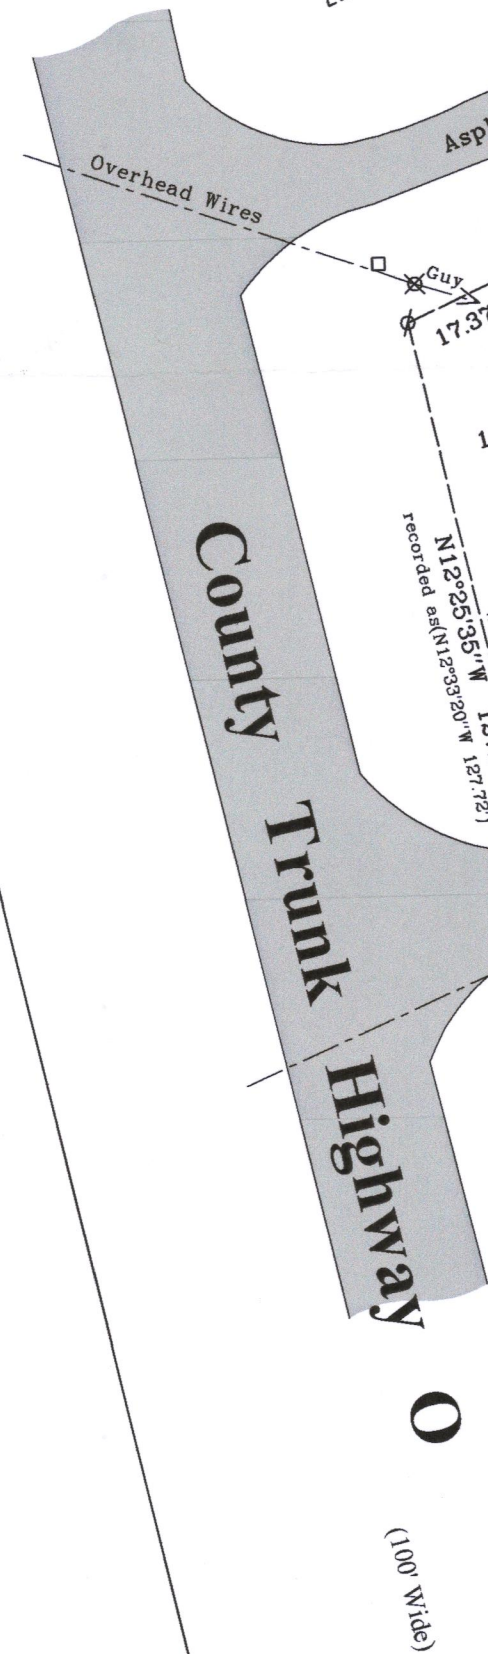


of

a subdivision located in the Northeast 1/4 of the Northwest 1/4 of Section 31,
Town 2 North, Range 16 East, Town of Delavan, Walworth County, Wisconsin.

Surveyed for:

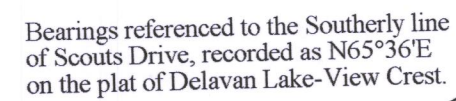

239.82

Deck

Patio

40.8'

10.2'

5.0'

17.6'

8.6'

7.2'

19.2'

7.2'

1.1'

28.6'

13.5'

Porch

40.0'

24.4'

House
No. 2818

Lot 20

Lot 21

Garage

24.3'

24.3'

Block Ret.

Note:
The location of paved or gravel surfaces shown on this plat are approximate due to existing snow cover on the property at the time of the field survey.
There may be additional improvements or encroachments on the property which were not visible at the time of the field survey and are not shown on this plat.

Copyright ©2017 by Olson Land Surveying, LLC.

All rights reserved. No part of this survey plat may be reproduced or transmitted in any form by any means - graphic, electronic, or mechanical, including photocopying, tracing, or information storage and retrieval systems - without permission in writing from Douglas G. Olson, Olson Land Surveying, LLC.

I hereby certify that I have surveyed the above described property in compliance with Chapter A-E 7 of the Wisconsin Administrative Code and that the map hereon is correct to the best of my professional knowledge and belief and shows the size and location of the property, its exterior boundaries, the location and dimensions of all visible structures thereon, boundary fences, apparent easements and roadways and visible encroachments, if any.

This survey is made for the exclusive use of the present owners of the property, and also those who purchase, mortgage or guarantee title thereto, within one year from the date hereof.

Douglas G. Olson
Wisconsin Professional Land Surveyor - 2093

FdLV-20B 216-5487

Survey Date: January 25, 2018.

Revisions:

Scale in Feet
1" = 30'



A horizontal graphic scale bar with alternating black and white segments. Below the bar, the following values are marked: 0', 15', 30', 60', and 90'.

45 South Wisconsin Street | P.O. Box 322
Elkhorn, Wisconsin. 53121
Telephone: (262) 723-3434
Facsimile: (262) 723-8044
Email: doug@olsonsurveying.com
Website: www.olsonsurveying.com

OLSON
LAND SURVEYING, LLC
Rural | Residential | Commercial

[illegible]

Sheet 1 of 1 Sheets

Drawing Name:

Job Reference Number

2018 007

2018.007