


AMBIT LAND SURVEYING
8120-312th Avenue
Wheatland, WI. 53105-8934
Licensed Professionals in
both Illinois & Wisconsin

PLAT OF SURVEY OF

PHONE: 262-537-4874
FAX: 262-537-4221
EMAIL: ambit@tds.net

Lot 9 and the East Half of Lot 8 of BRATLEY'S SUBDIVISION of part of Section 28, Town 2 North,
Range 16 East of the 4th Principal Meridian, Walworth County, Wisconsin.

PARCEL IDENTIFICATION NO: FBRS 00006A

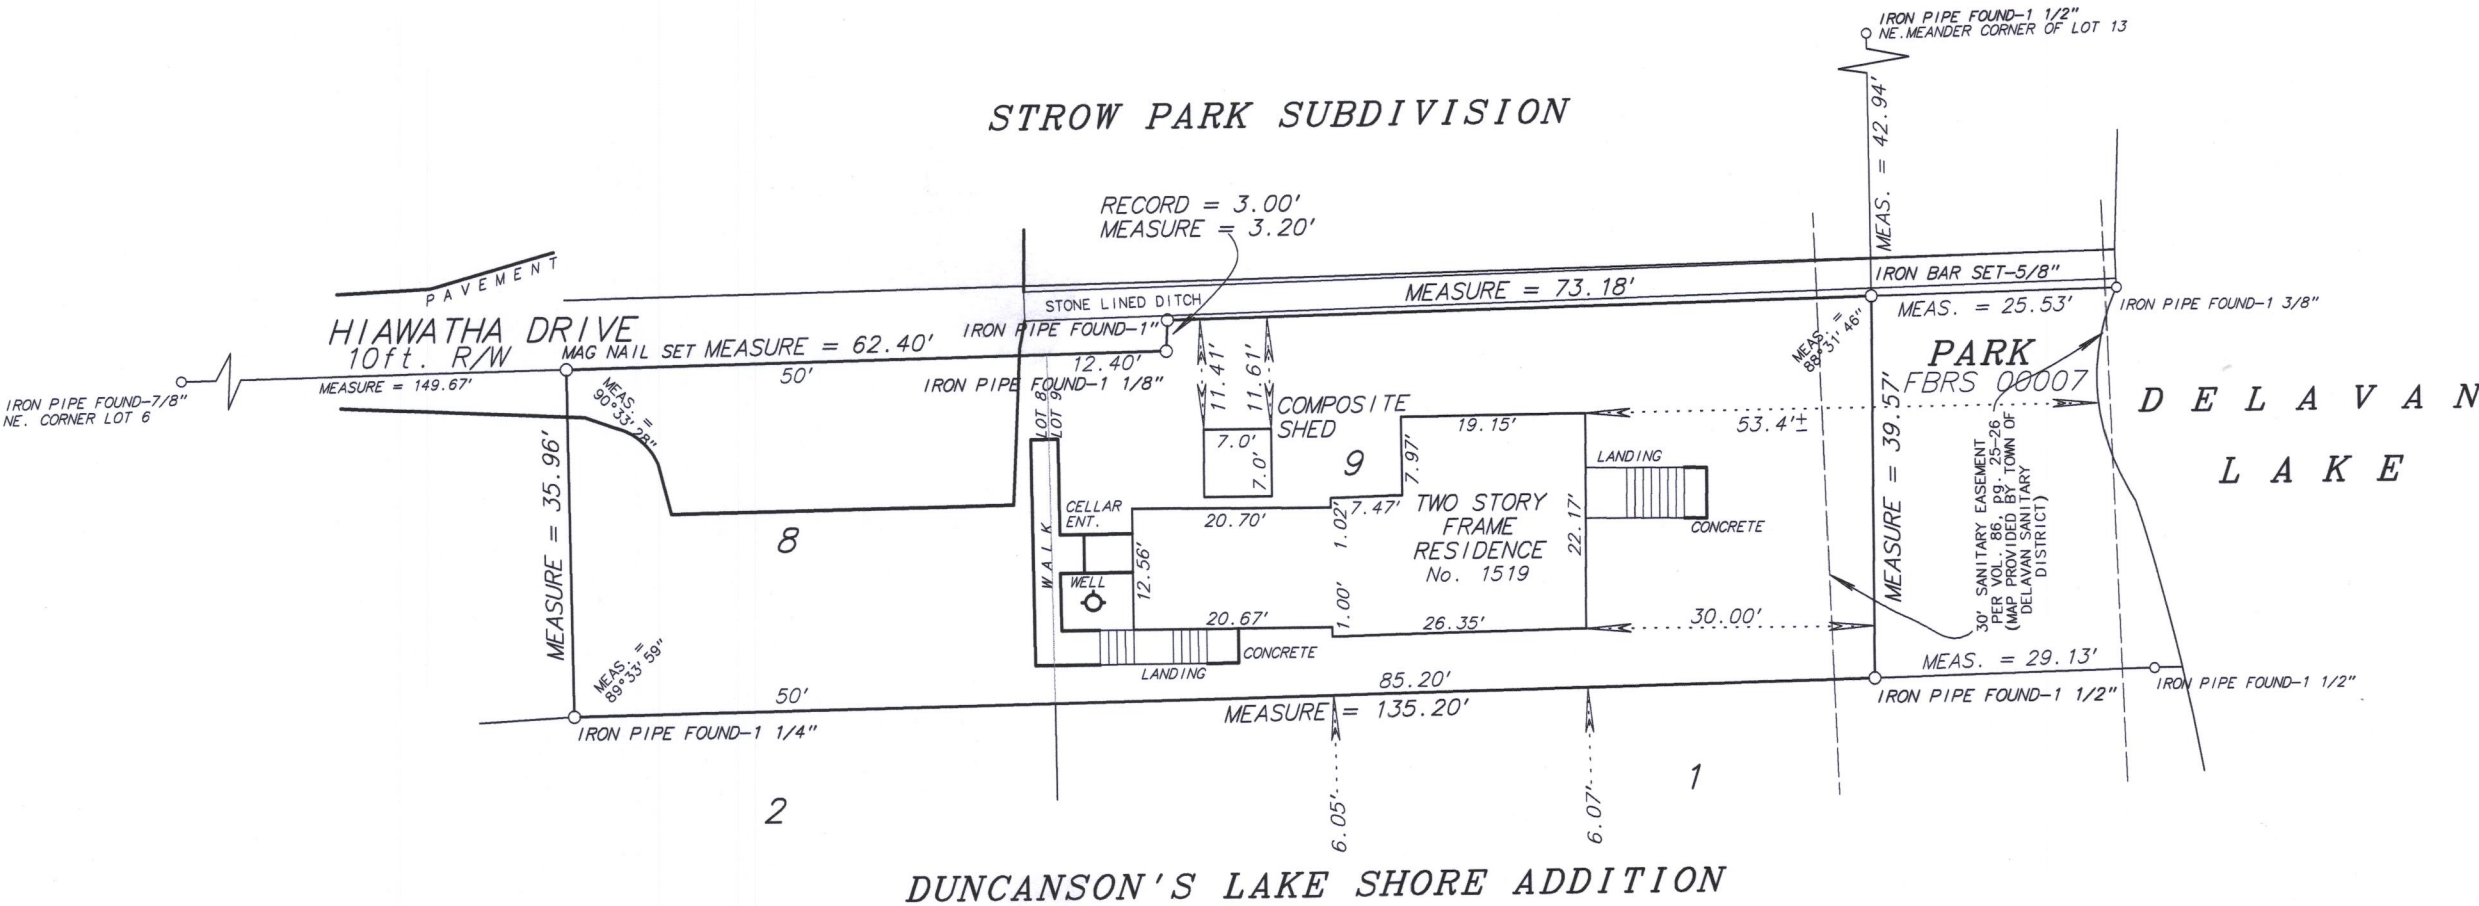

NOTE:
NO DOCUMENT WAS PROVIDED OR LOCATED FOR THE "PARK" AREA.
THE ONLY EVIDENCE FOR THE "PARK" IS FROM THE COUNTY TAX
MAP AT THIS TIME.



SCALE: 1 inch = 20 feet
ORDERED BY: D. Morrissey
JOB NO.: 17142
FBRS-6A



Fieldwork completed on and date of certification: September 5, 2017
I hereby certify that I have surveyed the above described property and the above
plat is a true representation thereof and shows the size and location of the
property, its exterior boundaries, the location and dimensions of all visible
structures thereon, boundary lines, apparent easements and roadways and visible
encroachments, if any.
This survey is made for the exclusive use of the present owners of the property,
and also those who purchase, mortgage or guarantee the title thereto within ONE
YEAR from the date hereof.
Dated at Basset, Wisconsin this _____ day of _____ 2017.

Mark A. Bolender
Wisconsin Professional Land Surveyor - 1784

216-5492