


GEORGE T. DUNHAM
SURVEYING & SUBDIVIDING
DELAVER, WISCONSIN

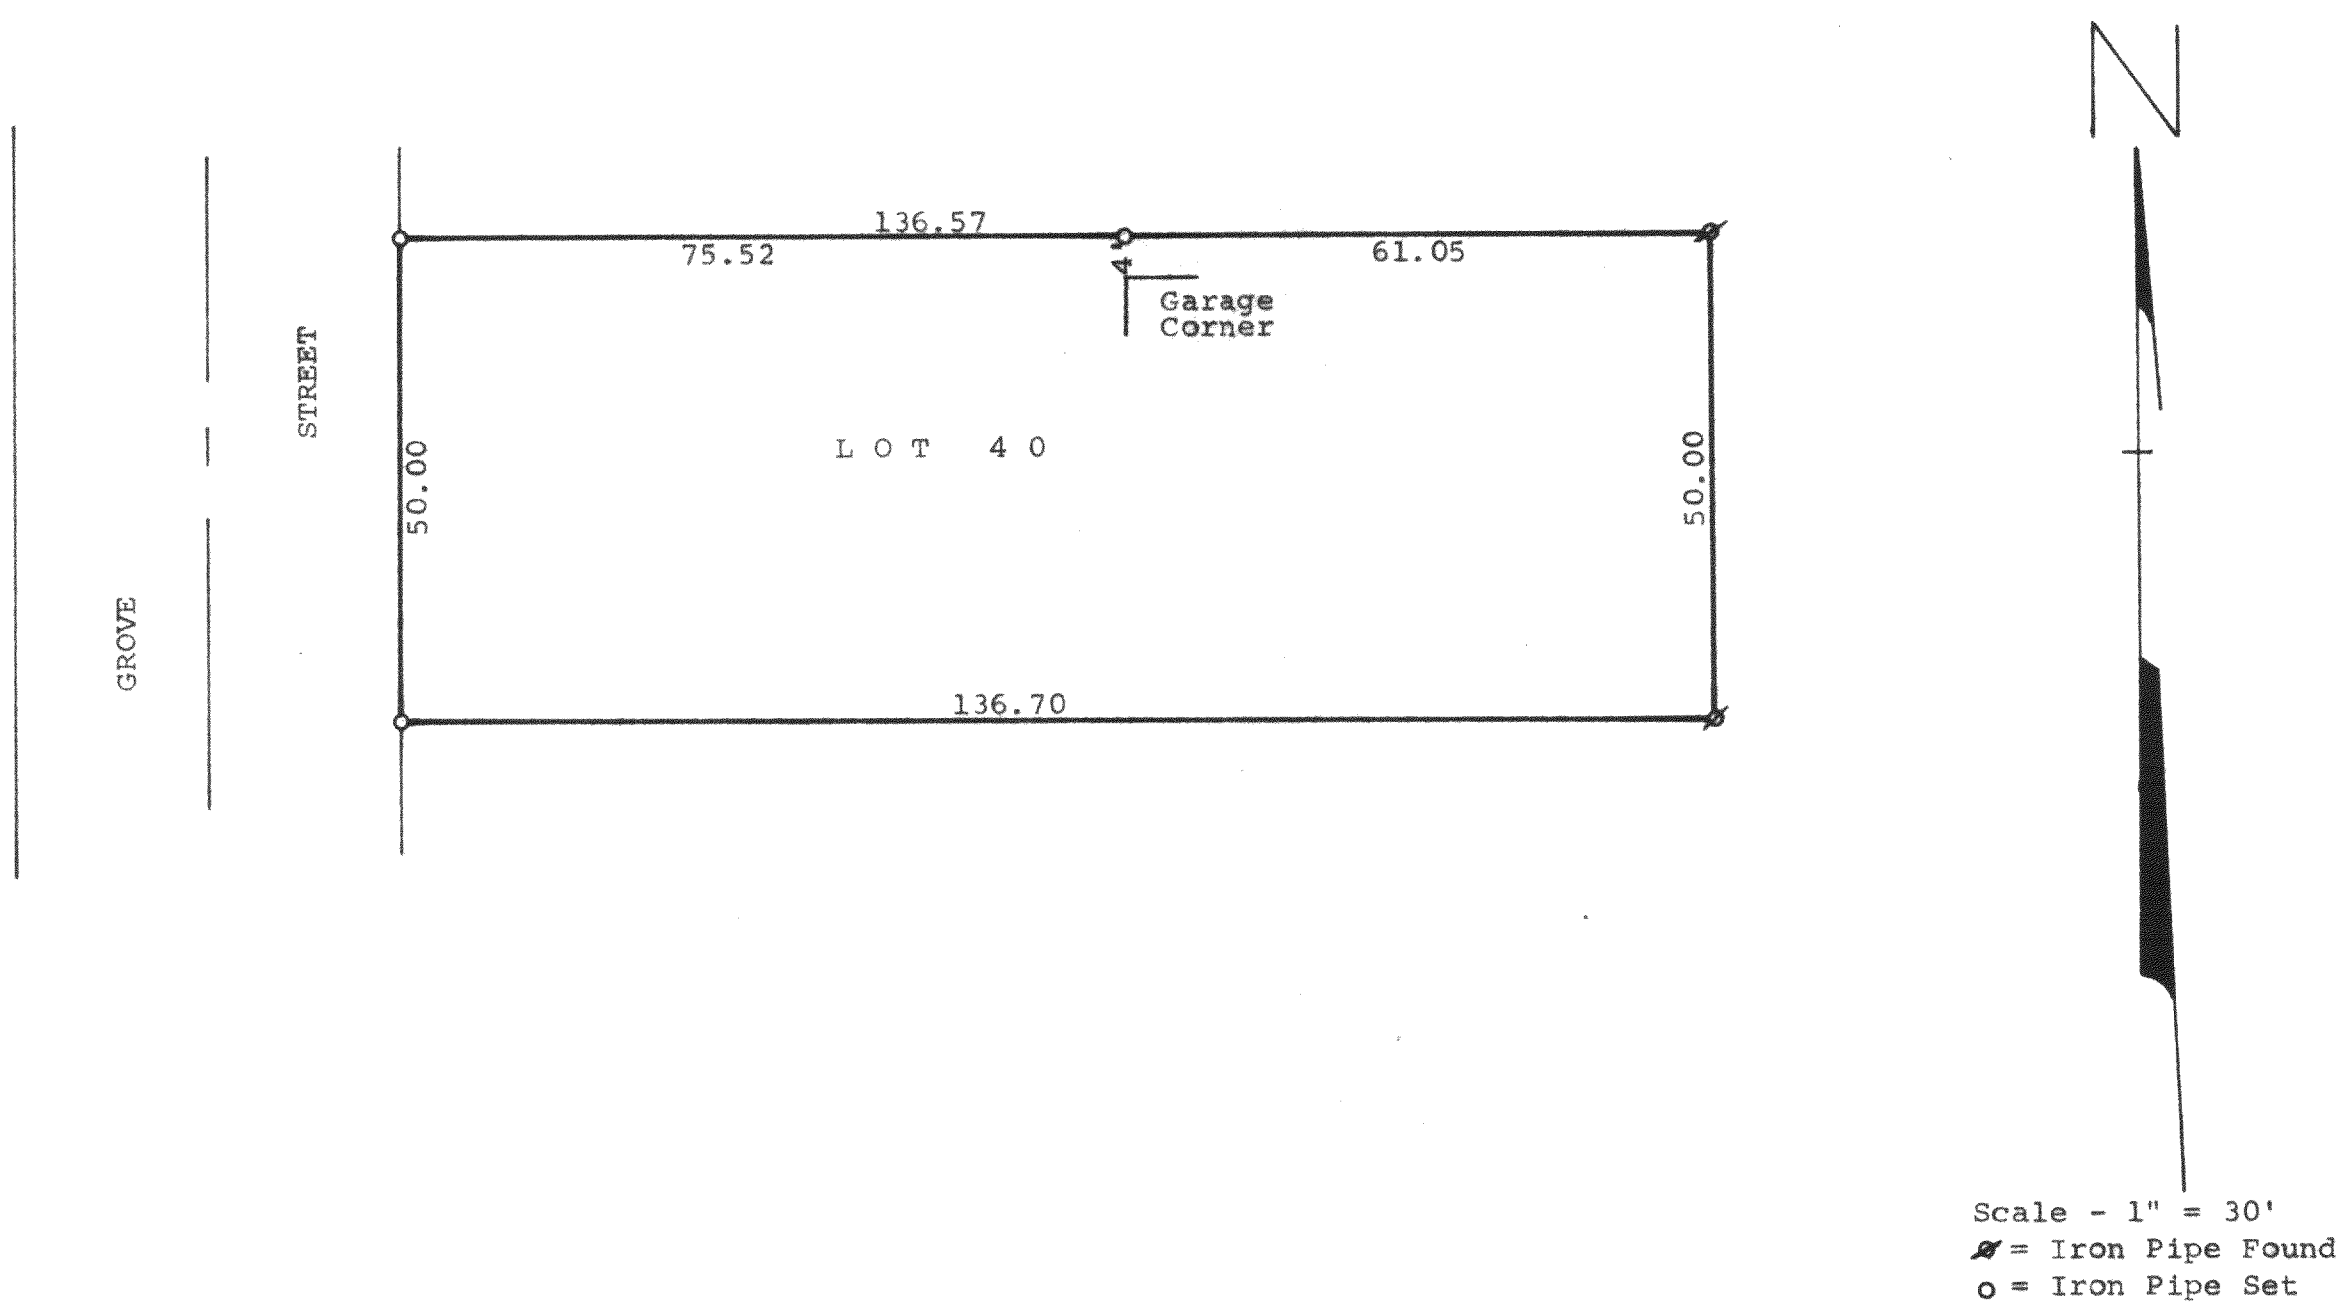

Plat of survey of Lot 40 in Lake View Subdivision located
in Section 32, T 2 N, R 16 E, Walworth County, Wisconsin.
June 15, 1976

George T. Dunham
George T. Dunham, Surveyor

