
Plat of Survey

Lots 1 & 2 of Certified Survey Map No. 4807,

recorded in Vol. 32 of Certified Survey Maps of Walworth County on Page 83 and located in Government Lot 3 in the Southwest 1/4 of Section 32, Town 2 North, Range 16 East, Town of Delavan, Walworth County, Wisconsin.

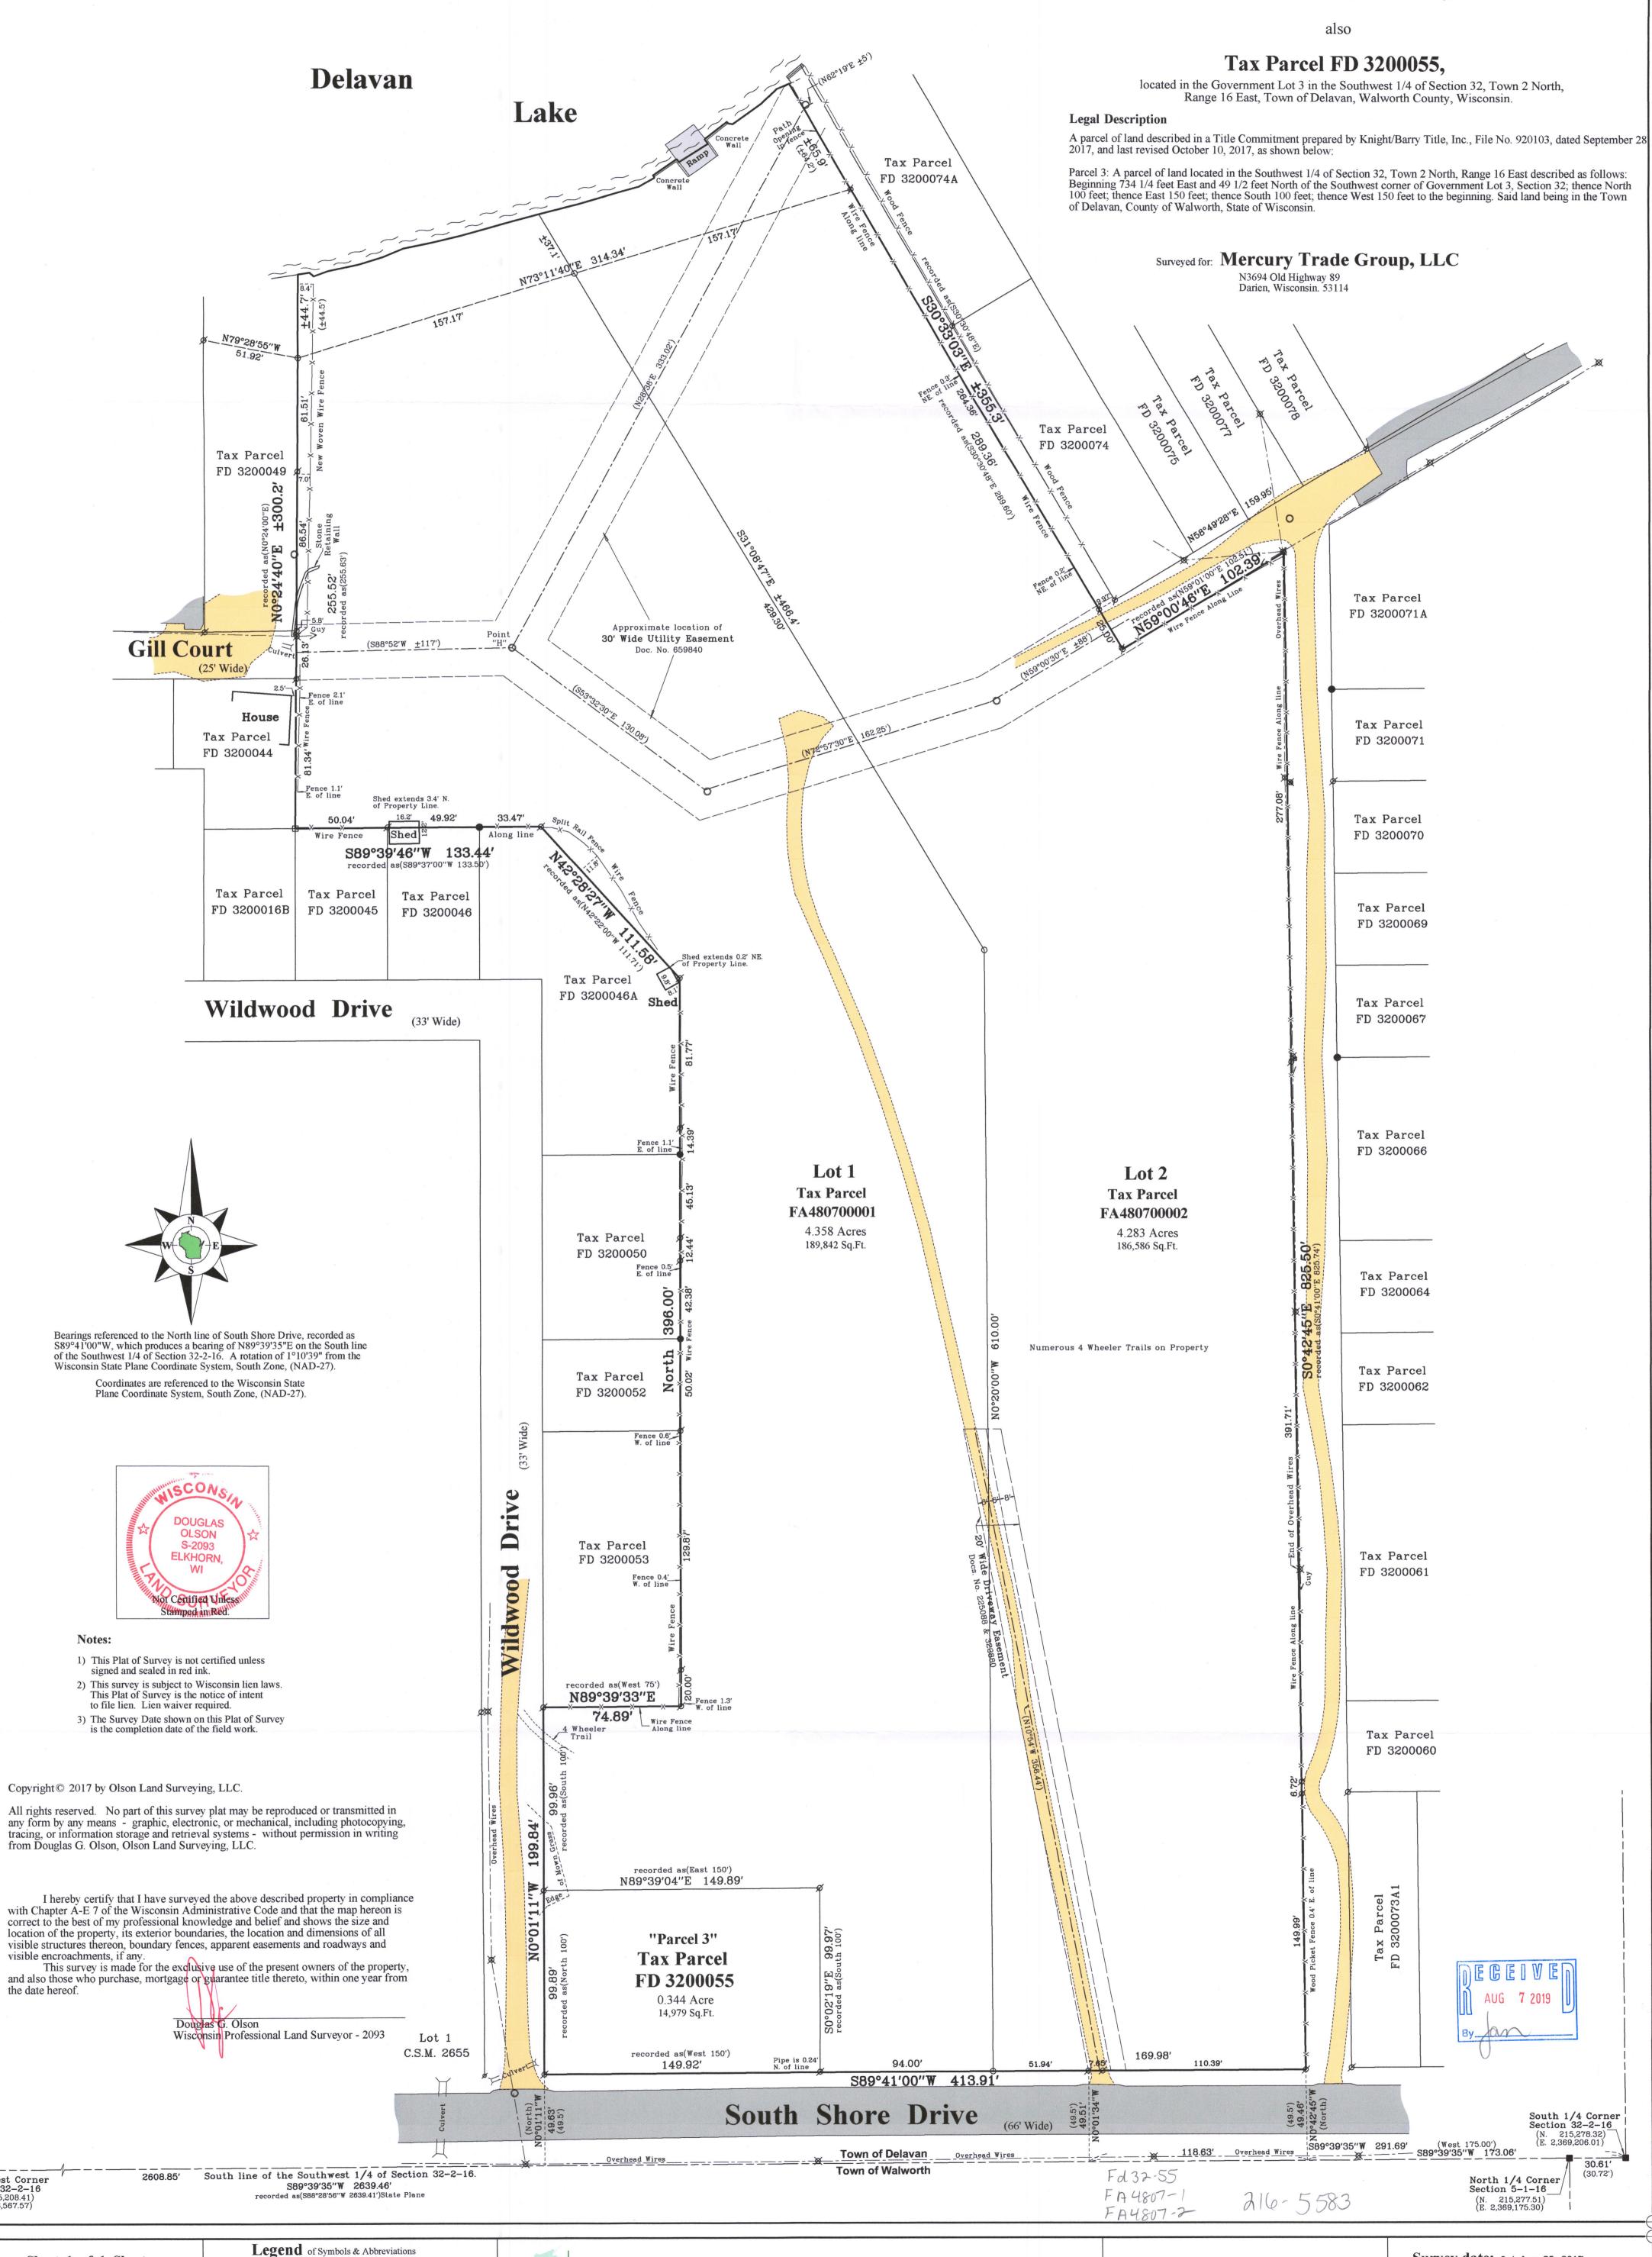

Sheet 1 of 1 Sheets Drawing Name:

Job Reference Number

2018.095

Southwest Corner Section 32-2-16 (N. 215,208.41) (E. 2,366,567.57)

Found County Section Corner

Found Iron Pipe
Found Iron Rod
Found Monument Found Iron Pipe
Found Iron Rod
O Set Iron Pipe, 1" dia.
() Recorded Information ₩ Utility Pole
 ₩ Utility Pedestal
 Concrete Cover
 ♦ Septic Vent
 ★Asphalt Surface Concrete Surface Cravel Surface Brick Pavers

N North S South E East W West W West
In Bearings
Degrees
Minutes
Seconds
In Distances
Inches
No. Number
NW. Northwest
NE. Northeast
Dia. Diameter

LAND SURVEYING, LLC Rural | Residential | Commercial

45 South Wisconsin Street | P.O. Box 322 Elkhorn, Wisconsin. 53121 Telephone: (262) 723-3434 Facsimile: (262) 723-8044 Email: doug@olsonsurveying.com Website: www.olsonsurveying.com

Scale in Feet 1'' = 40'

Survey date: October 25, 2017.

Revisions: No. 1 - Show Easement per Docs.
No. 225088 & 322880.
No. 2 - Proposed Lot Line
Adjustments
No. 3 - Proposed Parcels, show
Easement per Doc. No.
659840.
No. 4 - Recorded Certified
Survey Map No. 4807 Survey Map No. 4807