


0000-016

FPO-8

910-2000

216-5600

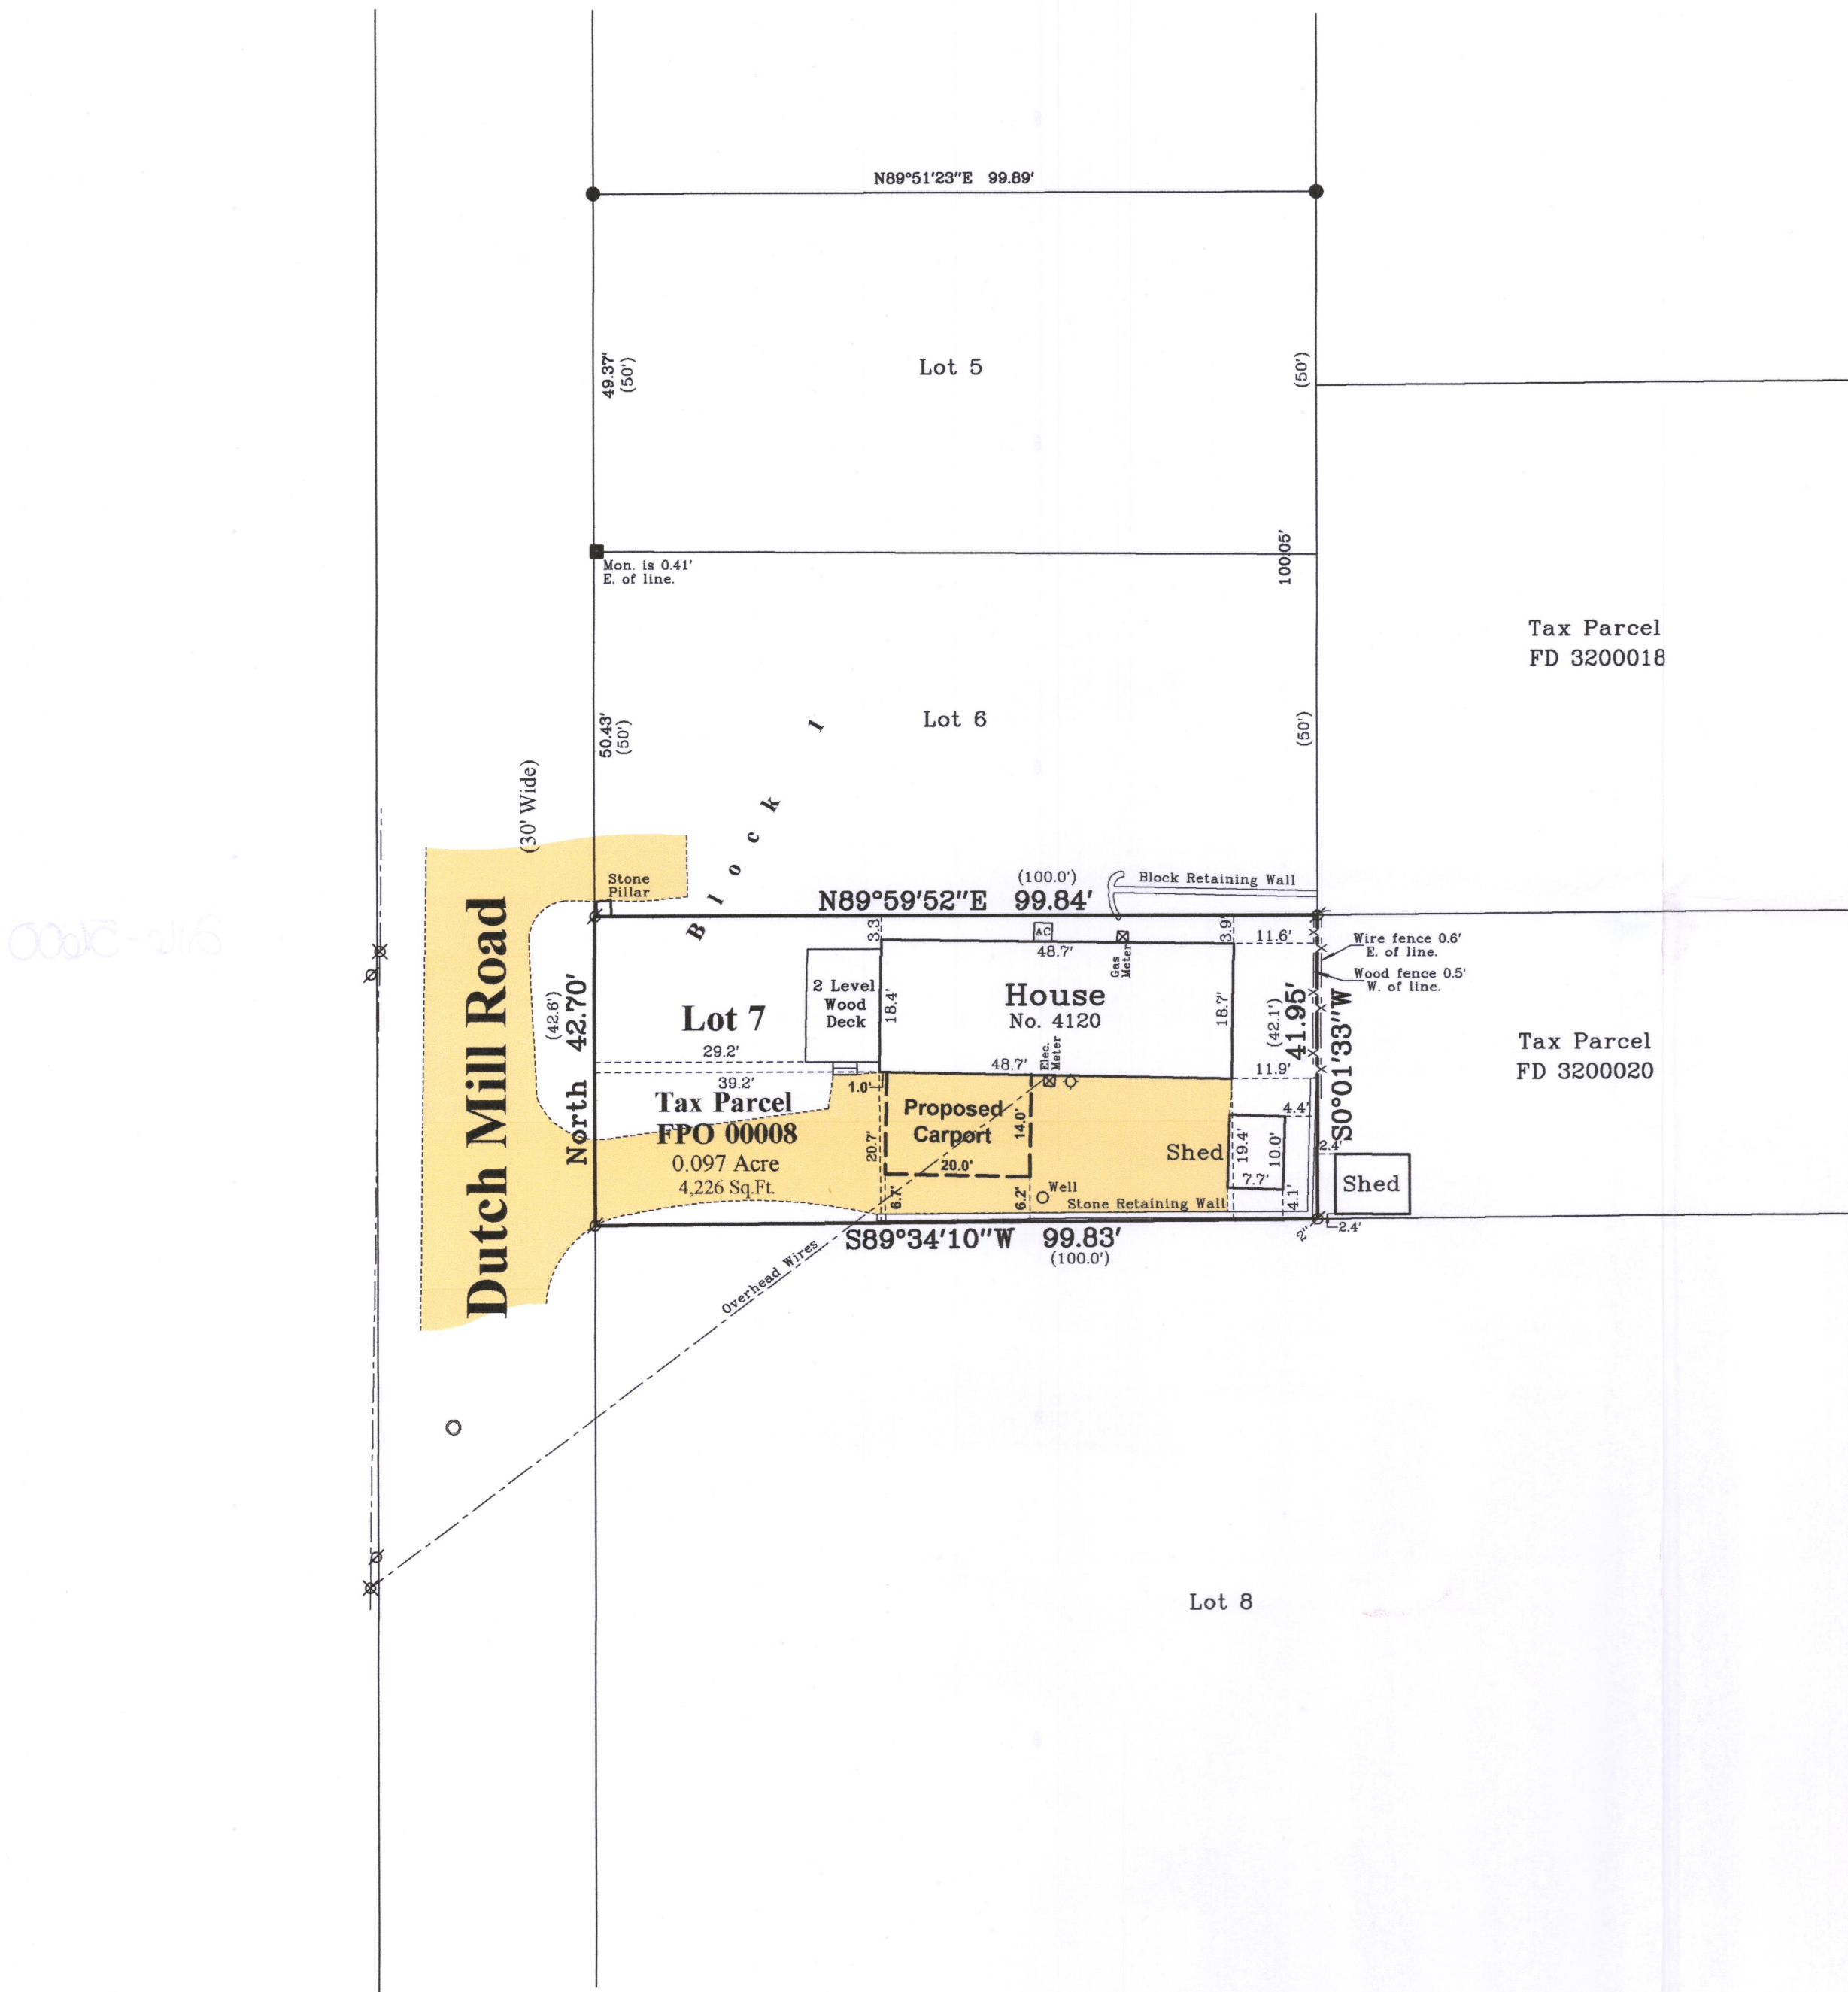

Plat of Survey

of


Lot 7 in Block 1 of Potter's Subdivision,

located in Government Lot 3 in the Southwest 1/4 of Section 32, Town 2 North, Range 16 East, Town of Delavan, Walworth County, Wisconsin.

Surveyed for: **Nancy LaCursia**
4120 Dutch Mill Lane
Delavan, Wisconsin. 53115




Bearings reference to the plat of Potter's Subdivision.

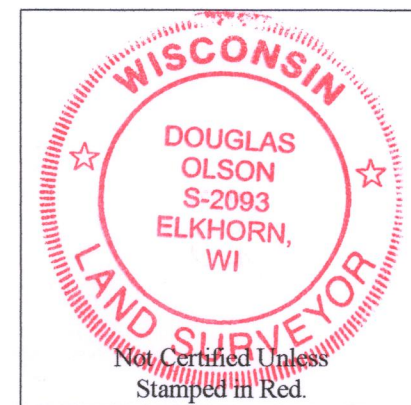

Notes:

- 1) This Plat of Survey is not certified unless signed and sealed in red ink.
- 2) This survey is subject to Wisconsin lien laws. This Plat of Survey is the notice of intent to file lien. Lien waiver required.
- 3) The Survey Date shown on this Plat of Survey is the completion date of the field work.

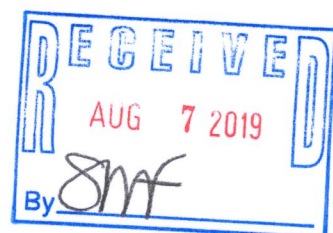

Copyright ©2019 by Olson Land Surveying, LLC.


All rights reserved. No part of this survey plat may be reproduced or transmitted in any form by any means - graphic, electronic, or mechanical, including photocopying, tracing, or information storage and retrieval systems - without permission in writing from Douglas G. Olson, Olson Land Surveying, LLC.

I hereby certify that I have surveyed the above described property in compliance with Chapter A-E 7 of the Wisconsin Administrative Code and that the map hereon is correct to the best of my professional knowledge and belief and shows the size and location of the property, its exterior boundaries, the location and dimensions of all visible structures thereon, boundary fences, apparent easements and roadways and visible encroachments, if any.

This survey is made for the exclusive use of the present owners of the property, and also those who purchase, mortgage or guarantee title thereto, within one year from the date hereof.

Douglas G. Olson
Wisconsin Professional Land Surveyor - 2093

Survey Date: July 2, 2019.
Revisions: No. 1 - Proposed Carport

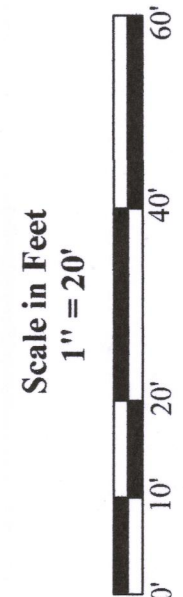

45 South Wisconsin Street | P.O. Box 322
Elkhorn, Wisconsin. 53121
Telephone: (262) 723-3434
Facsimile: (262) 723-8044
Email: doug@olsonsurveying.com
Website: www.olsonsurveying.com



Legend of Symbols & Abbreviations		N	North
	Found Concrete Monument	S <th>South</th>	South
⊗	Found Iron Pipe	E <th>East</th>	East
⊙	Found Iron Rod	W <th>West</th>	West
⊗	Recorded Information	In	In Bearings
⊗	Utility Pole	°	Degrees
⊗	Utility Pedestal	"	Minutes
⊗	Manhole	"	Seconds
⊗	Gravel Surface	In	In Distances
		Feet	Feet
		"	Inches

Sheet 1 of 1 Sheets	Job Reference Number
Drawing Name	2019.090
2019.090	