


LEGAL DESCRIPTION

LOCATED IN THE SOUTHEAST 1/4 OF THE SOUTHWEST 1/4, SECTION 29,
TOWNSHIP 2 NORTH, RANGE 16 EAST, IN THE TOWN OF DELEVAN,
WALWORTH COUNTY, WISCONSIN

UNIT 3 OF WINDWARD HILLS CONDOMINIUM

PLAT OF SURVEY

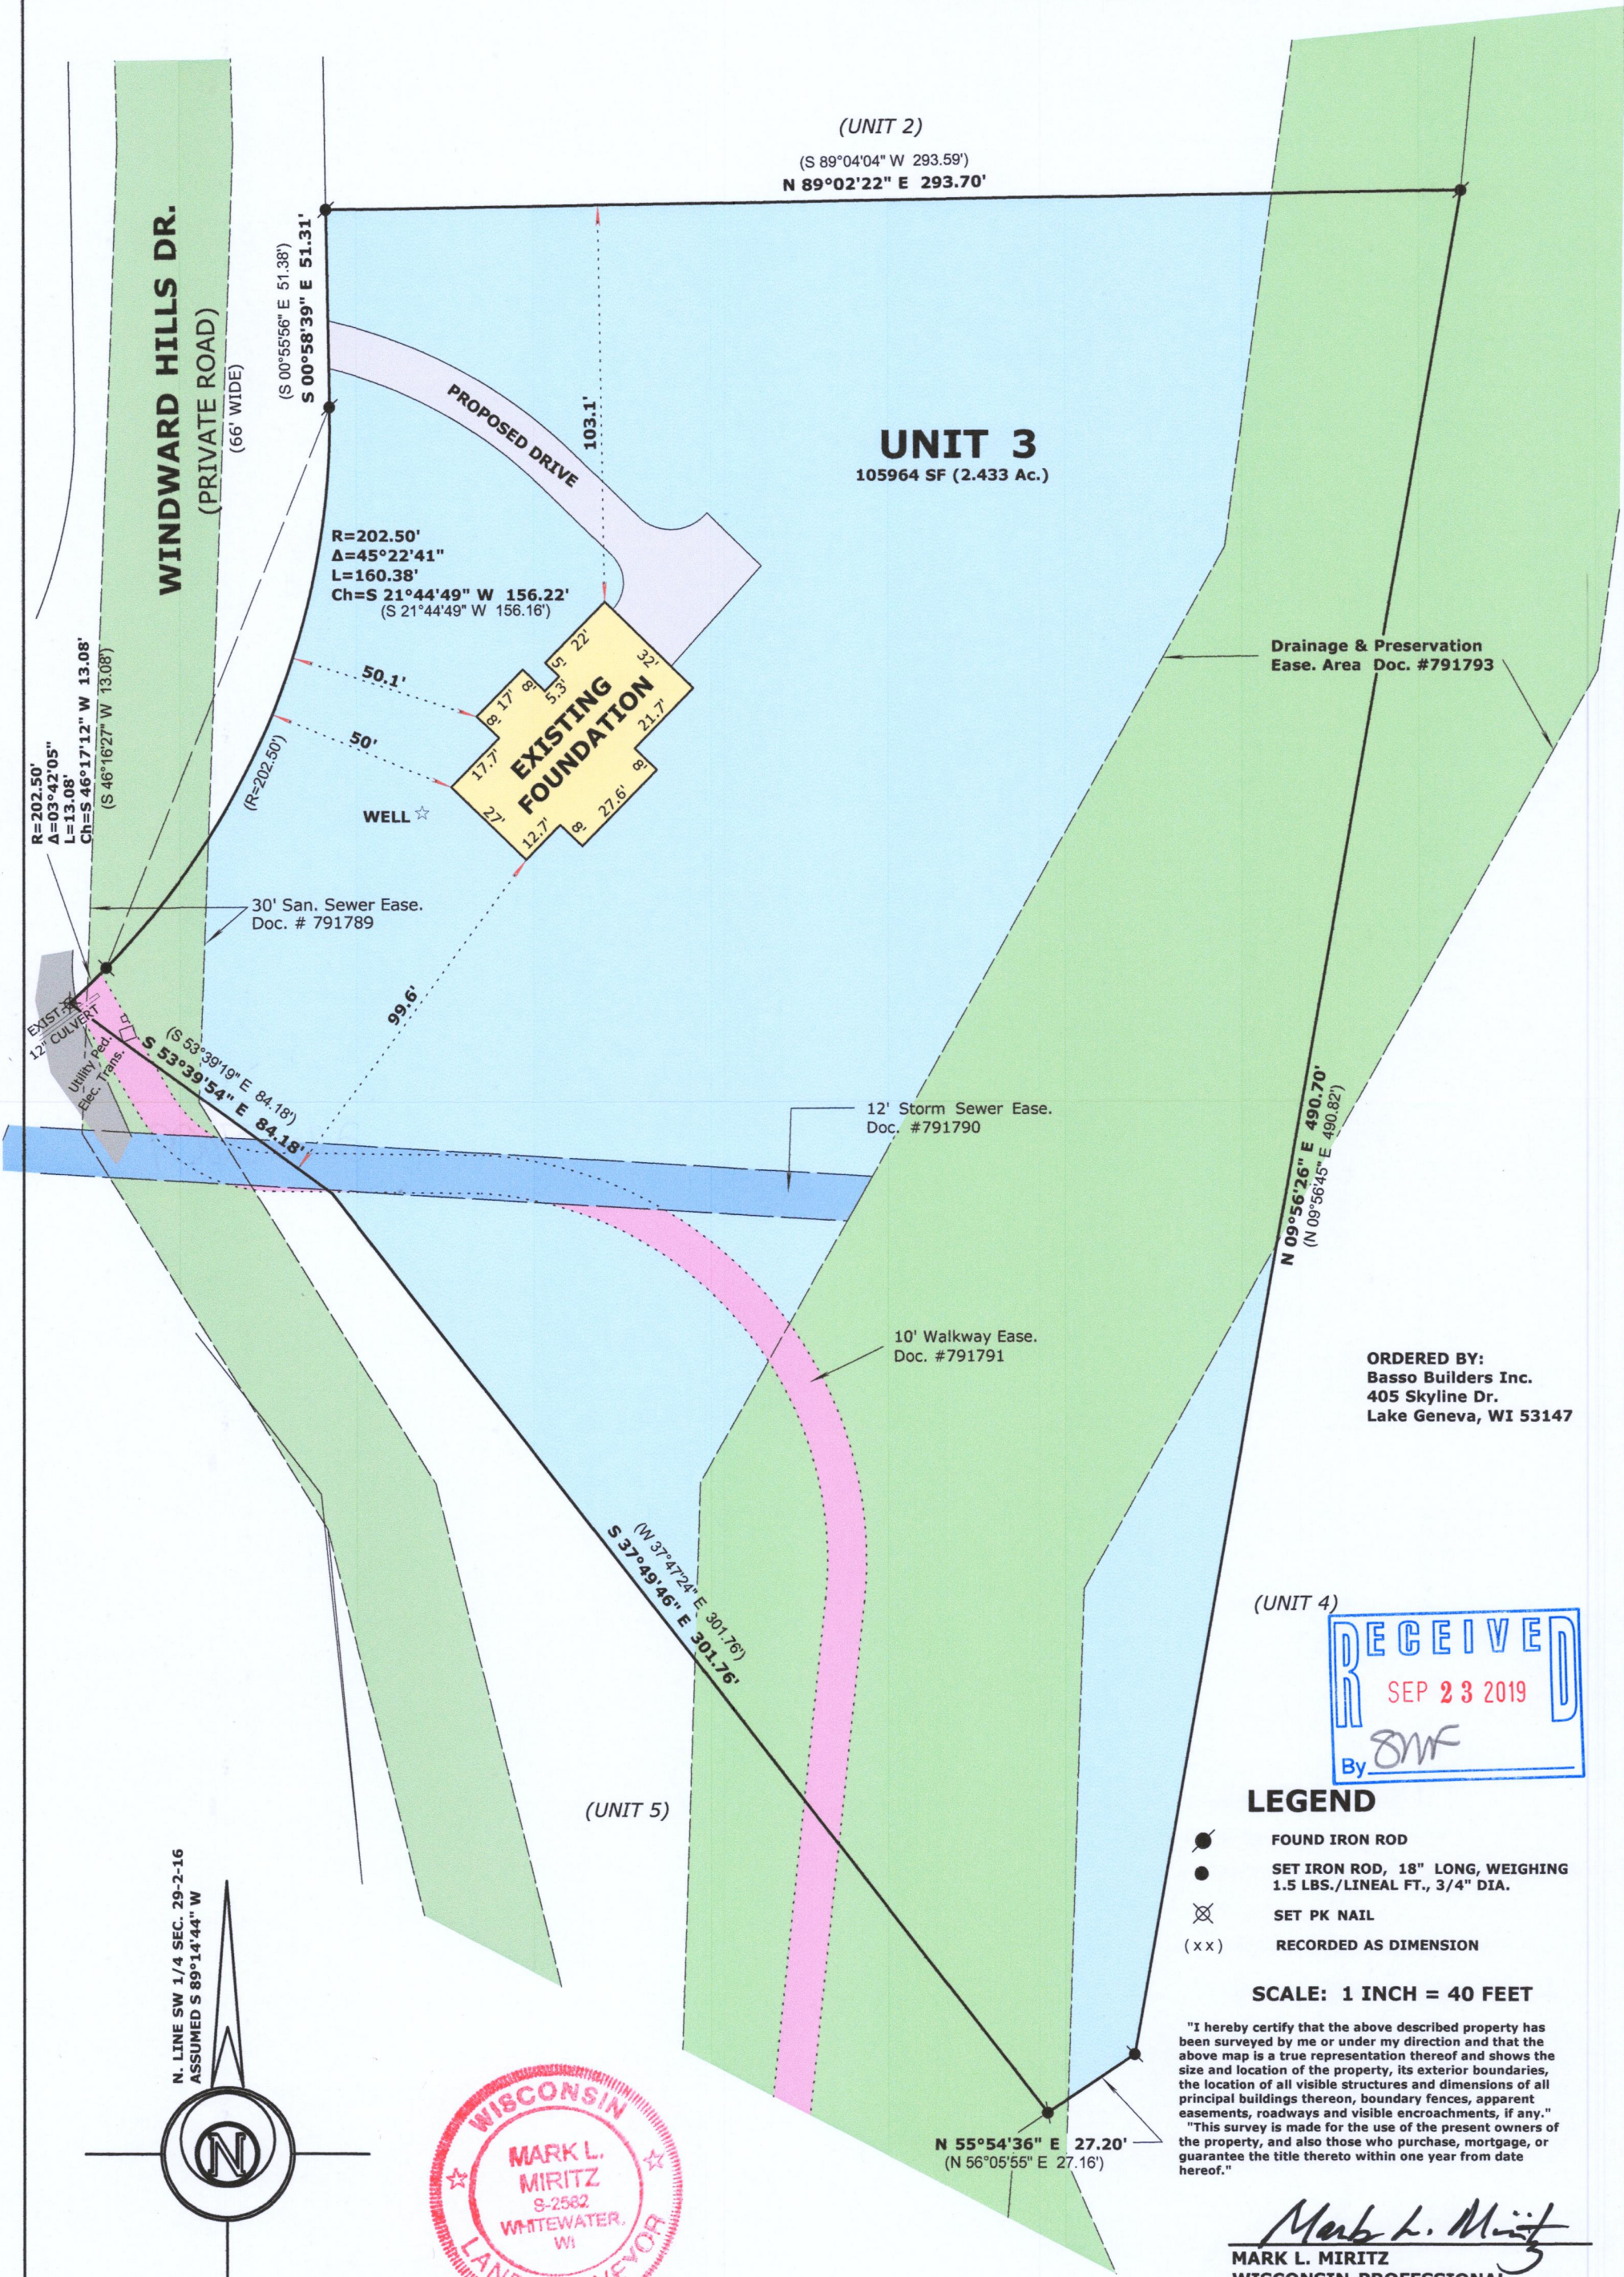

ORDERED BY:
Basso Builders Inc.
405 Skyline Dr.
Lake Geneva, WI 53147

REVISED SEPT. 21, 2019 TO
SHOW FOUNDATION "AS BUILT"

DATE: January 24, 2019 JOB NO. 19.705

FWIND-3

216-5009