


Plat of Survey

of

Lot 34 in Block 17 of Delavan Lake-View Crest,
a subdivision located in the Northwest 1/4 of the Northeast 1/4 of Section 31, Town
2 North, Range 16 East, Town of Delavan, Walworth County, Wisconsin.


Surveyed for: **R & D Builders**
3116 Royal Oaks Drive
Elkhorn, Wisconsin. 53121

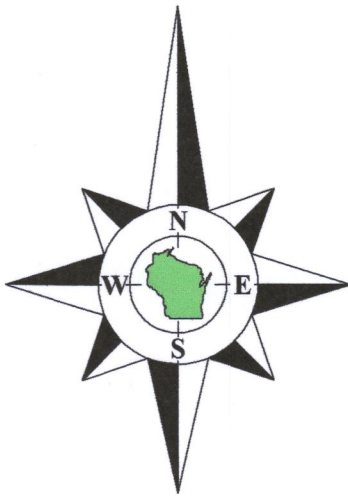

Bearings referenced to the North line of
Highland Drive, recorded as N65°36'E
on the plat of Delavan Lake-View Crest.



- Notes:
- 1) This Plat of Survey is not certified unless signed and sealed in red ink.
 - 2) This survey is subject to Wisconsin lien laws. This Plat of Survey is the notice of intent to file lien. Lien waiver required.
 - 3) The Survey Date shown on this Plat of Survey is the completion date of the field work.

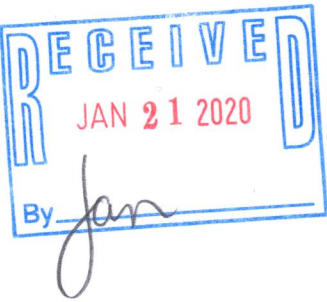


Copyright © 2019 by Olson Land Surveying, LLC.

All rights reserved. No part of this survey plat may be reproduced or transmitted in any form by any means - graphic, electronic, or mechanical, including photocopying, tracing, or information storage and retrieval systems - without permission in writing from Douglas G. Olson, Olson Land Surveying, LLC.

I hereby certify that I have surveyed the above described property in compliance with Chapter A-E 7 of the Wisconsin Administrative Code and that the map hereon is correct to the best of my professional knowledge and belief and shows the size and location of the property, its exterior boundaries, the location and dimensions of all visible structures thereon, boundary fences, apparent easements and roadways and visible encroachments, if any.

This survey is made for the exclusive use of the present owners of the property, and also those who purchase, mortgage or guarantee title thereto, within one year from the date hereof.

Douglas G. Olson
Wisconsin Professional Land Surveyor - 2093

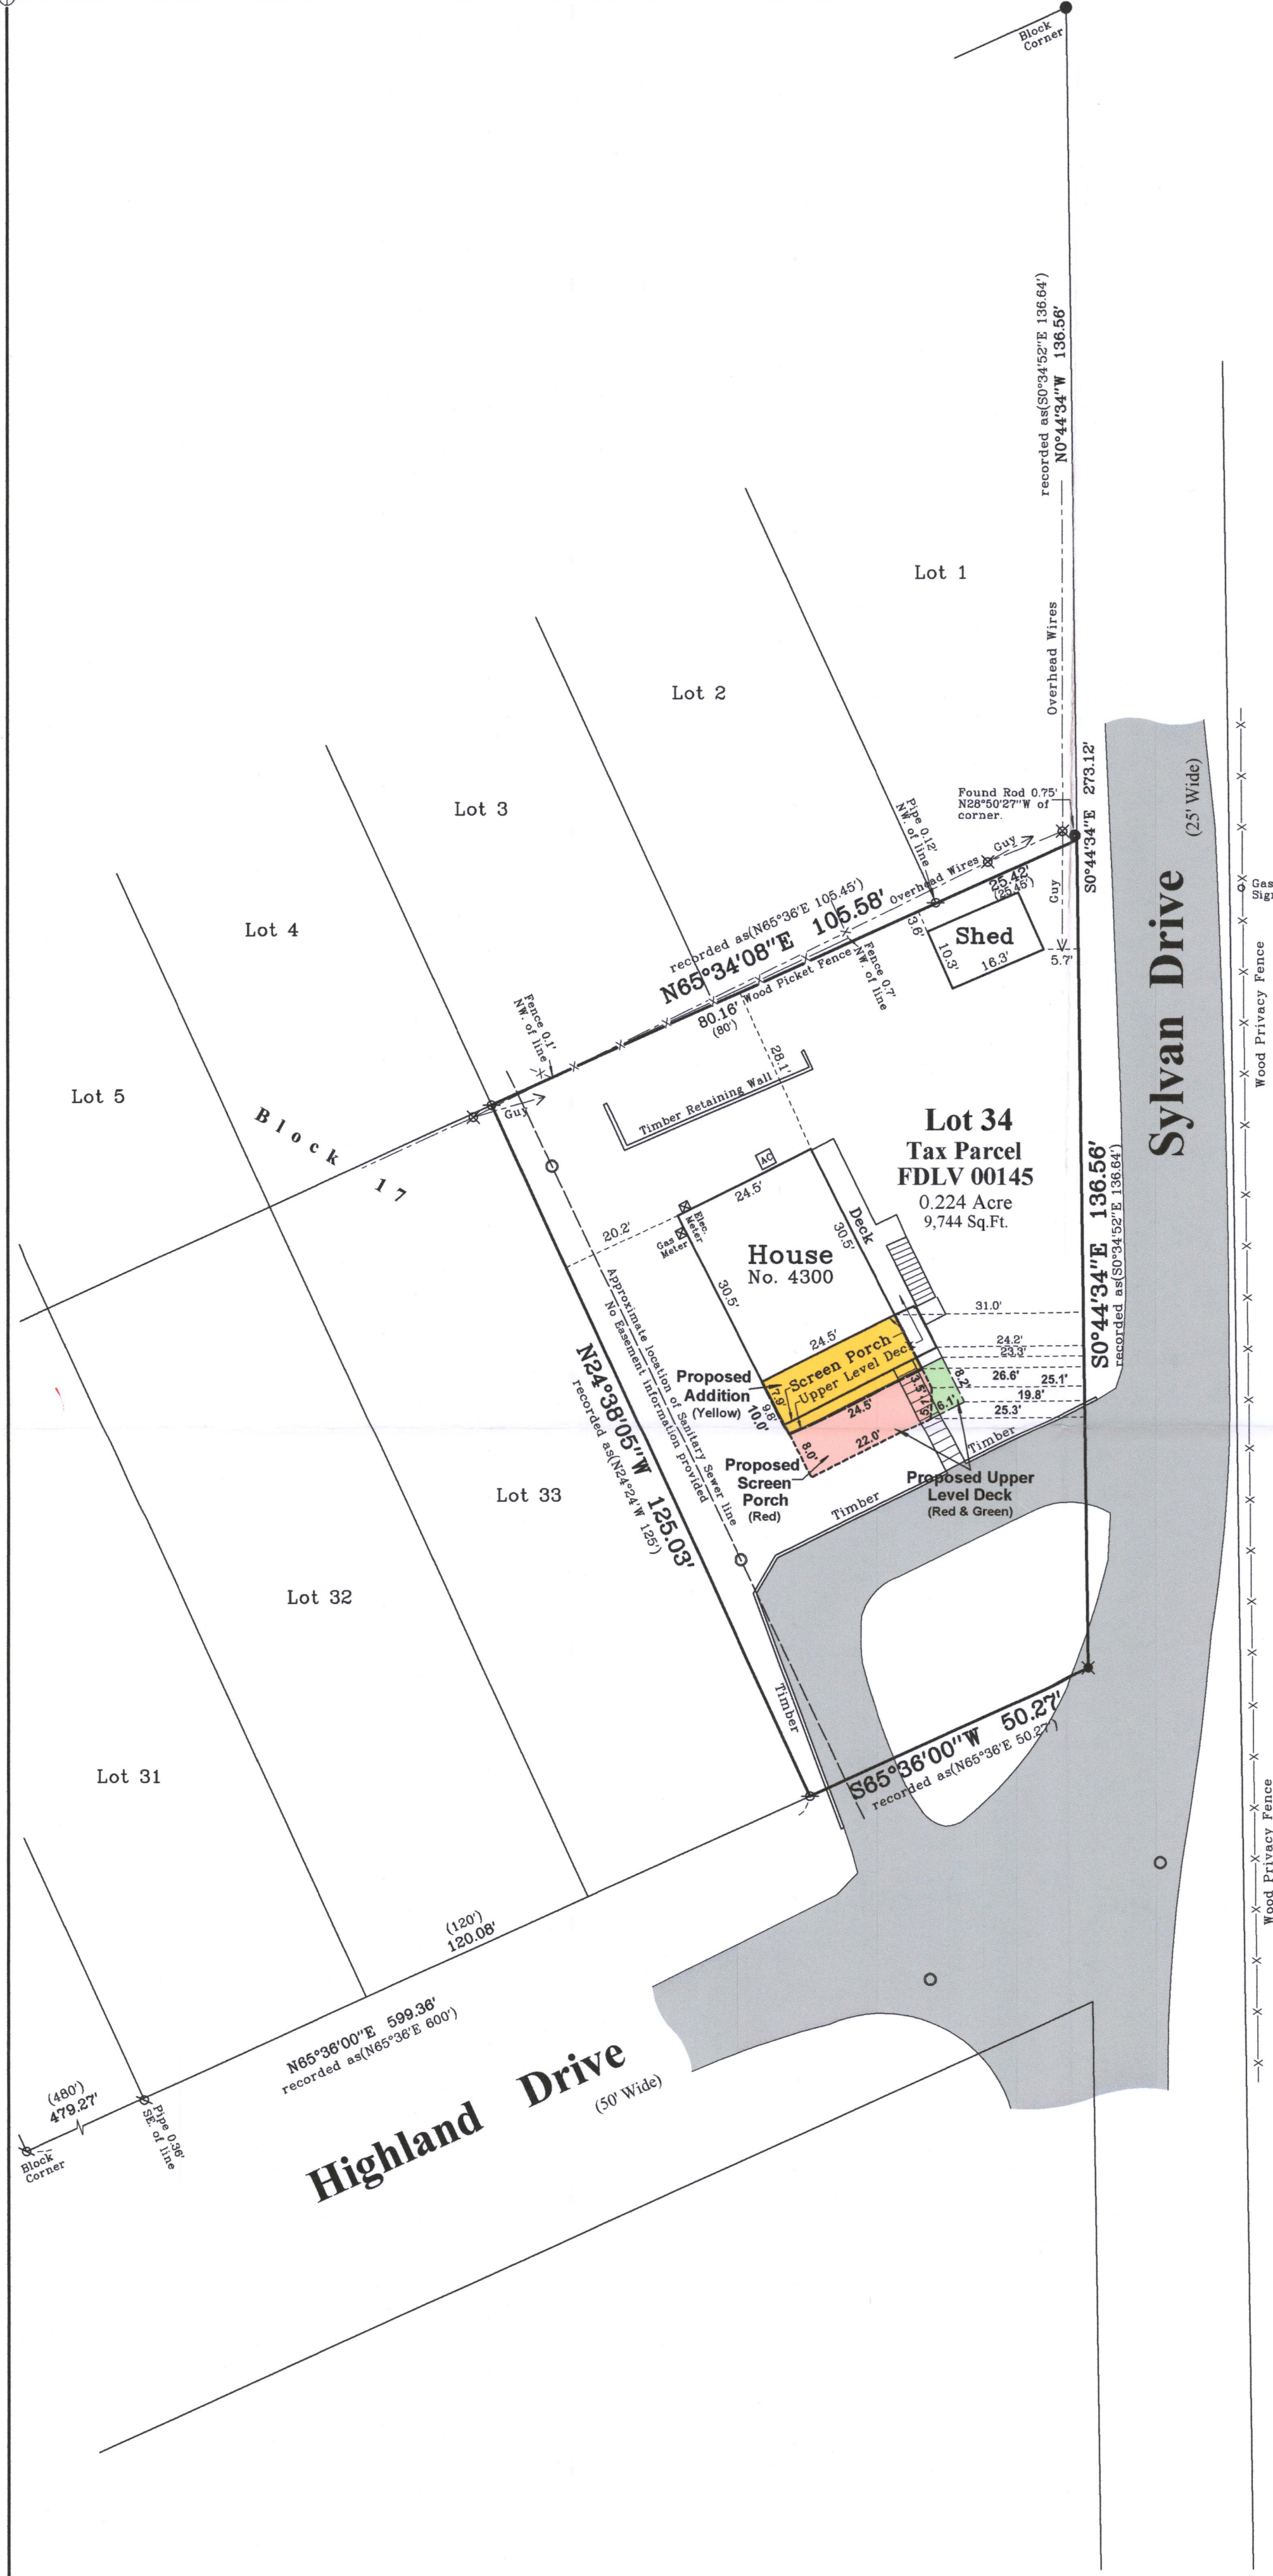

2019.097

Sheet 1 of 1 Sheets

Drawing Name:

Job Reference Number

2019.097

Legend of Symbols & Abbreviations

Found Iron Pipe

Found Iron Rod

Set Mag Nail

Recorded Information

Utility Pole

Utility Pedestal

Manhole

Asphalt Surface

Concrete Surface

N North

S South

E East

W West

In Bearings

Degrees

Minutes

Seconds

In Distances

Feet

Inches

OLSON

LAND SURVEYING, LLC

Rural | Residential | Commercial

45 South Wisconsin Street | P.O. Box 322

Elkhorn, Wisconsin. 53121

Telephone: (262) 723-3434

Facsimile: (262) 723-8044

Email: doug@olsonsurveying.com

Website: www.olsonsurveying.com

Scale in Feet

1" = 20'

0'

10'

20'

40'

60'

Survey Date: August 6, 2019.

Revisions: No. 1 - Proposed Addition, Screen Porch & Deck

FdLV-145 216-5645