


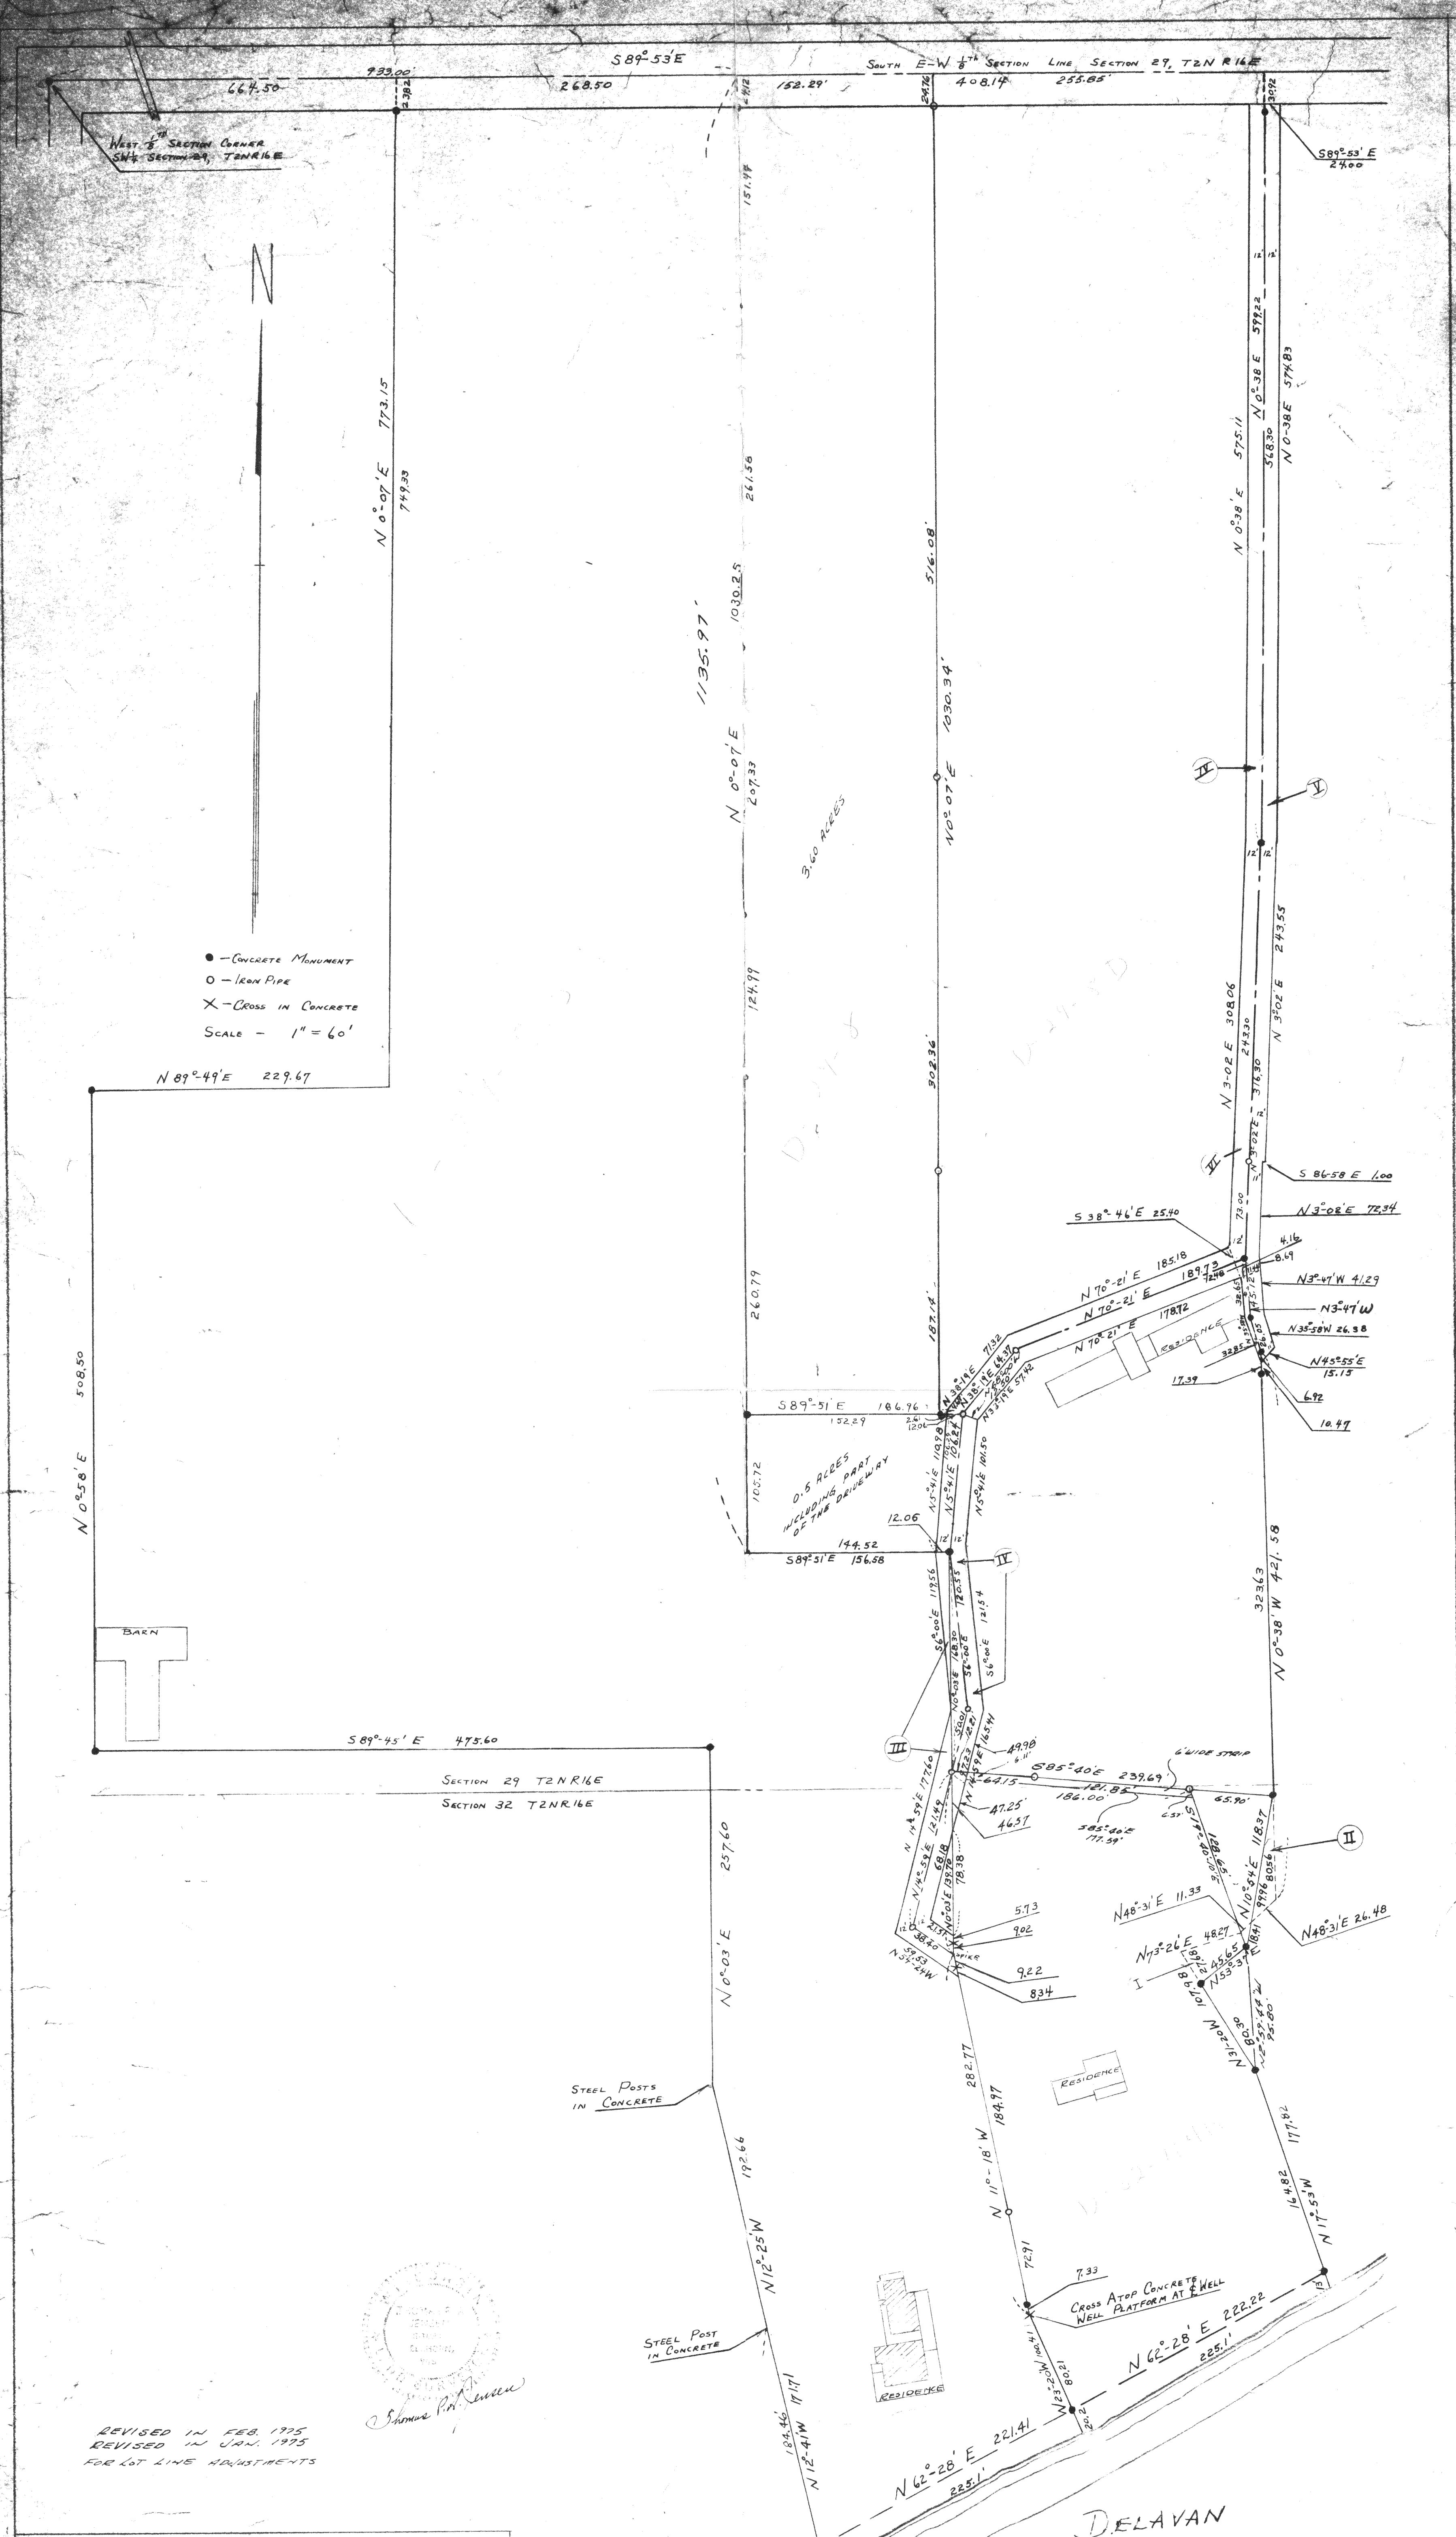

REVISED IN FEB. 1975
REVISED IN JAN. 1975
FOR LOT LINE ADJUSTMENTS

PLAT OF SURVEY
OF LAND LOCATED IN THE
SW FR 1/4 OF SECTION 29
AND THE
NW FR 1/4 OF SECTION 32
T2N R16E, WALWORTH COUNTY, WISCONSIN
DECEMBER 1954
Lloyd Jensen
SURVEYOR

D-29-8
8B
8D
and D-32-N4B (Now C.L. 1013)

216-122
216-566