


213/70

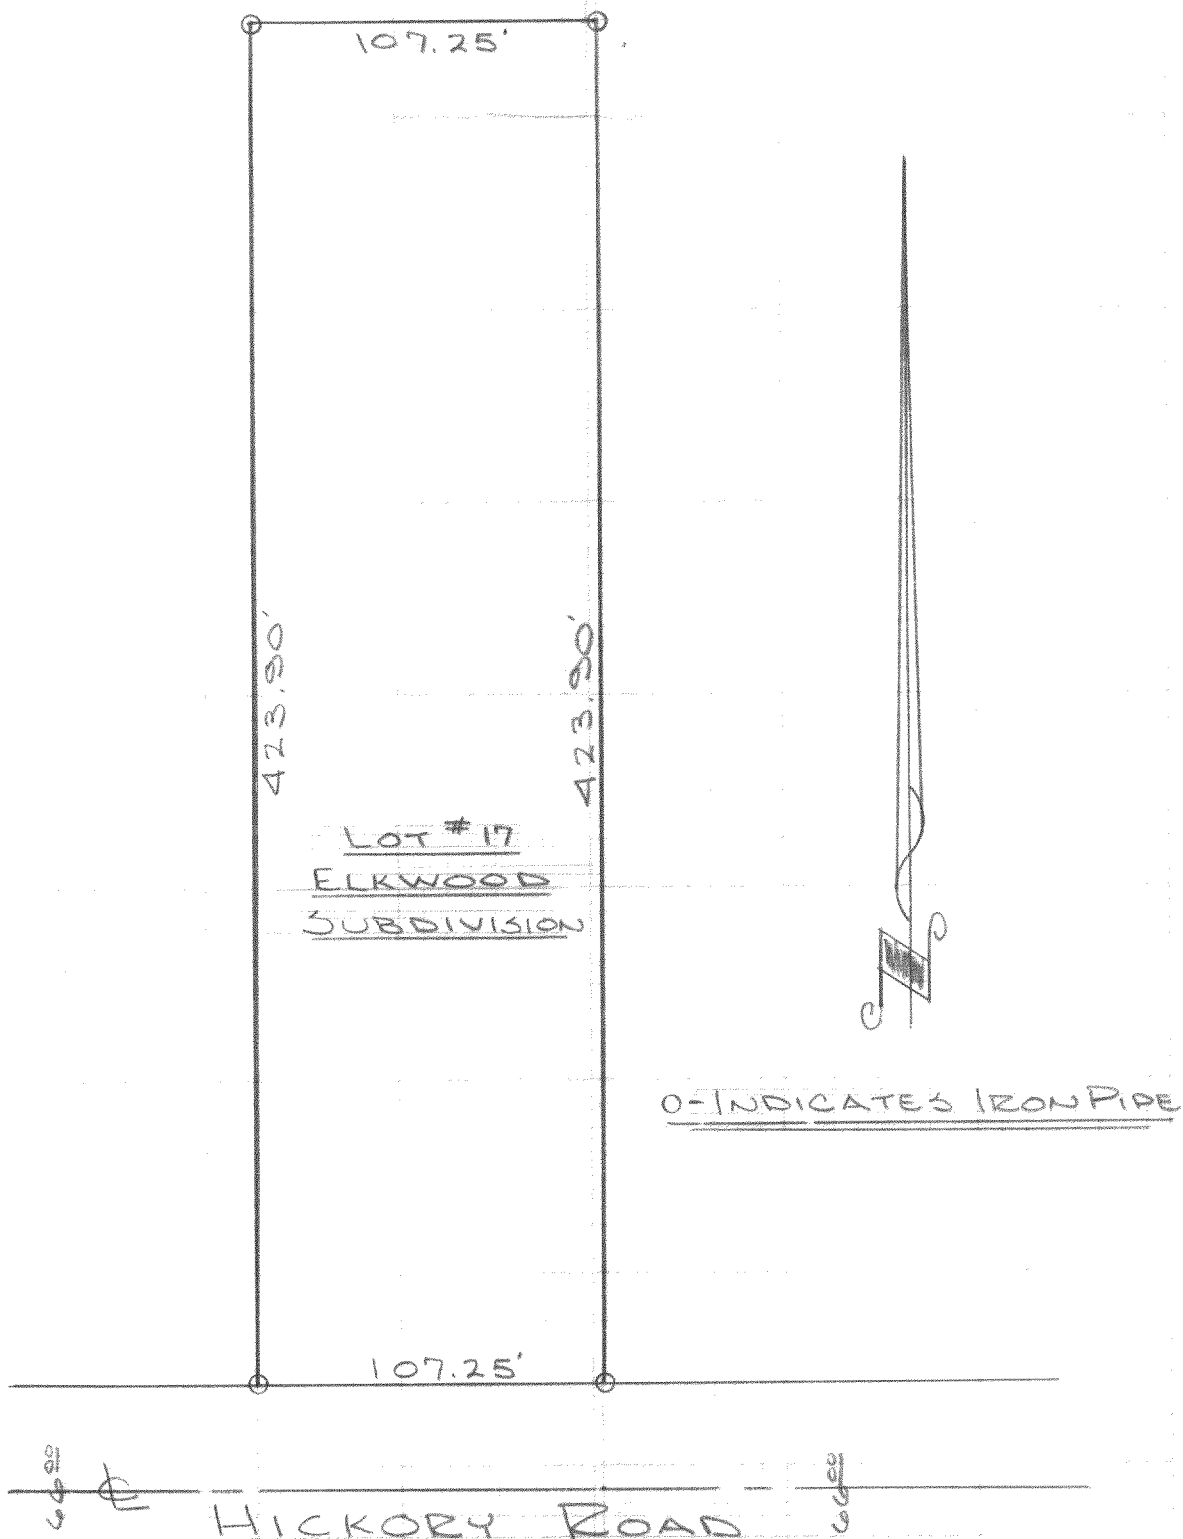

DESCRIPTION: Lot #17 Elkwood Subdivision of a portion of the northeast quarter of the northeast quarter of Section 13, Town 2 north range 16 east, Delavan Township, Walworth County, Wisconsin.

CERTIFICATE: I, James F. Biagi surveyor hereby certify that I have surveyed the property hereon described.

James F. Biagi
James F. Biagi, RLS #272
Elkhorn, Wisconsin.

Date: October 23rd 1970.

Lot 17 rd. Subd

216-56B