

Plat of Survey


of

The North 3/5 of Lot 9, Lots 10 and 11, and the East 2/5 of Lot 12 in Block P of Delavan Lake Assembly Grounds,

a subdivision located in the Northeast 1/4 and the Southeast 1/4 of Section 21, Town 2 North, Range 16 East, Town of Delavan, Walworth County, Wisconsin.

Surveyed for: **Robert & Kathy O'Brien**



13726 South 88th Avenue
Orland Park, Illinois, 60462

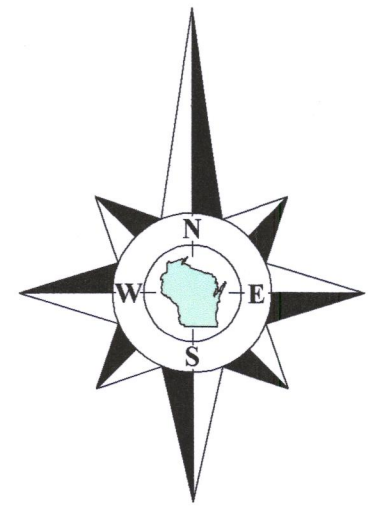

Bearings reference to the Wisconsin State Plane Coordinate System, South Zone.

* Note A:

Curved street lines are not adequately dimensioned on the plat of Delavan Lake Assembly Grounds. Lines are shown as scaled from the recorded plat.

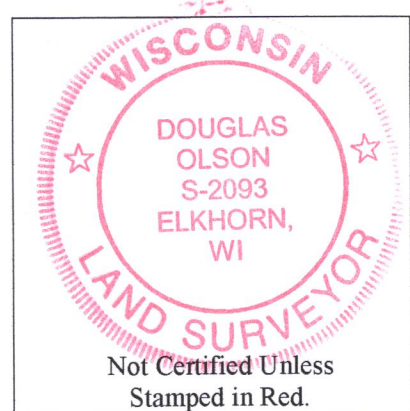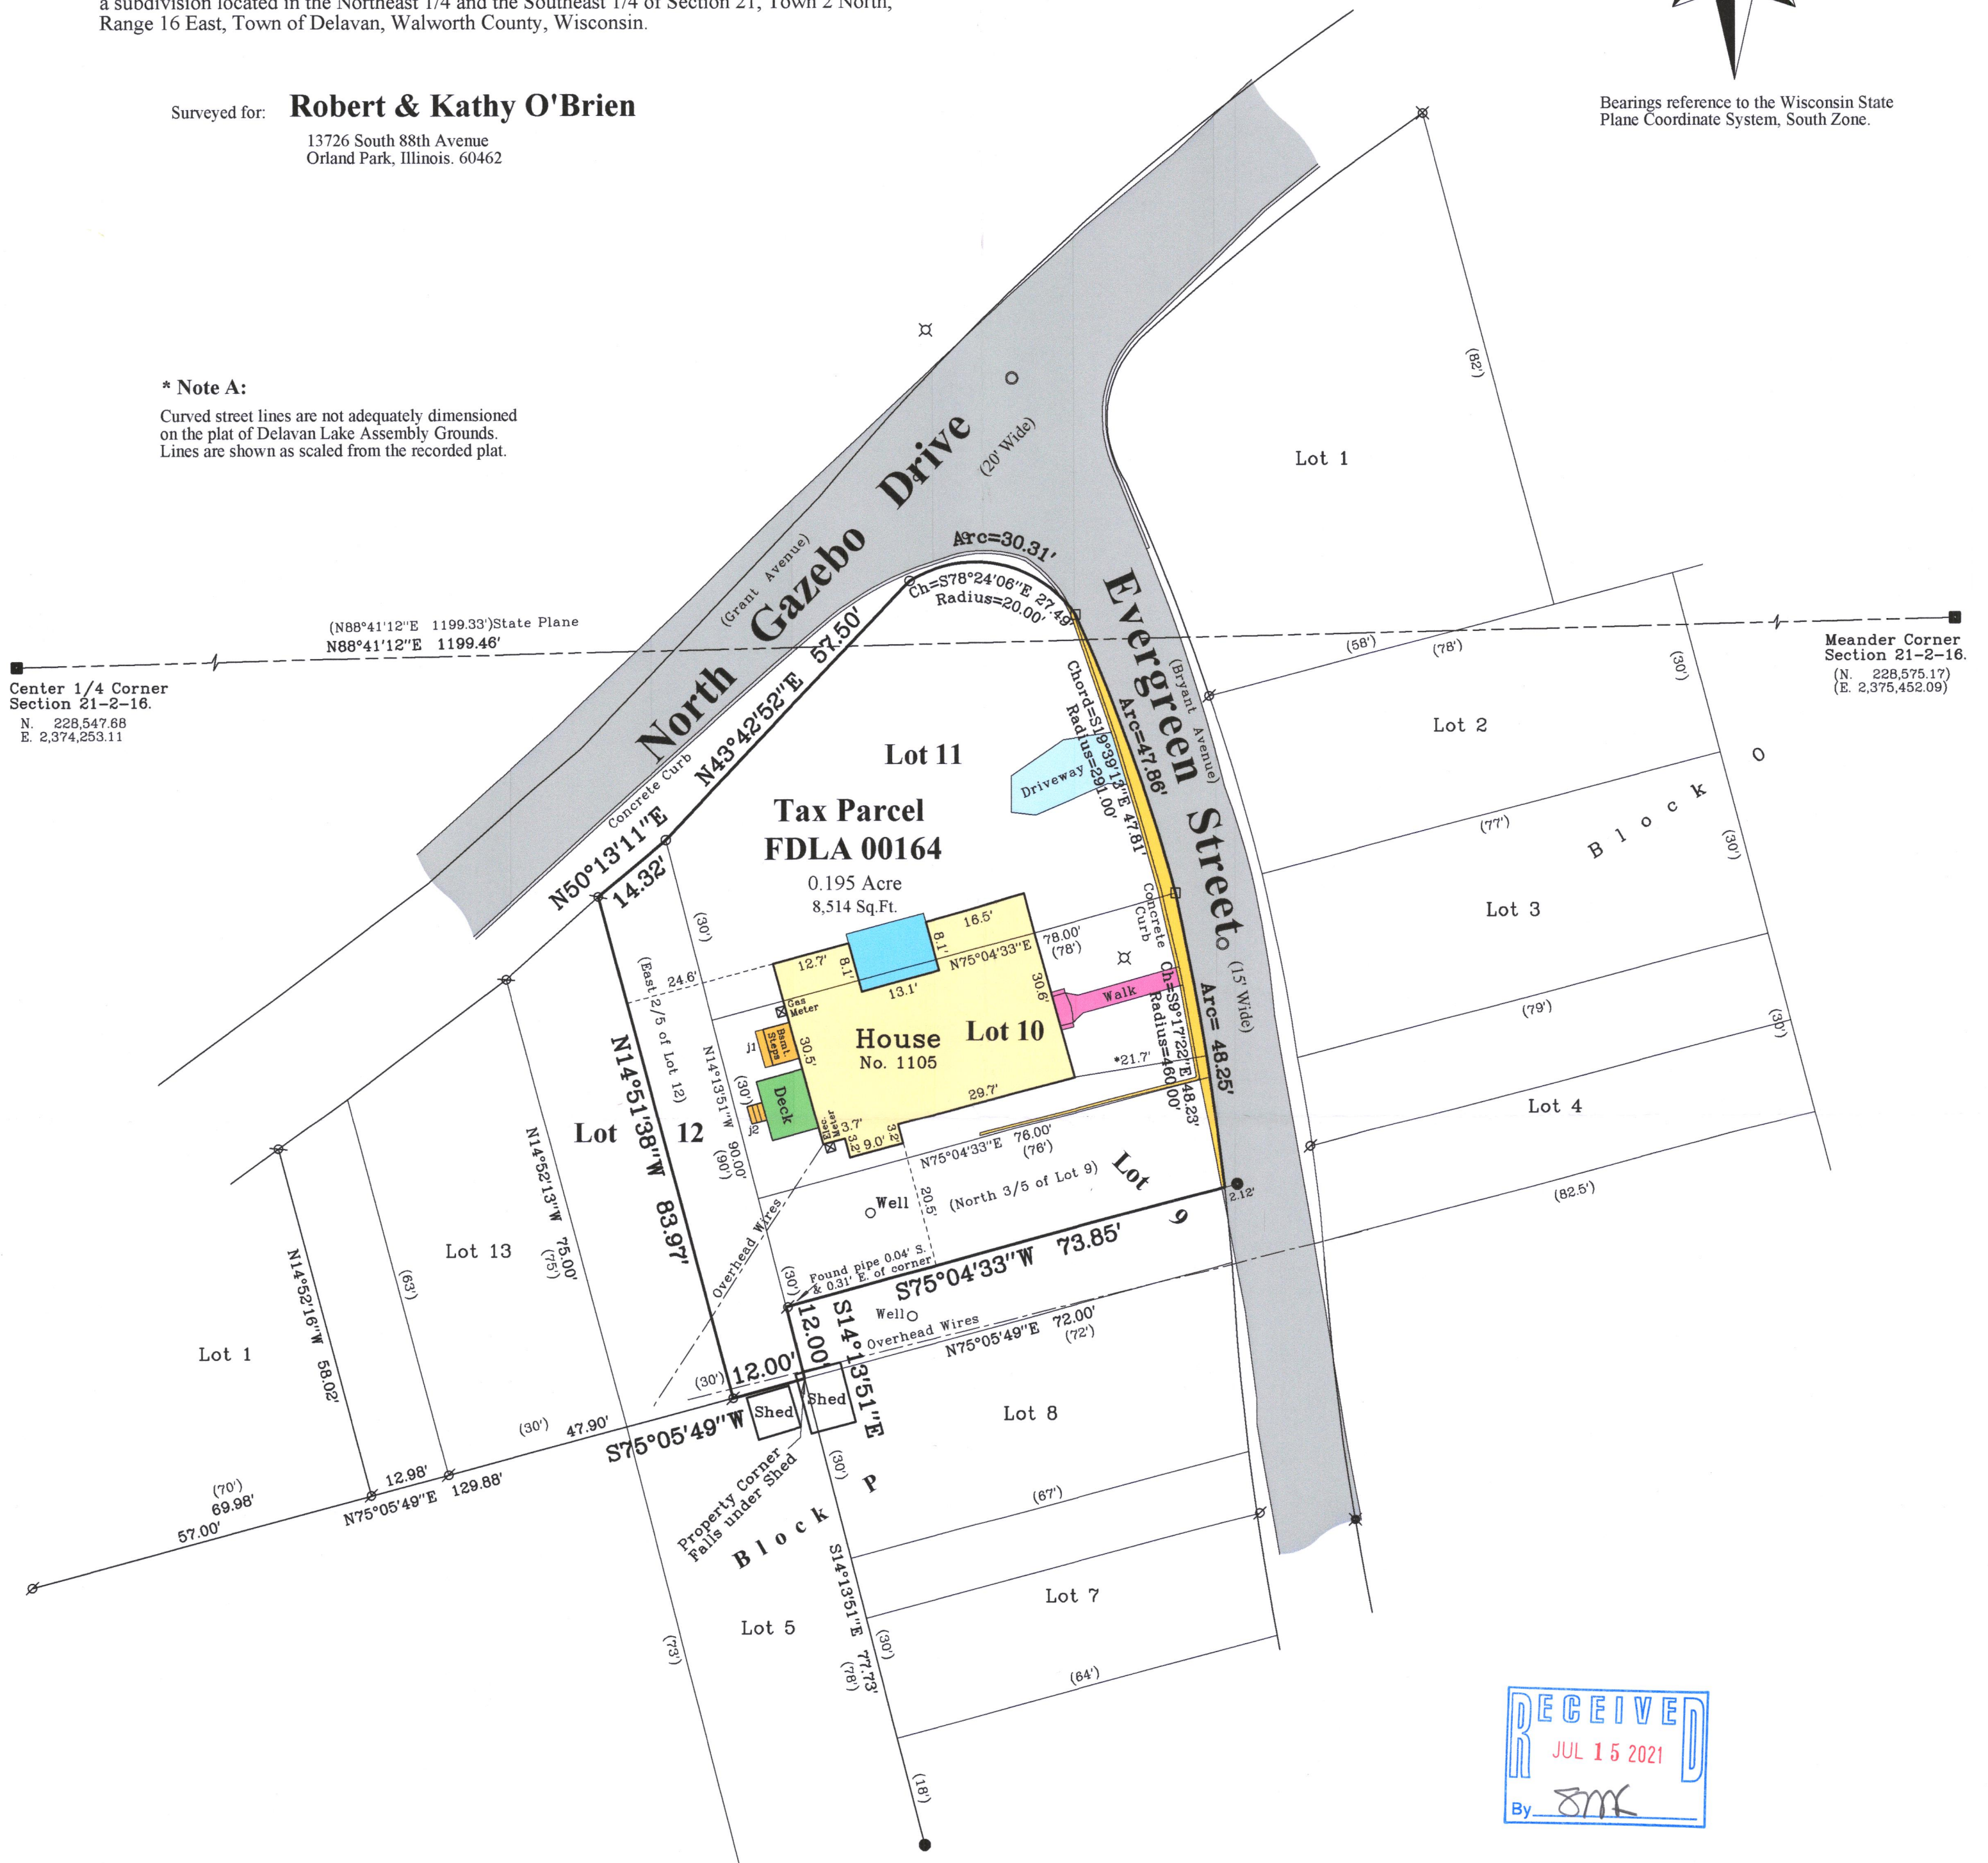

Notes:

- This survey plat is not certified unless signed and sealed in red ink.
- This survey is subject to Wisconsin lien laws. This Plat of Survey is the notice of intent to file lien. Lien waiver required.

Tax Parcel FDLA 00164

Impervious Surface	Pre-Const.	Post-Const.
a. Dwelling	1,214 sq.ft.	0 sq.ft.
b. Garage	0 sq.ft.	0 sq.ft.
c. Acc. Struc. 1	0 sq.ft.	0 sq.ft.
d. Acc. Struc. 2	0 sq.ft.	0 sq.ft.
e. Acc. Struc. 3	0 sq.ft.	0 sq.ft.
f. Acc. Struc. 4	0 sq.ft.	0 sq.ft.
g. Acc. Struc. 5	0 sq.ft.	0 sq.ft.
h. Driveway(s)	157 sq.ft.	0 sq.ft.
i. Sidewalk(s)	71 sq.ft.	0 sq.ft.
j. Stairway(s) j1 & j2	42 sq.ft.	0 sq.ft.
k. Patio(s)	125 sq.ft.	0 sq.ft.
l. Deck(s)	77 sq.ft.	0 sq.ft.
m. Misc. Struc.	204 sq.ft.	0 sq.ft.
TOTAL	1,890 sq.ft.	0 sq.ft.
TOTAL SITE AREA	8,514 sq.ft.	8,514 sq.ft.
PERCENTAGE	22%	n.a.

Copyright 2012 by Jensen & Olson Land Surveying, LLC.

All rights reserved. No part of this survey plat may be reproduced or transmitted in any form by any means - graphic, electronic, or mechanical, including photocopying, tracing, or information storage and retrieval systems - without permission in writing from Douglas G. Olson, Jensen & Olson Land Surveying, LLC.

I, Douglas G. Olson, Wisconsin Registered Land Surveyor, do hereby certify that this survey was performed by me, or under my direction in full compliance with the owner's/agent's instructions and Chapter A-E 7 of the Wisconsin Administrative Code "Minimum Standards for Property Surveys"; and that this map is an accurate representation thereof to the best of my knowledge and belief.

Douglas G. Olson
Wisconsin Registered Land Surveyor - 2093

Sheet 1 of 1 Sheets

Drawing Name:

Job Reference Number

2020.162

Legend of Symbols & Abbreviations

Found County Section Corner	Found Iron Pipe	Found Iron Rod	Found Railroad Spike	Found 60d Spike	Recorded Information	Utility Pedestal	Manhole	Asphalt Surface	Concrete Surface	Lamp	Brick Pavers	Gravel
N North	S South	E East	W West	In Bearings	Degrees	Minutes	Seconds	In Distances	Feet	Inches		



45 South Wisconsin Street | P.O. Box 322
Elkhorn, Wisconsin, 53121
Telephone: (262) 723-3434
Facsimile: (262) 723-8044
Email: doug@olsonsurveying.com
Website: www.olsonsurveying.com

Scale in Feet
1" = 20'



Survey Date: June 19, 2012.
Revisions: No. 1 - Pre-Const. Impervious Surface Calculations

2020.162

FDLA-164

216-5790