


PLAT OF SURVEY LOT 8 OF LAKEWOOD ESTATES, A SUBDIVISION

LOCATED IN PART OF THE NE 1/4 OF THE SW 1/4
OF SECTION 21, TOWN 2 NORTH, RANGE 16 EAST,
TOWN OF DELAVAN, WALWORTH COUNTY, WISCONSIN

ASSIGNED SW LINE LOT 8
N 30°19'00" W

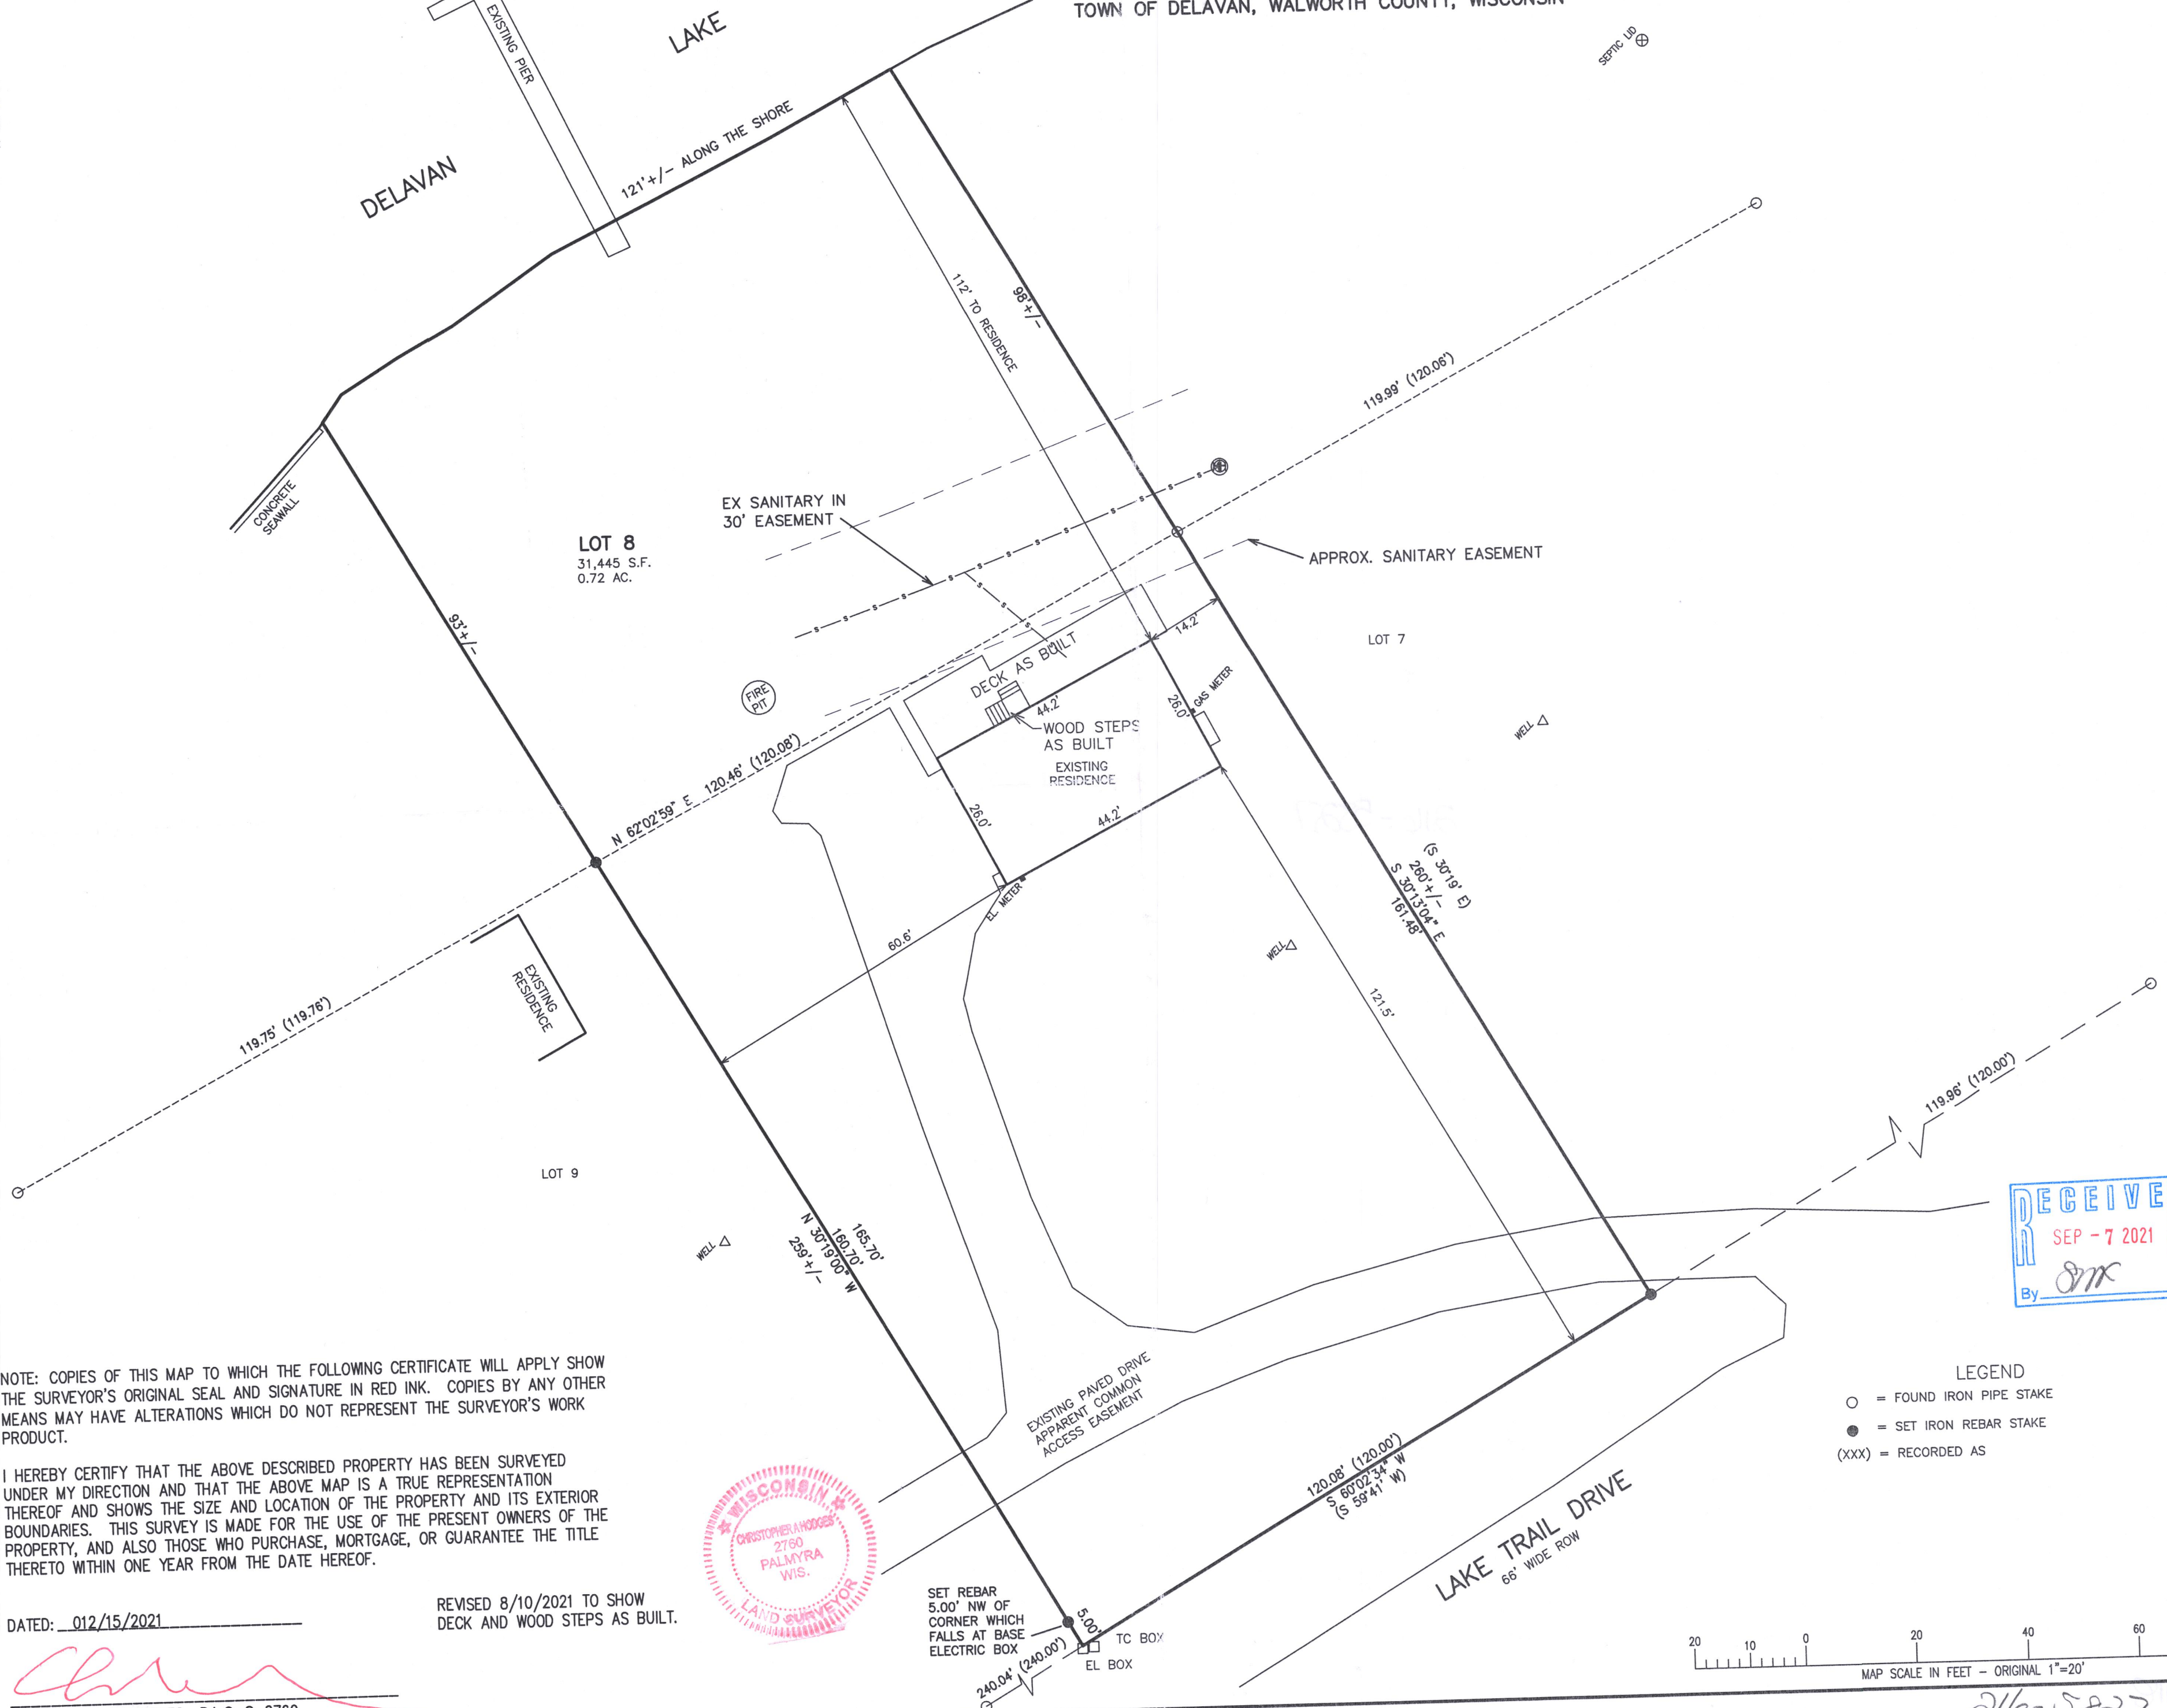

PLAT OF SURVEY
1820 LAKE TRAIL DRIVE
DELAVAN, WI 53115

WORK ORDERED BY -
JRD BUILDERS
N5951 COUNTY TRUNK DD
BURLINGTON, WI 53105

FARRIS, HANSEN & ASSOCIATES, INC.
ENGINEERING - ARCHITECTURE - SURVEYING
7 RIDGWAY COURT P.O. BOX 437
ELKHORN, WISCONSIN 53121
OFFICE: (262) 723-2098 FAX: (262) 723-5886

REVISIONS

10/28/2020	LB	PERMIT
01/27/2021	CAH	PORCH AND DECK OUTSIDE EASEMENT
02/15/2021	CAH	CANTILEVERED DECK

PROJECT NO.
9507.20
DATE:
05/03/2016
SHEET NO.
1 OF 1