


PLAT OF SURVEY

Lots 16, 17, 18, 19, and 20 in Block 1 of L. E. Robbins Subdivision, according to the recorded Plat thereof, Excepting the South 10.0 feet of Lot 16 in Block 1 of L. E. Robbins Subdivision, said land being in the Town of Delavan, Walworth County, Wisconsin.

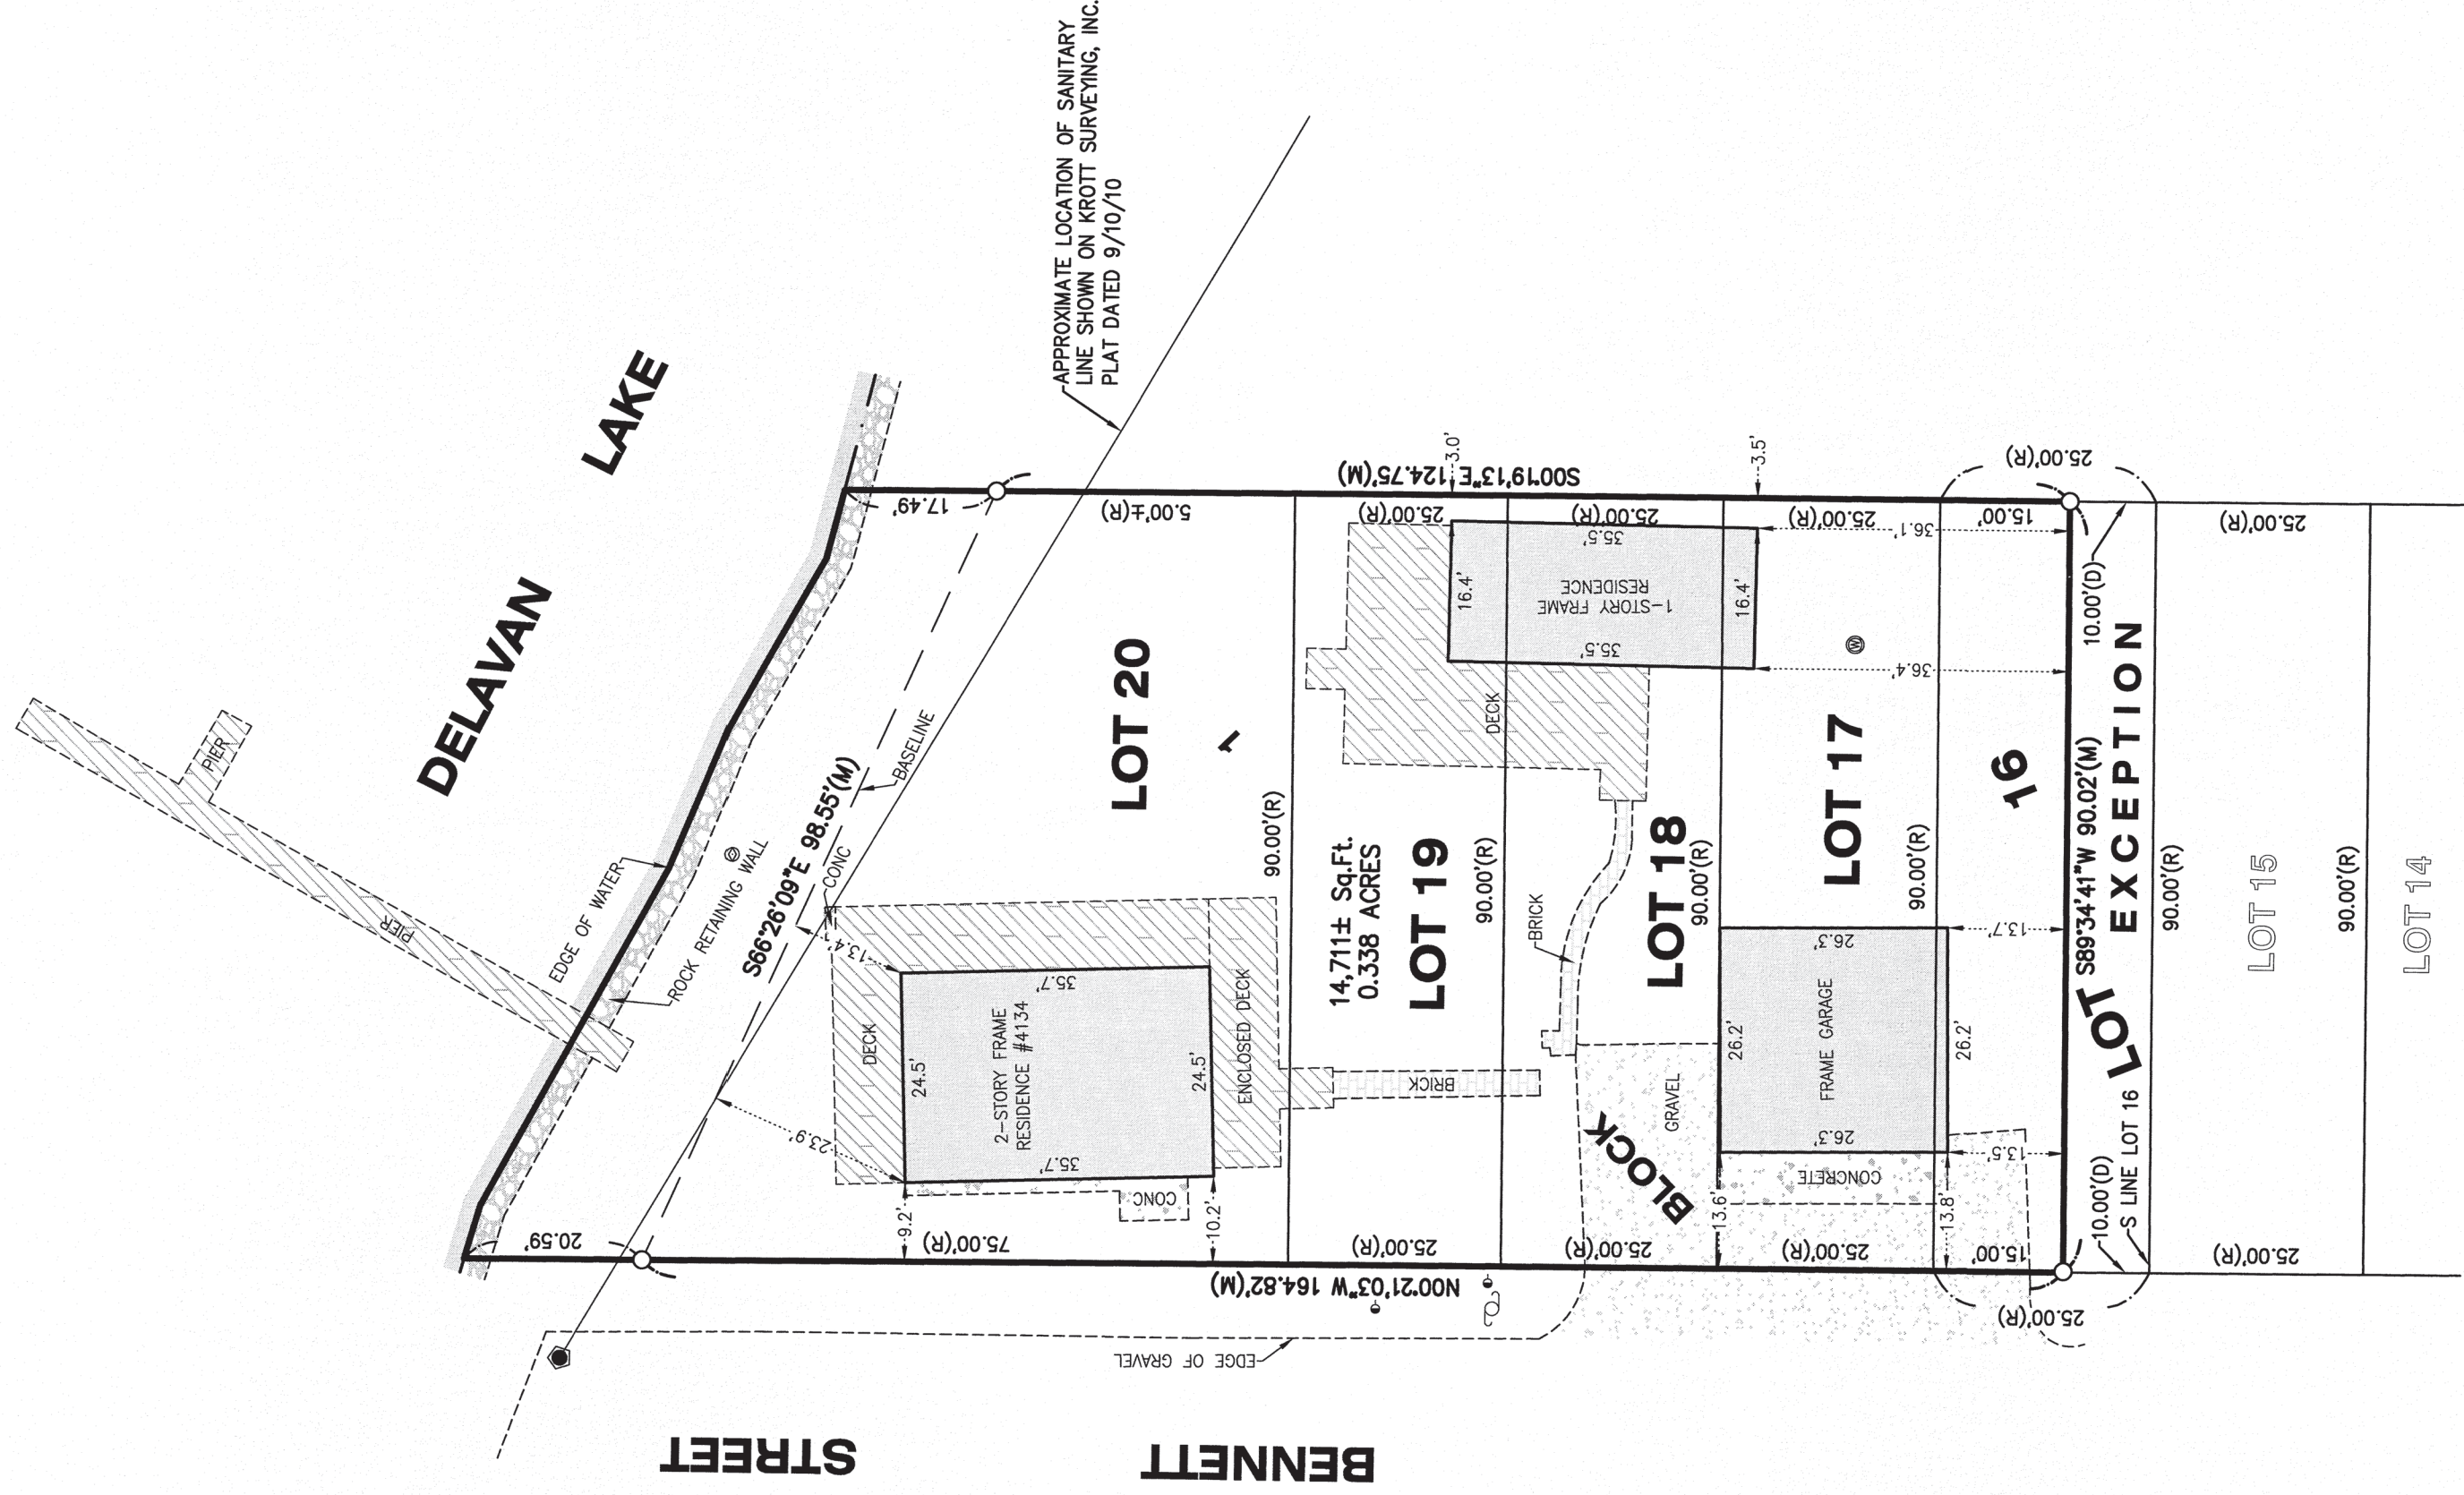

STATE OF ILLINOIS)
COUNTY OF McHENRY) S.S.

NOTE: Only those Building Line Restrictions or Easements shown on a Recorded Subdivision Plat are shown hereon unless the description ordered to be surveyed contains a proper description of the required building lines or easements.
* No distance should be assumed by scaling.
* No underground improvements have been located unless shown and noted.
* No representation as to ownership, use, or possession should be hereon implied.
* This Survey and Plat of Survey are void without original embossed or colored seal and signature affixed.

In my professional opinion, and based on my observations, I hereby certify that the above described property has been surveyed under my direction and that the above map is a true representation thereof and shows the size and location of all visible structures, and dimensions of all principle buildings thereon, boundary fences, apparent easements, roadways, and visible encroachments, if any. This survey is made for the use of the present owners of the property, and also those who purchase, mortgage, or guarantee the title thereto within one year from the date hereof.

Dated at Woodstock, McHenry County, Illinois 08/31 A.D., 20 21.
Vanderstappen Land Surveying, Inc.
Design Firm No. 184-002792

Compare your description and site markings with this plat and AT ONCE report any discrepancies which you may find.

By: _____ Wisconsin Registered Land Surveyor No. S3021

LEGEND	
•	DOWN GUY
⊙	FLAG POLE
*	FOUND CROSS
●	FOUND IRON BAR
○	FOUND IRON PIPE
⦿	SANITARY MANHOLE
⦿	UTILITY POLE
⦿	WELL
(M)	MEASURED
(D)	DEED
(R)	RECORD

CLIENT: ANNE FAHRENBACH
DRAWN BY: OKV CHECKED BY: WJV
SCALE: 1"=20' SEC. 32 T. 02 R. 16 E.
BASIS OF BEARING: ASSUMED
P.I.N.: FRO 00006
JOB NO.: 210872 I.D. LSS
FIELDWORK COMP.: 08/23/21 BK. PG.
ALL DISTANCES SHOWN IN FEET AND DECIMAL REF.
PARTS THEREOF CORRECTED TO 68° F.