


PLAT OF SURVEY
OF
LOT 48, KRUMHAAR'S ADDITION TO
RAVENSWOOD, SECTION 31, TOWN 2
NORTH, RANGE 16 EAST, TOWN OF
DELAVER, WALWORTH COUNTY, WISCONSIN

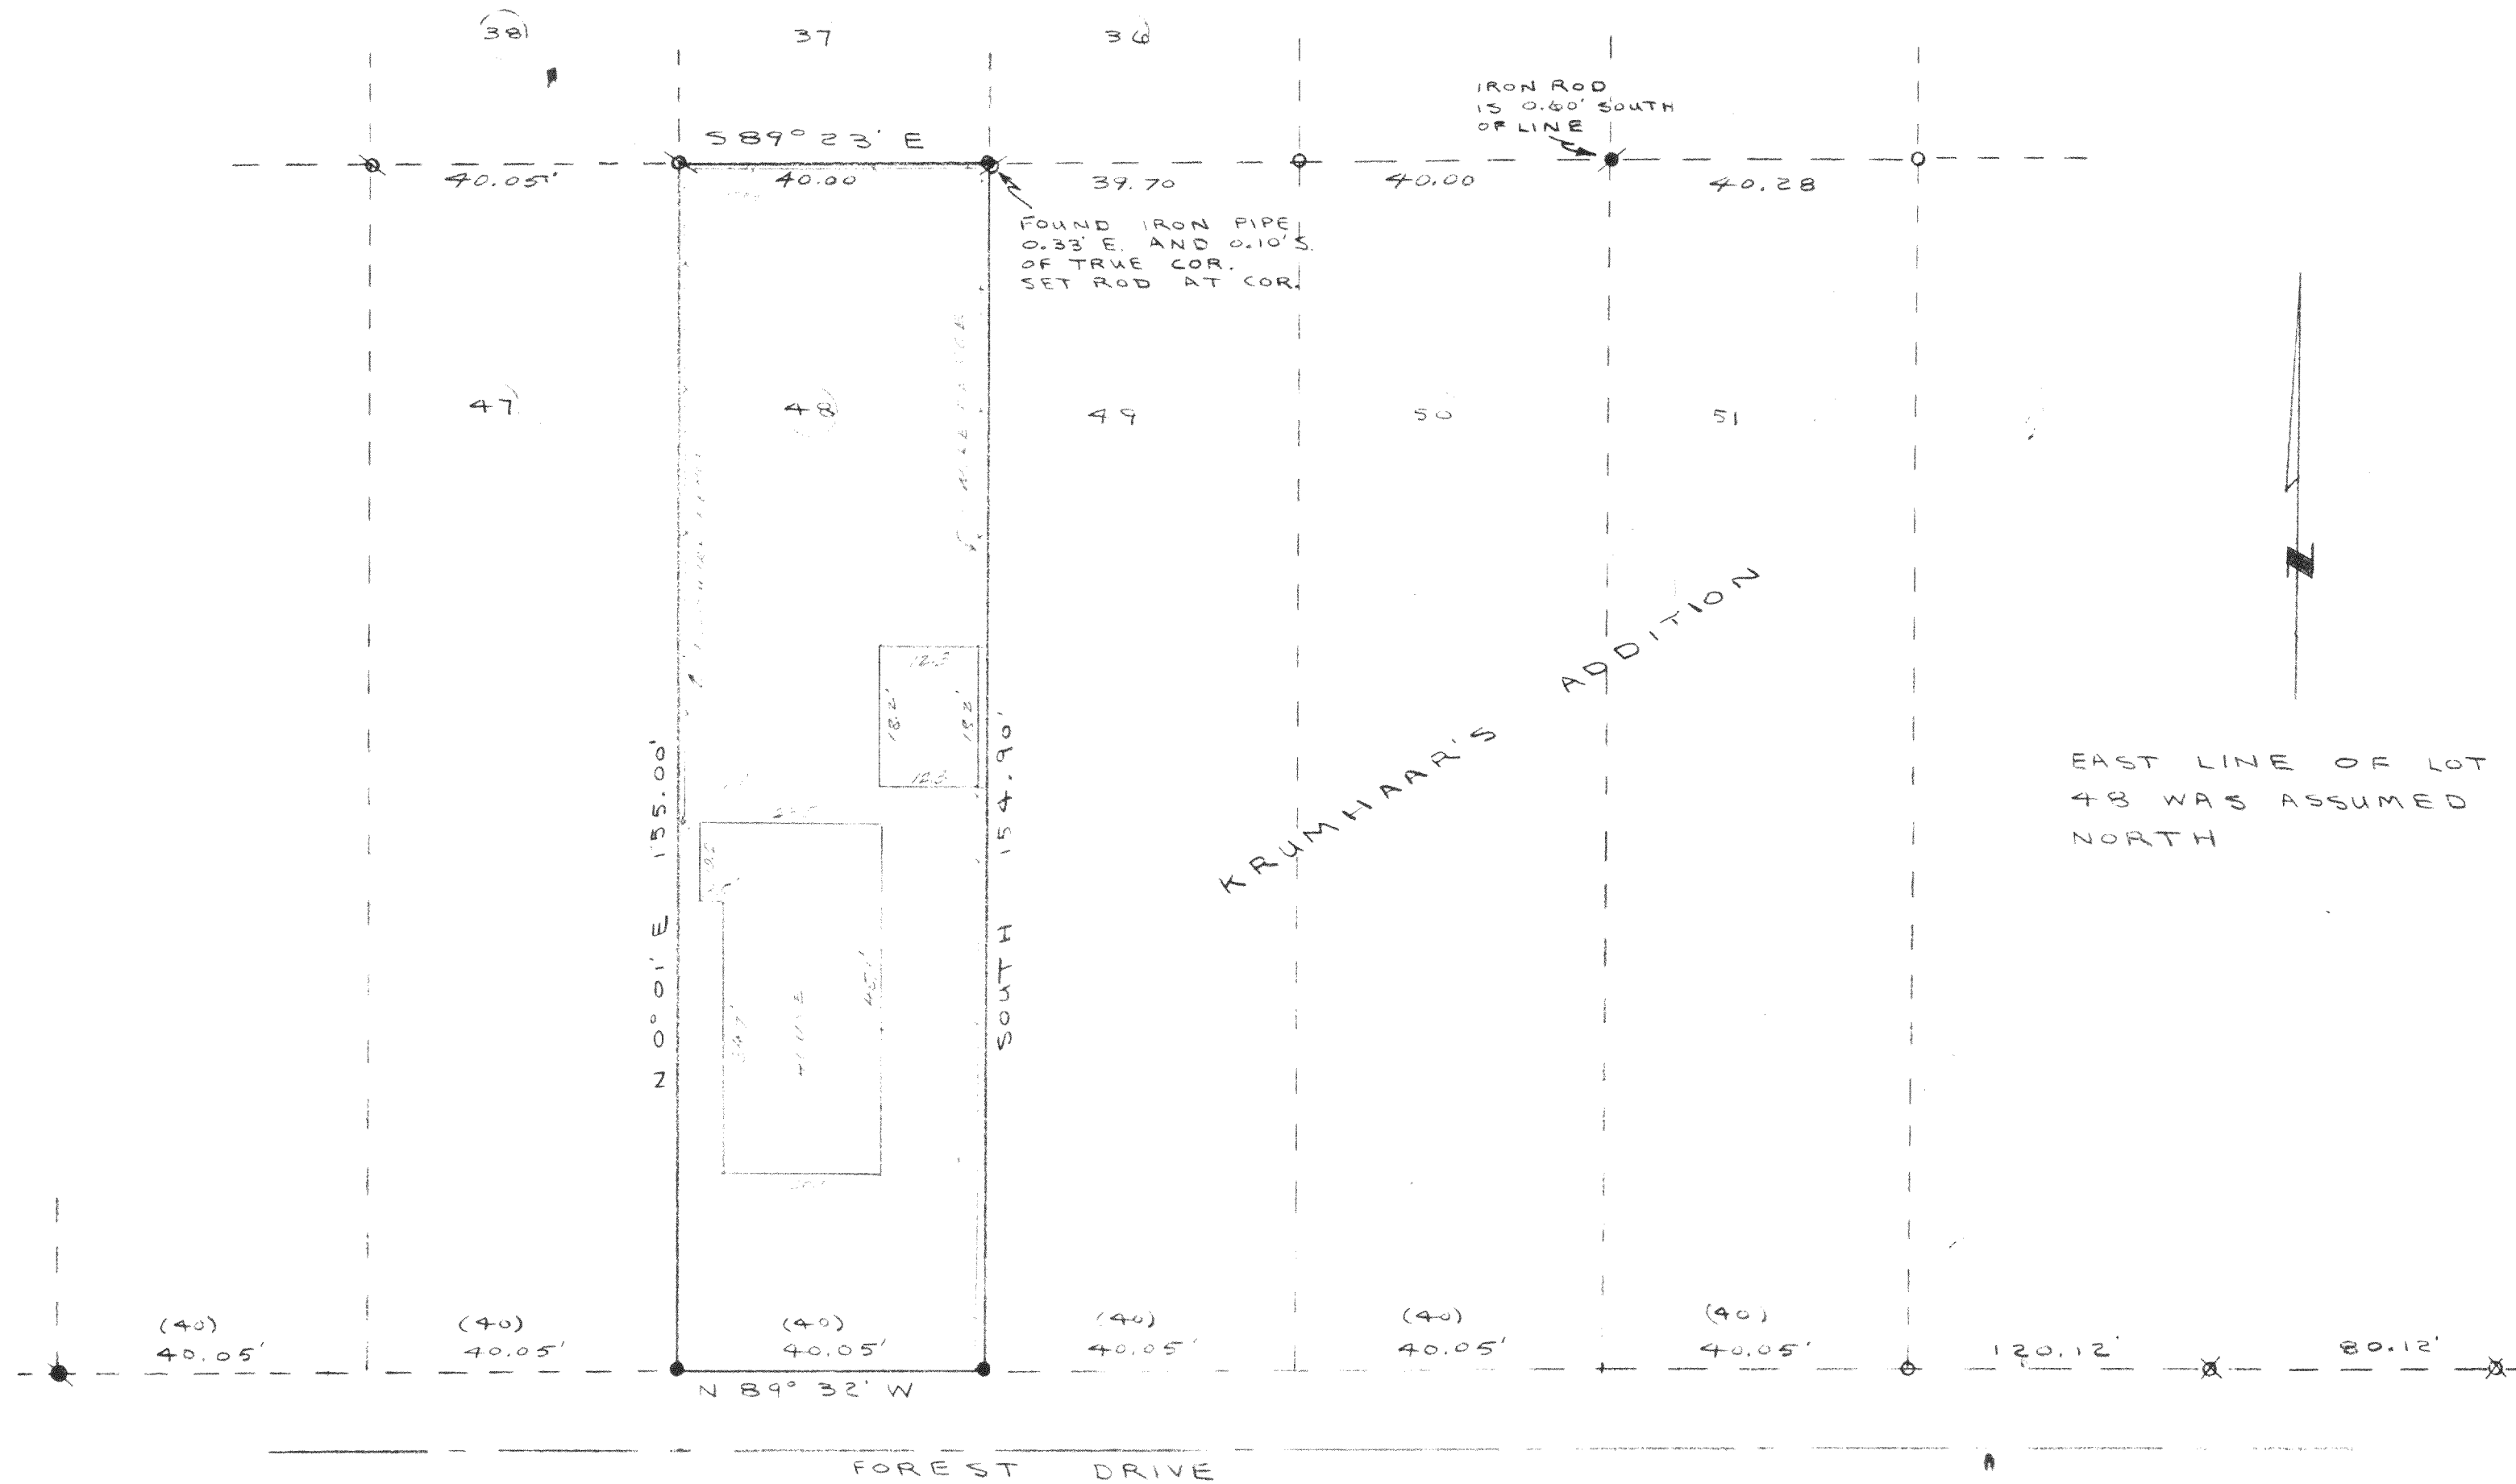


SURVEYED FOR HEDLAND REALTY

THE ABOVE-DESCRIBED PROPERTY HAS BEEN
SURVEYED UNDER MY DIRECTION AND THE
ABOVE MAP IS A TRUE REPRESENTATION
THEREOF AND SHOWS THE SIZE AND LOCATION
OF THE PROPERTY TO THE BEST OF MY KNOWLEDGE
AND BELIEF

DATED THIS 3rd DAY OF MARCH 1977

Thomas P. A. Jensen
THOMAS P. A. JENSEN
REGISTERED LAND SURVEYOR
NO. S-1094

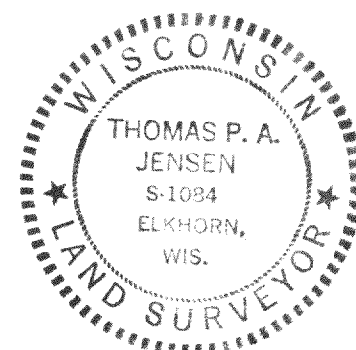

- ⊗ FOUND 3/4" D. IRON PIPE
- FOUND 3/4" D. ROD
- FOUND 1" D. IRON PIPE
- ⊗ FOUND 1 1/4" D. IRON PIPE
- SET 3/4" D. X 24" LONG IRON ROD
- (x x x) RECORDED DIST.

SCALE 1" = 20'



FRA-43

PROJECT # 1458.147

10-28-147

216-591