



PLAT OF SURVEY
LOT 2 OF CERTIFIED SURVEY MAP 381
PART OF THE SW 1/4 OF THE SW 1/4 OF SECTION 9, TOWN 2 NORTH, RANGE 16 EAST
TOWN OF DELAVAN, WALWORTH COUNTY, WISCONSIN

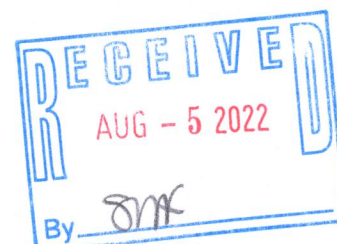

FA 381-2

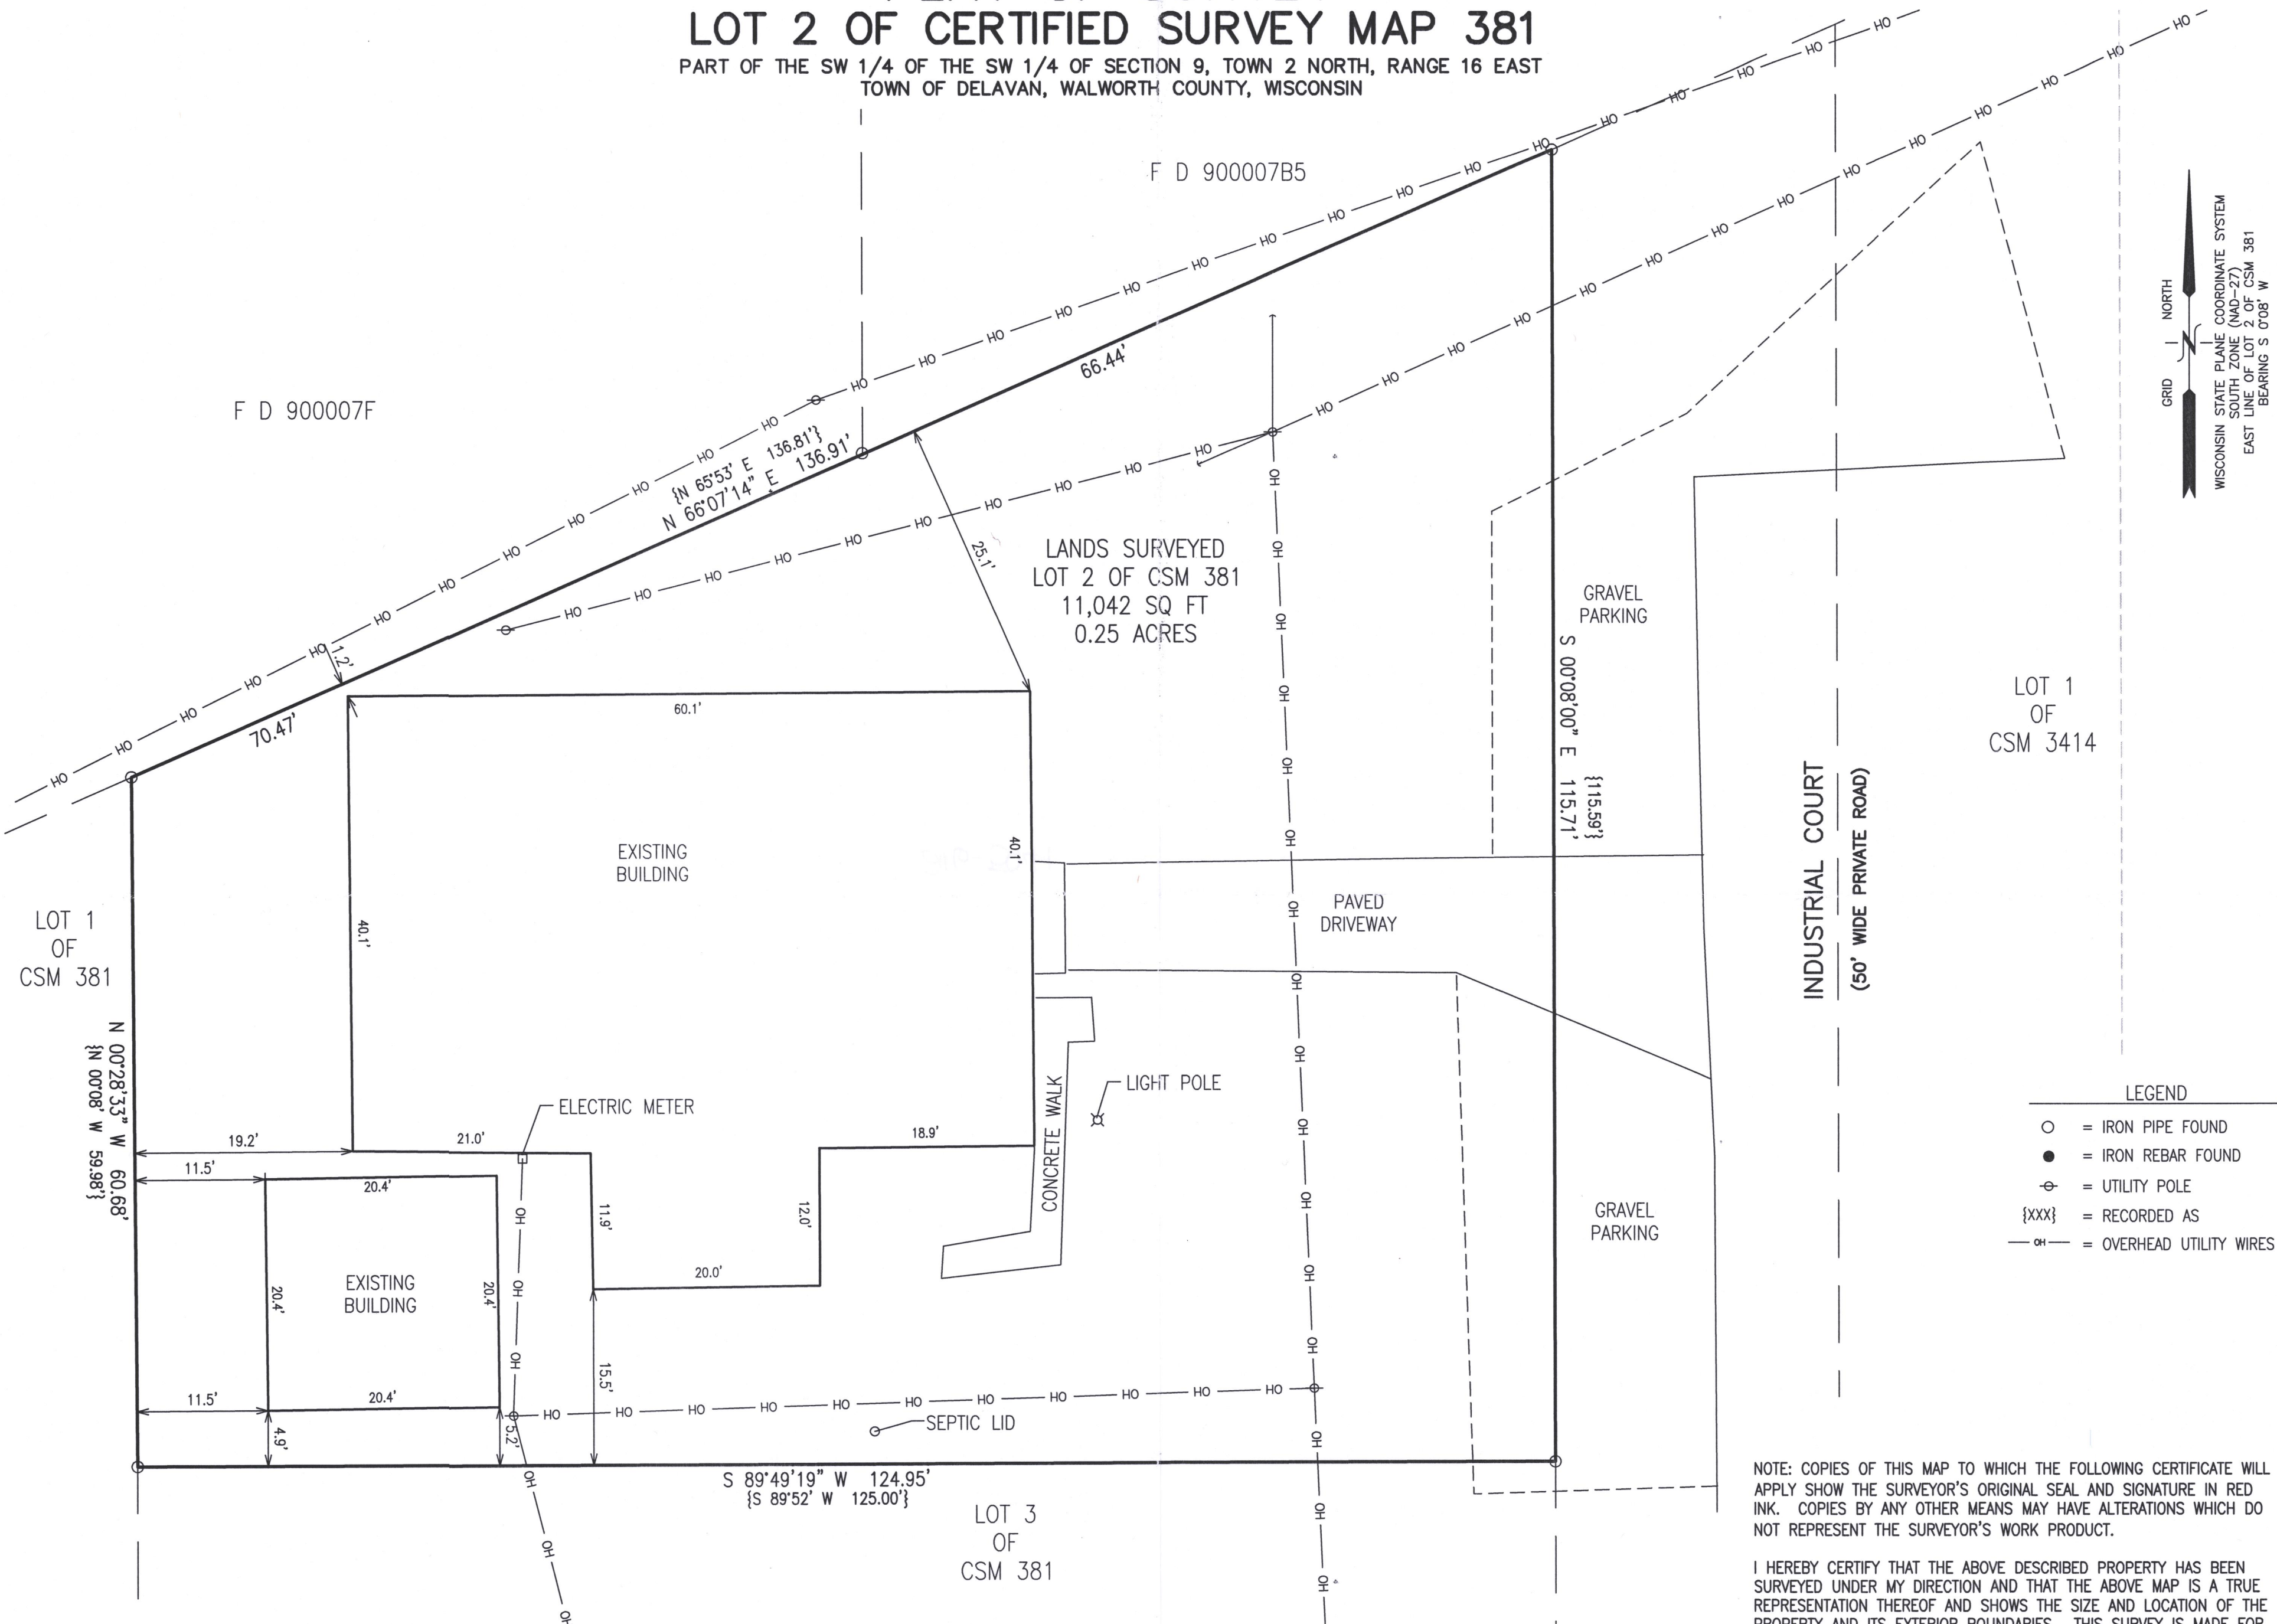

BOUNDARY SURVEY
4153 INDUSTRIAL COURT
DELAVAN, WI 53115

— WORK ORDERED BY —
TIM HANSEN
3552 STATE ROAD 50
DELAVAN, WI 53115

FARRIS, HANSEN & ASSOCIATES, INC.
ENGINEERING - ARCHITECTURE - SURVEYING
7 RIDGWAY COURT P.O. BOX 437
ELKHORN, WISCONSIN 53121
OFFICE: (262) 723-2098 FAX: (262) 723-5886

REVISIONS

PROJECT NO.
10731

DATE:
8/01/2022

SHEET NO.
1 OF 1