


Plat of Survey

of

Lots 5, 6 & 7 in Block 7 of South Shore Manor,

a subdivision located in Government Lots 1 & 2 in the Southeast 1/4 of Section 32,
Town 2 North, Range 16 East, Town of Delavan, Walworth County, Wisconsin.

Surveyed for: **Michael Kloss**
17529 Hawk Court
Gurnee, Illinois. 60031

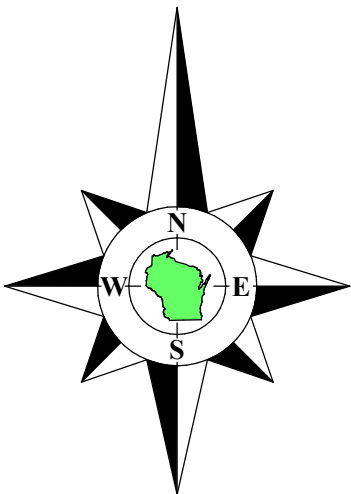


Bearings referenced to the South line of the Southwest 1/4 of Section 32-2-16,
recorded as N88°28'56"E in the Wisconsin State Plane Coordinate System,
South Zone, (NAD-27).

Coordinates are referenced to the Wisconsin State
Plane Coordinate System, South Zone, (NAD-27).

Survey Date: May 12, 2022.
Revisions:




45 South Wisconsin Street | P.O. Box 322
Elkhorn, Wisconsin. 53121
Telephone: (262) 723-3434
Facsimile: (262) 723-8044
Email: doug@olsonsurveying.com
Website: www.olsonsurveying.com

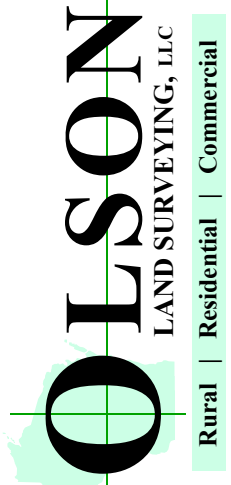

Legend of Symbols & Abbreviations	
Found Corner	North
Found Section Corner	South
Found Iron Pipe	East
Found Iron Rod	West
Recorded Information	Bearings
Utility Pole	In Degrees
Utility Pedestal	Surface
Concrete Surface	Gravel Surface
Gravel Surface	Asphalt Surface
Asphalt Surface	Septic Vent
Septic Vent	Well
Well	Mailbox

Sheet 1 of 1 Sheets	Drawing Name:
Job Reference Number	2022.061
2022.061	

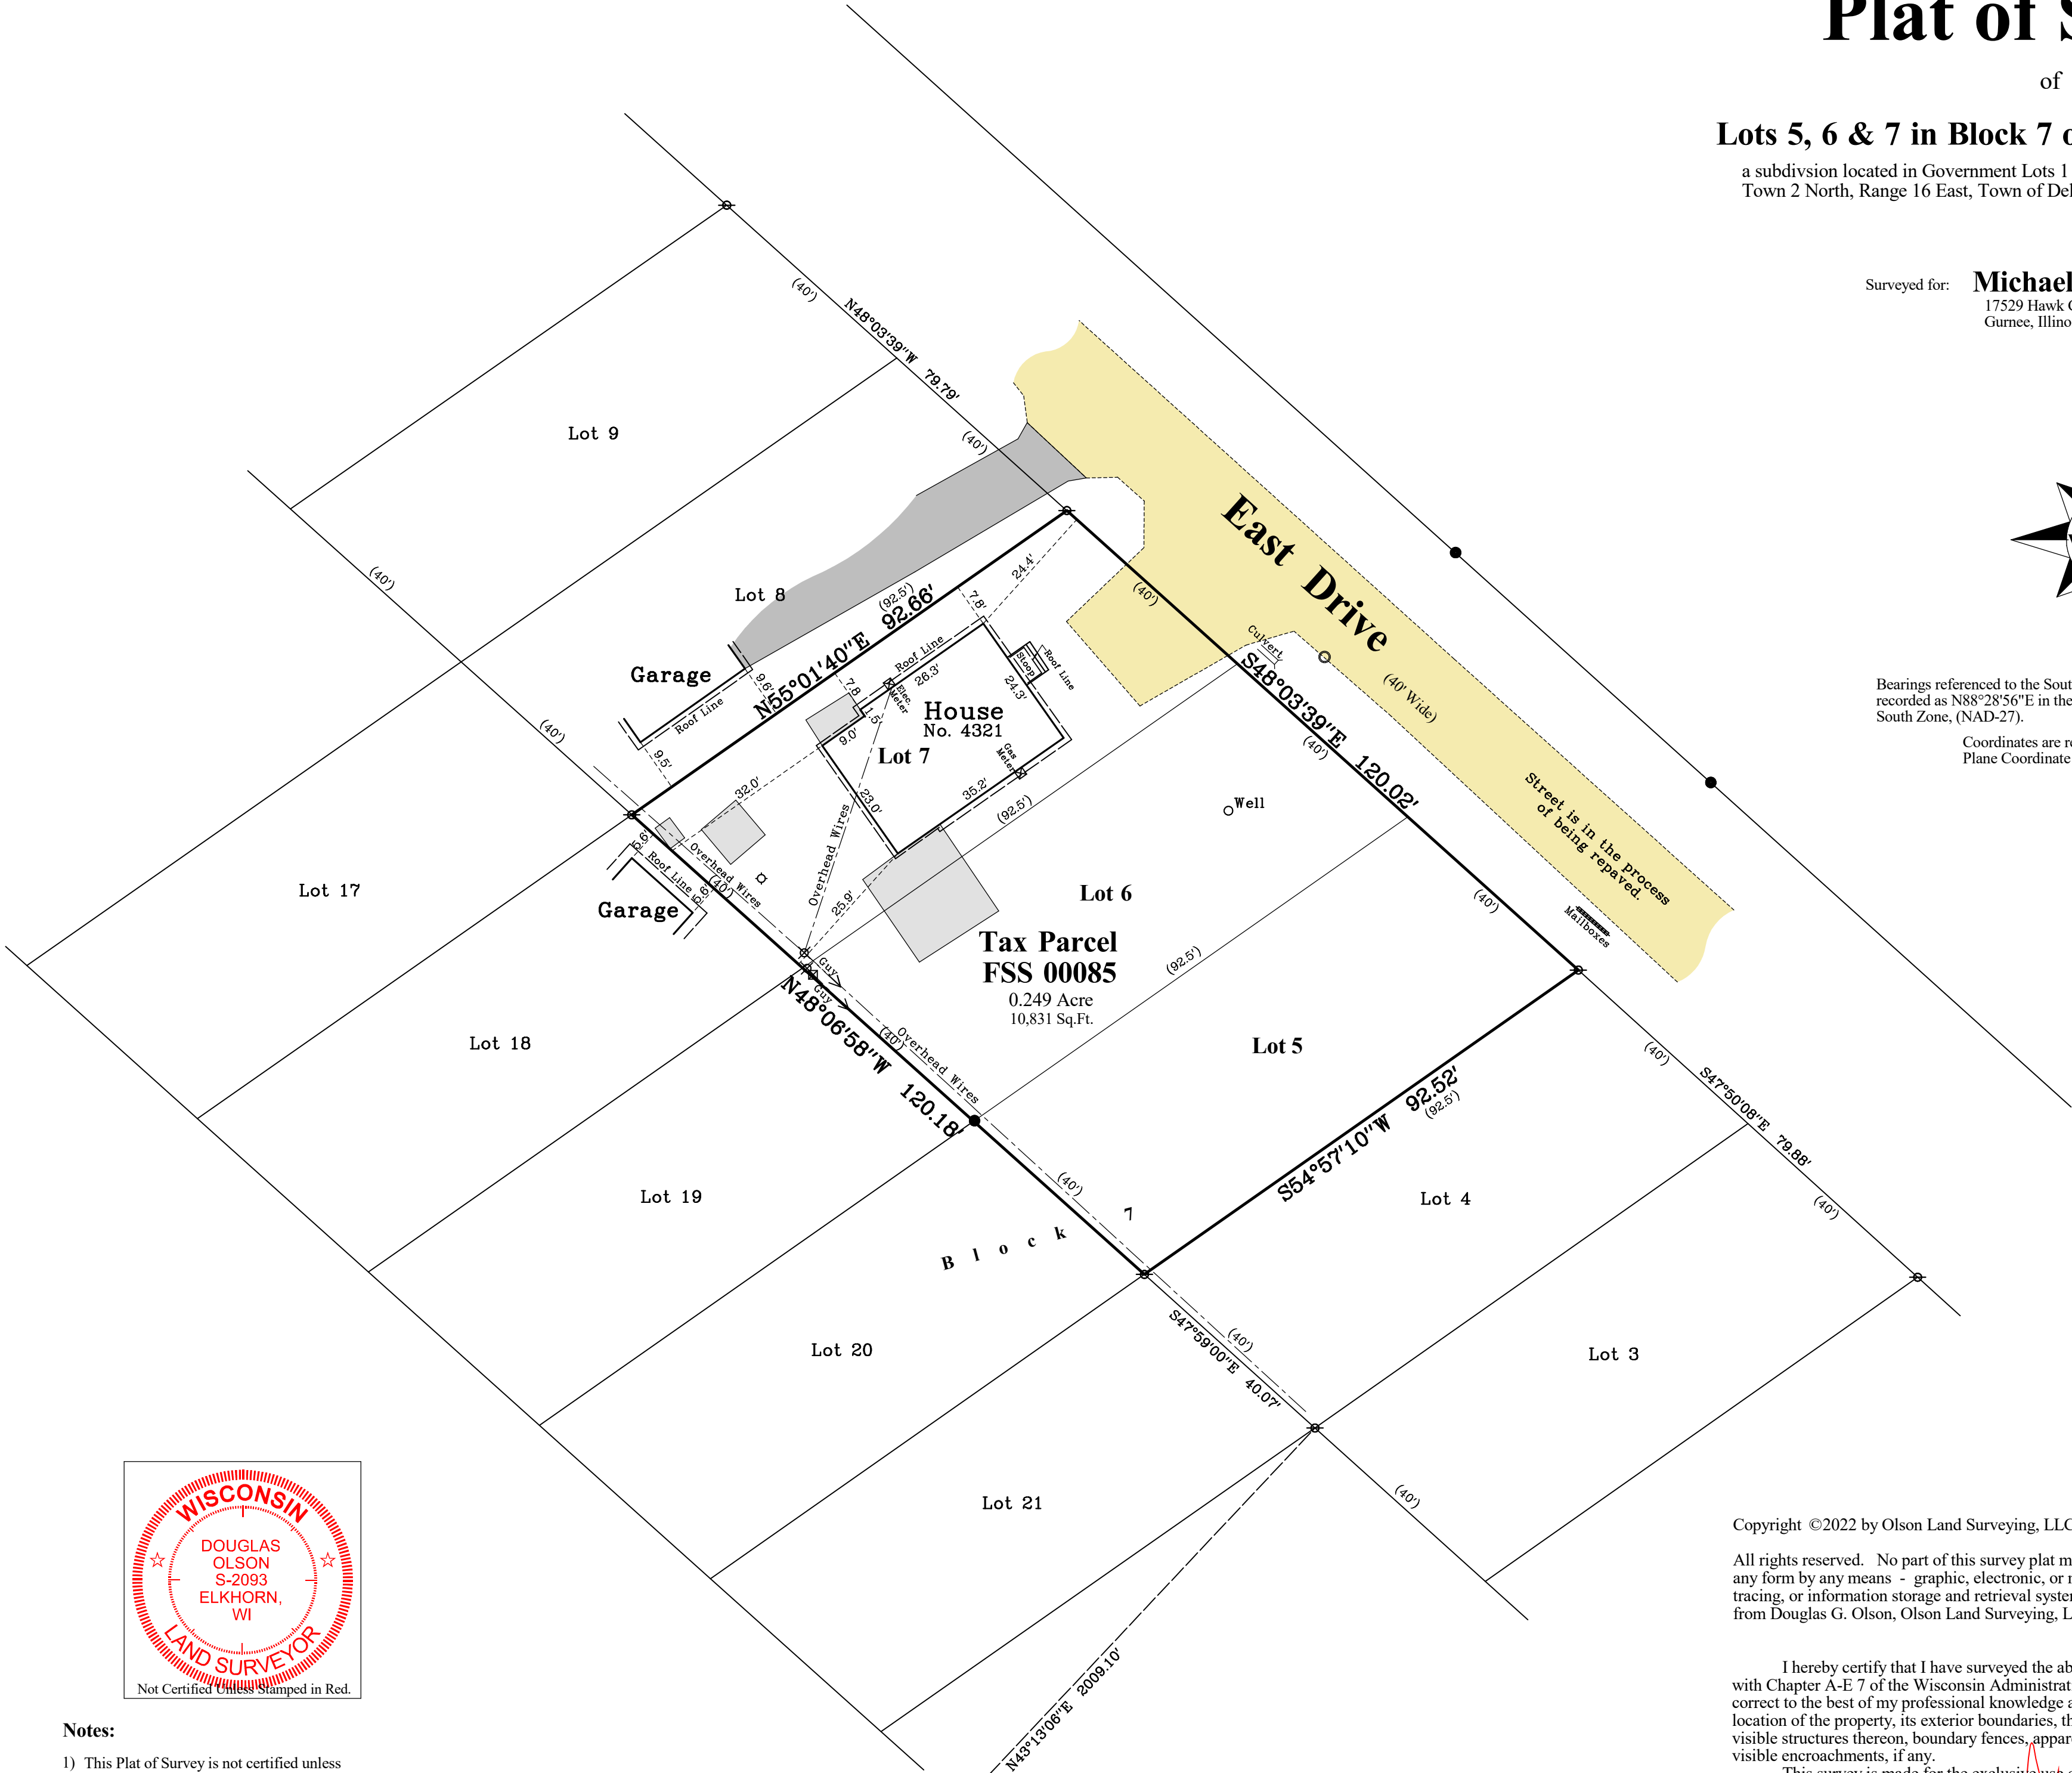


Copyright ©2022 by Olson Land Surveying, LLC.

All rights reserved. No part of this survey plat may be reproduced or transmitted in
any form by any means - graphic, electronic, or mechanical, including photocopying,
tracing, or information storage and retrieval systems - without permission in writing
from Douglas G. Olson, Olson Land Surveying, LLC.

I hereby certify that I have surveyed the above described property in compliance
with Chapter A-E 7 of the Wisconsin Administrative Code and that the map hereon is
correct to the best of my professional knowledge and belief and shows the size and
location of the property, its exterior boundaries, the location and dimensions of all
visible structures thereon, boundary fences, apparent easements and roadways and
visible encroachments, if any.

This survey is made for the exclusive use of the present owners of the property,
and also those who purchase, mortgage or guarantee title thereto, within one year from
the date hereof.

Douglas G. Olson
Wisconsin Professional Land Surveyor - 2093

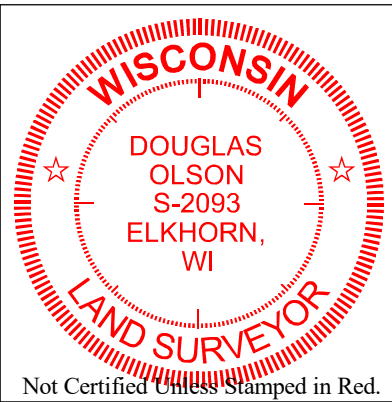

Notes:

- 1) This Plat of Survey is not certified unless signed and sealed in red ink.
- 2) This survey is subject to Wisconsin lien laws. This Plat of Survey is the notice of intent to file lien. Lien waiver required.
- 3) The Survey Date shown on this Plat of Survey is the completion date of the field work.

South 1/4 Corner
Section 32-2-16
N. 215,278.32
E. 2,369,206.01