

PLAT OF SURVEY LOT 18 GENEVA WEST ESTATES SUBDIVISION

PART OF THE SW 1/4 OF THE SE 1/4 OF SECTION 25, TOWN 2 NORTH, RANGE 16 EAST
TOWN OF DELAVAN, WALWORTH COUNTY, WISCONSIN

SOUTH LINE OF LOT 18
GENEVA WEST ESTATES SUBDIVISION
SECTION 25, T2N, R16E BEARS
S 89°52'16" E




AS-BUILT
2532 COUNTRYSIDE DRIVE
DELAVAN, WI 53115

WORK ORDERED BY -
ROBERT HUGHES
2532 COUNTRYSIDE DRIVE
DELAVAN, WI 53115

FARRIS, HANSEN & ASSOCIATES, INC.
ENGINEERING - ARCHITECTURE - SURVEYING
7 RIDGWAY COURT P.O. BOX 437
ELKHORN, WISCONSIN 53121
OFFICE: (262) 723-2098 FAX: (262) 723-5886

REVISIONS
11/23/2022 FOUNDATION & DHC
ADDITION AS-BUILT

PROJECT NO.
10687
DATE:
5/20/2022
SHEET NO.
1 OF 1

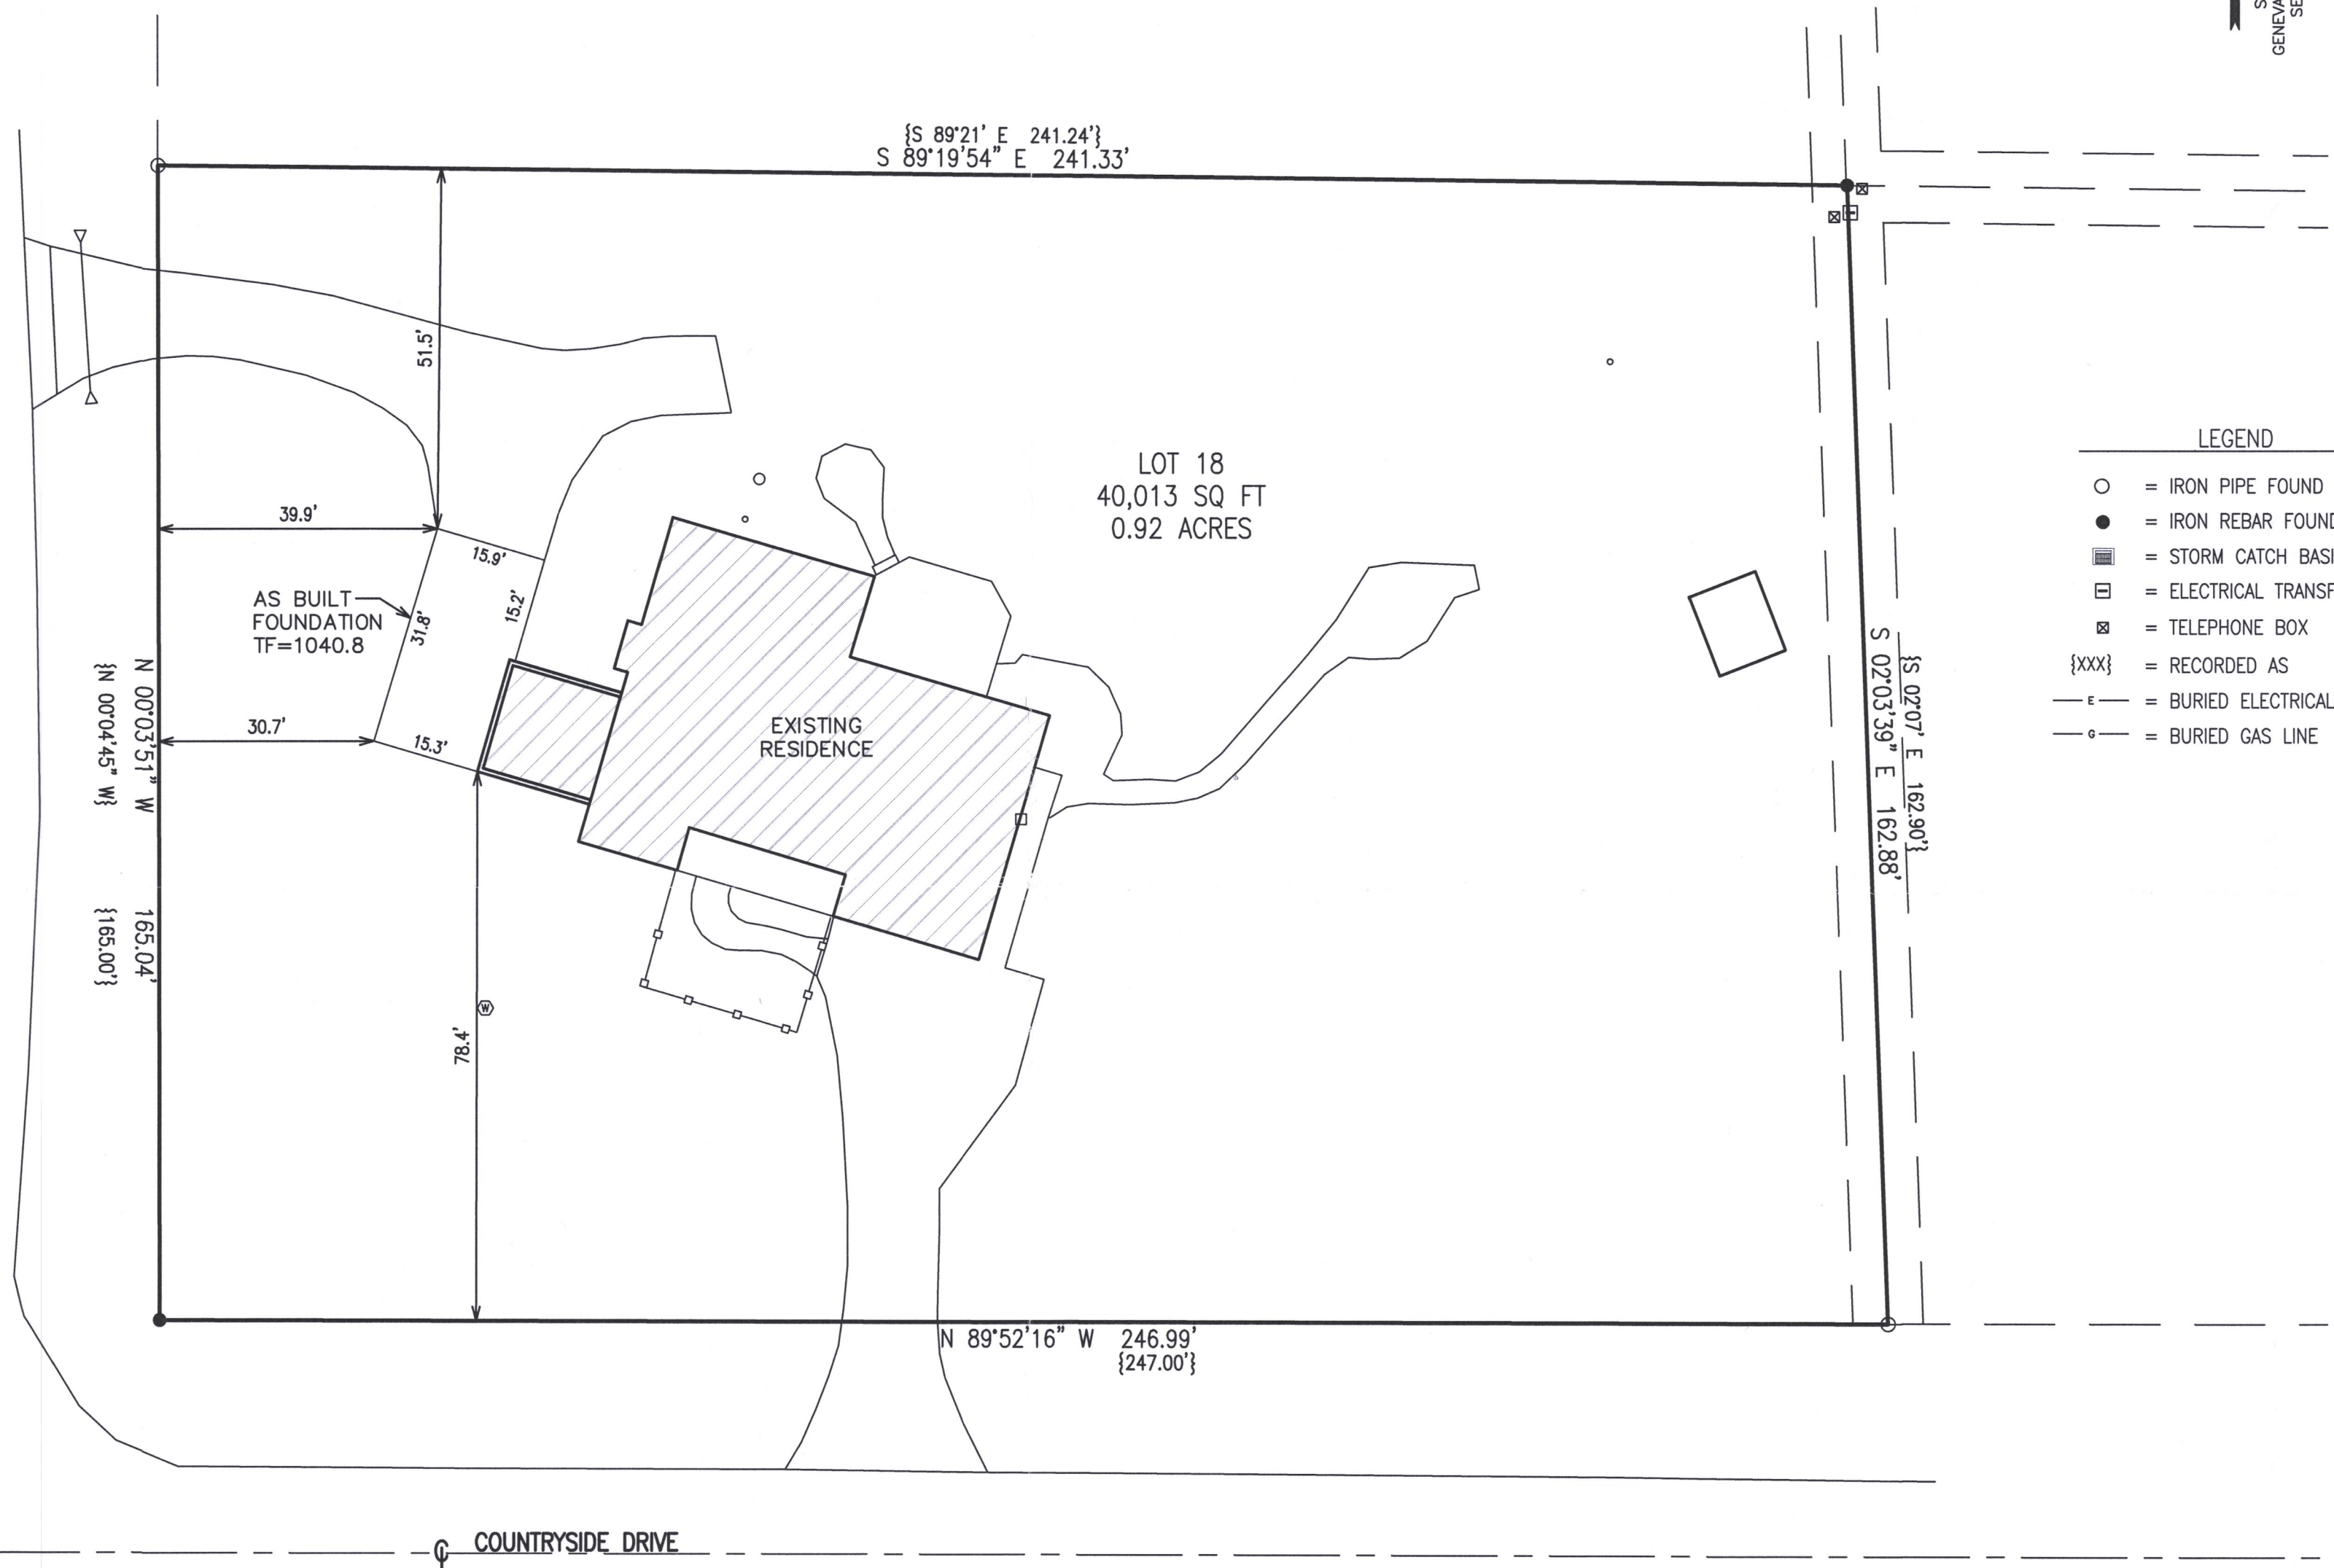

NOTE: COPIES OF THIS MAP TO WHICH THE FOLLOWING CERTIFICATE WILL APPLY
SHOW THE SURVEYOR'S ORIGINAL SEAL AND SIGNATURE IN RED INK. COPIES BY
ANY OTHER MEANS MAY HAVE ALTERATIONS WHICH DO NOT REPRESENT THE
SURVEYOR'S WORK PRODUCT.

I HEREBY CERTIFY THAT THE ABOVE DESCRIBED PROPERTY HAS BEEN SURVEYED
UNDER MY DIRECTION AND THAT THE ABOVE MAP IS A TRUE REPRESENTATION
THEREOF AND SHOWS THE SIZE AND LOCATION OF THE PROPERTY AND ITS
EXTERIOR BOUNDARIES. THIS SURVEY IS MADE FOR THE USE OF THE PRESENT
OWNERS OF THE PROPERTY, AND ALSO THOSE WHO PURCHASE, MORTGAGE, OR
GUARANTEE THE TITLE THERETO WITHIN ONE YEAR FROM THE DATE HEREOF.

DATED: 5/20/2022

REVISED 11/11/2022 TO
SHOW RESIDENCE ADDITION
FOUNDATION AS BUILT

CHRISTOPHER A. HODGES P.L.S. 2760

