


PLAT OF SURVEY LOT 7 OF SUMMIT MEADOWS SUBDIVISION

LOCATED IN PART OF THE NW 1/4 OF THE NW 1/4 OF SECTION 31,
TOWN 2 NORTH, RANGE 16 EAST, WALWORTH COUNTY, WISCONSIN

LOT 8

LOT 6

LOT 7
33,447 S.F.
(0.77 ACRES)

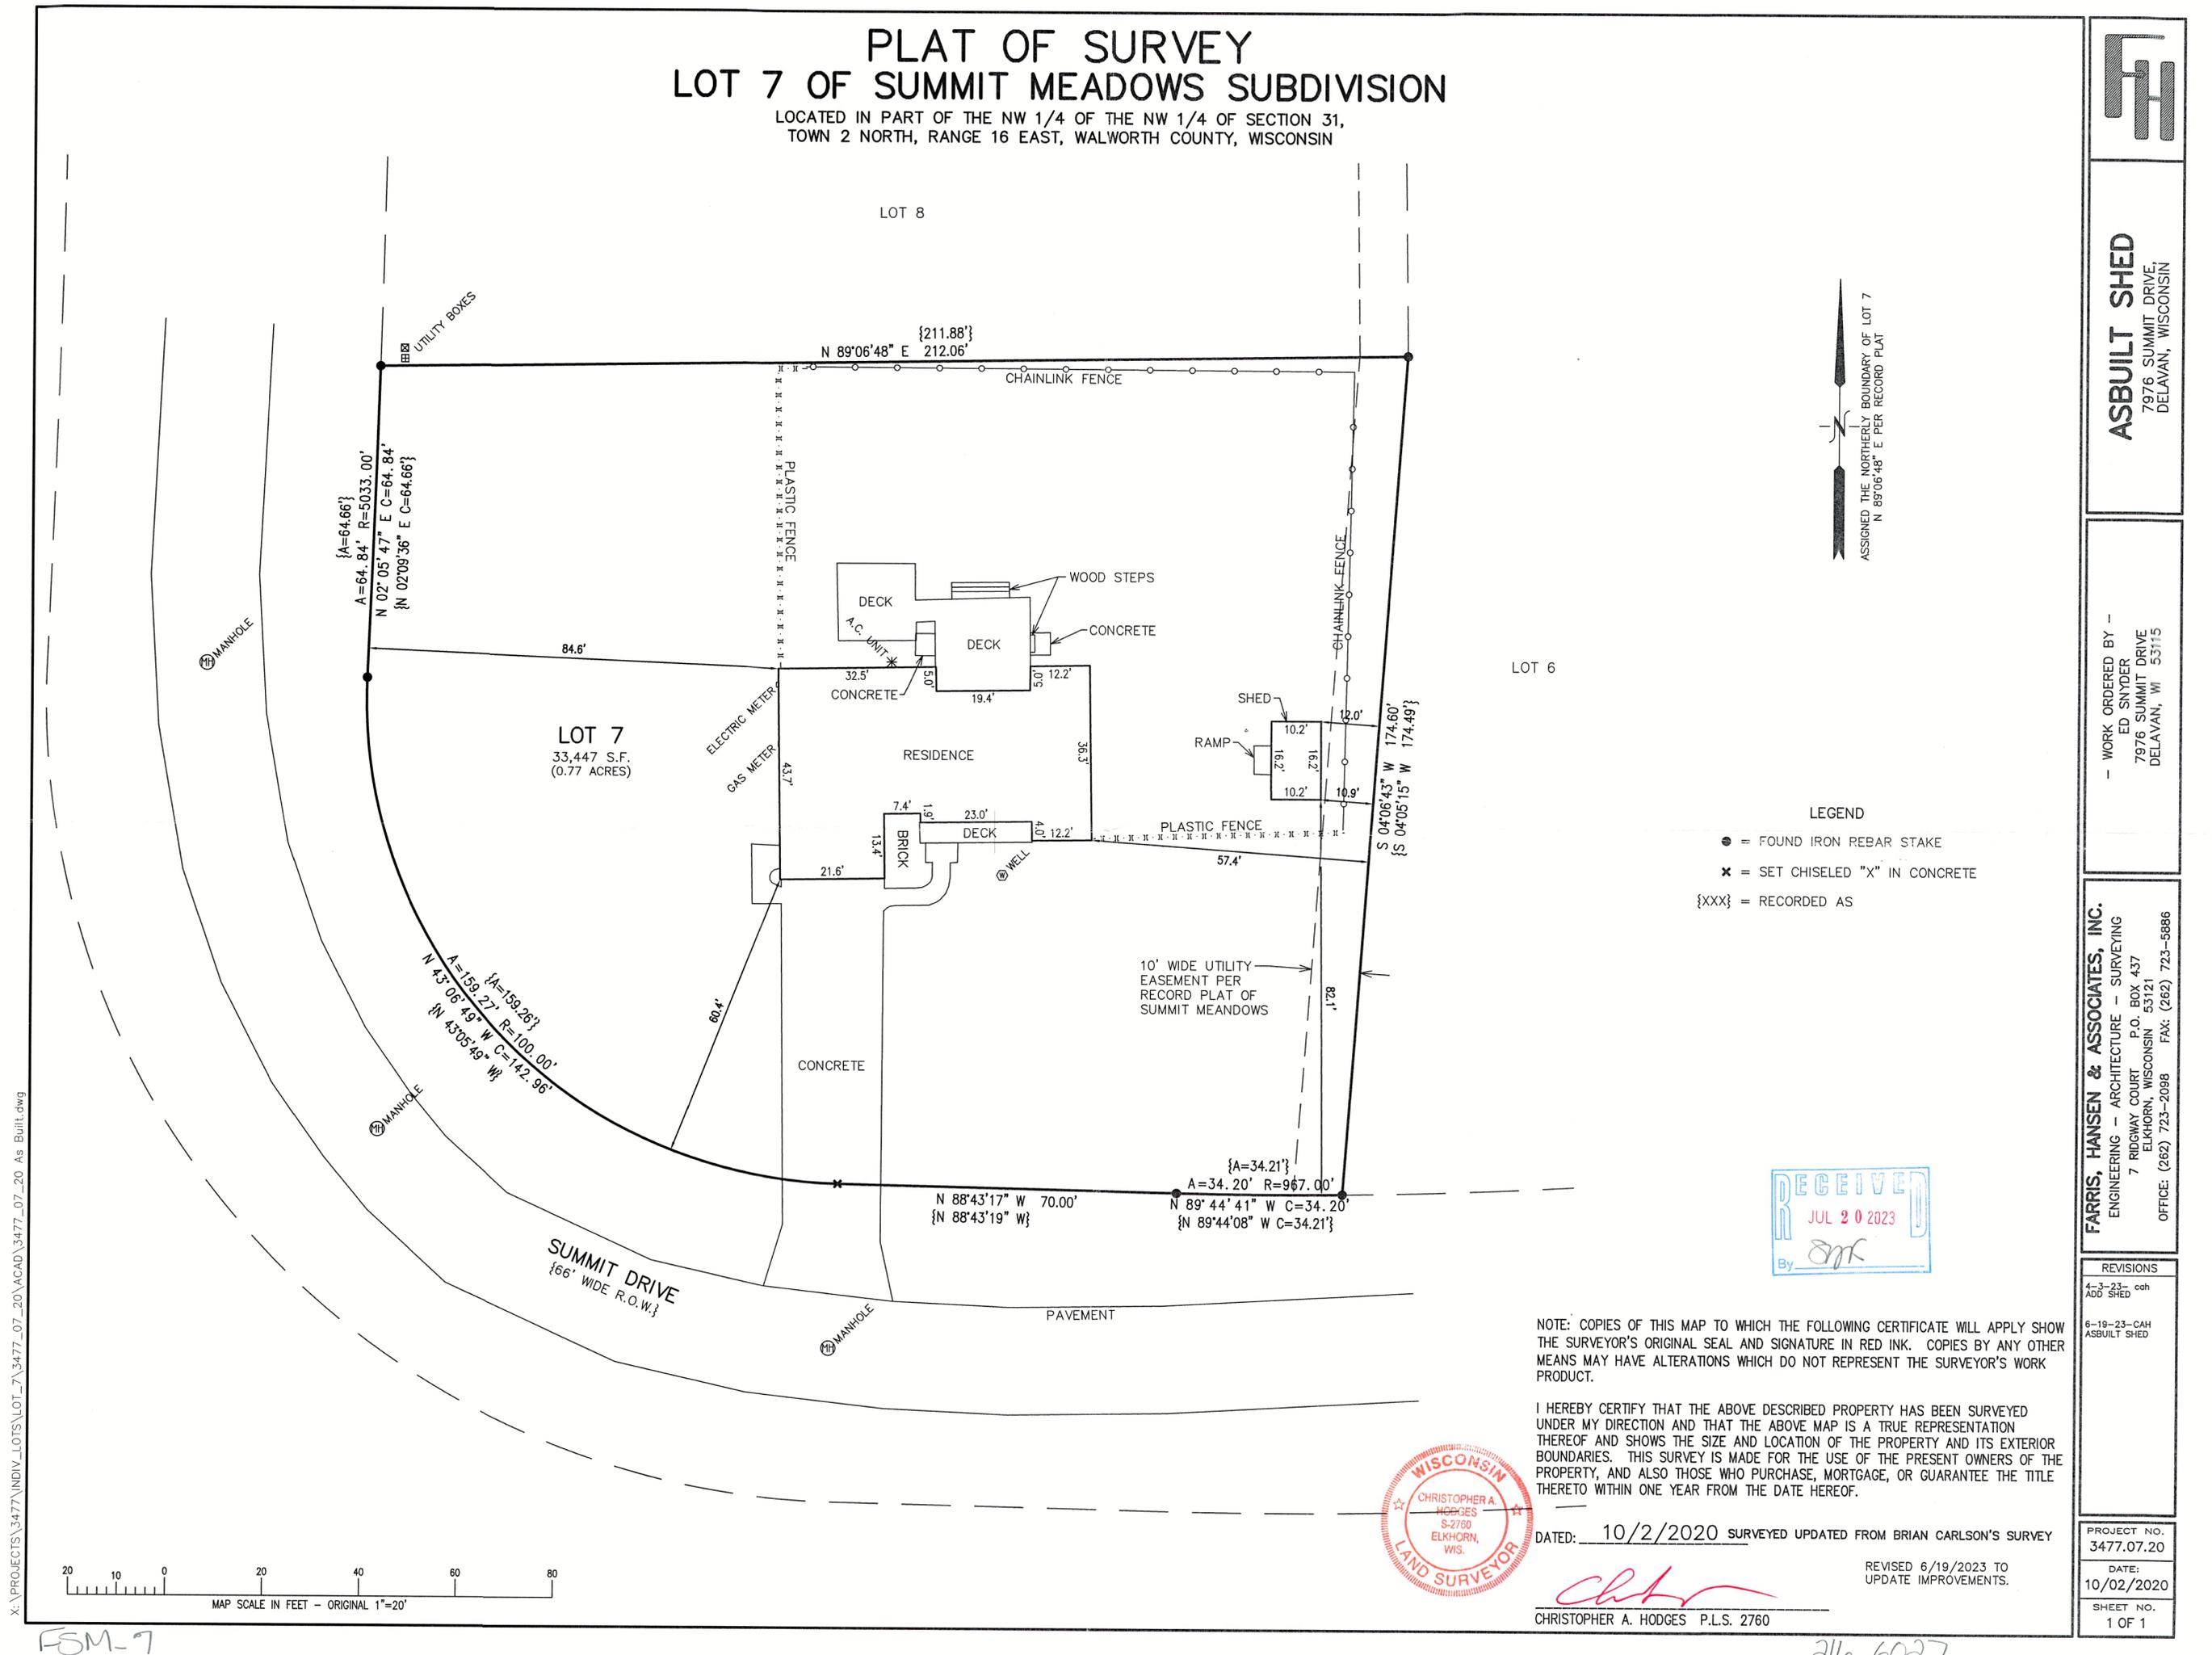

RECEIVED
JUL 20 2023
By: *[Signature]*

NOTE: COPIES OF THIS MAP TO WHICH THE FOLLOWING CERTIFICATE WILL APPLY SHOW THE SURVEYOR'S ORIGINAL SEAL AND SIGNATURE IN RED INK. COPIES BY ANY OTHER MEANS MAY HAVE ALTERATIONS WHICH DO NOT REPRESENT THE SURVEYOR'S WORK PRODUCT.


I HEREBY CERTIFY THAT THE ABOVE DESCRIBED PROPERTY HAS BEEN SURVEYED UNDER MY DIRECTION AND THAT THE ABOVE MAP IS A TRUE REPRESENTATION THEREOF AND SHOWS THE SIZE AND LOCATION OF THE PROPERTY AND ITS EXTERIOR BOUNDARIES. THIS SURVEY IS MADE FOR THE USE OF THE PRESENT OWNERS OF THE PROPERTY, AND ALSO THOSE WHO PURCHASE, MORTGAGE, OR GUARANTEE THE TITLE THERETO WITHIN ONE YEAR FROM THE DATE HEREOF.



DATED: 10/2/2020 SURVEYED UPDATED FROM BRIAN CARLSON'S SURVEY

CHRISTOPHER A. HODGES P.L.S. 2760

REVISED 6/19/2023 TO UPDATE IMPROVEMENTS.

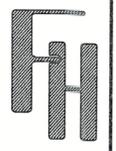

ASBUILT SHED
7976 SUMMIT DRIVE
DELAVAN, WISCONSIN

WORK ORDERED BY:
ED SNYDER
7976 SUMMIT DRIVE
DELAVAN, WI 53115

FARRIS, HANSEN & ASSOCIATES, INC.
ENGINEERING - ARCHITECTURE - SURVEYING
7 RIDGWAY COURT P.O. BOX 437
ELKHORN, WISCONSIN 53121
OFFICE: (262) 723-2098 FAX: (262) 723-5886

REVISIONS
4-3-23-cah
ADD SHED
6-19-23-cah
ASBUILT SHED

PROJECT NO.
3477.07.20
DATE:
10/02/2020
SHEET NO.
1 OF 1

X:\PROJECTS\3477\INDIV_LOTS\LOT_7\3477_07_20\ACAD\3477_07_20 As Built.dwg



FSM-7

216-6037