


GEORGE T. DUNHAM
SURVEYING & SUBDIVIDING
DELAVER, WISCONSIN

Iron Pipe is located
1' N. & 0.4' W.
of fence corner.

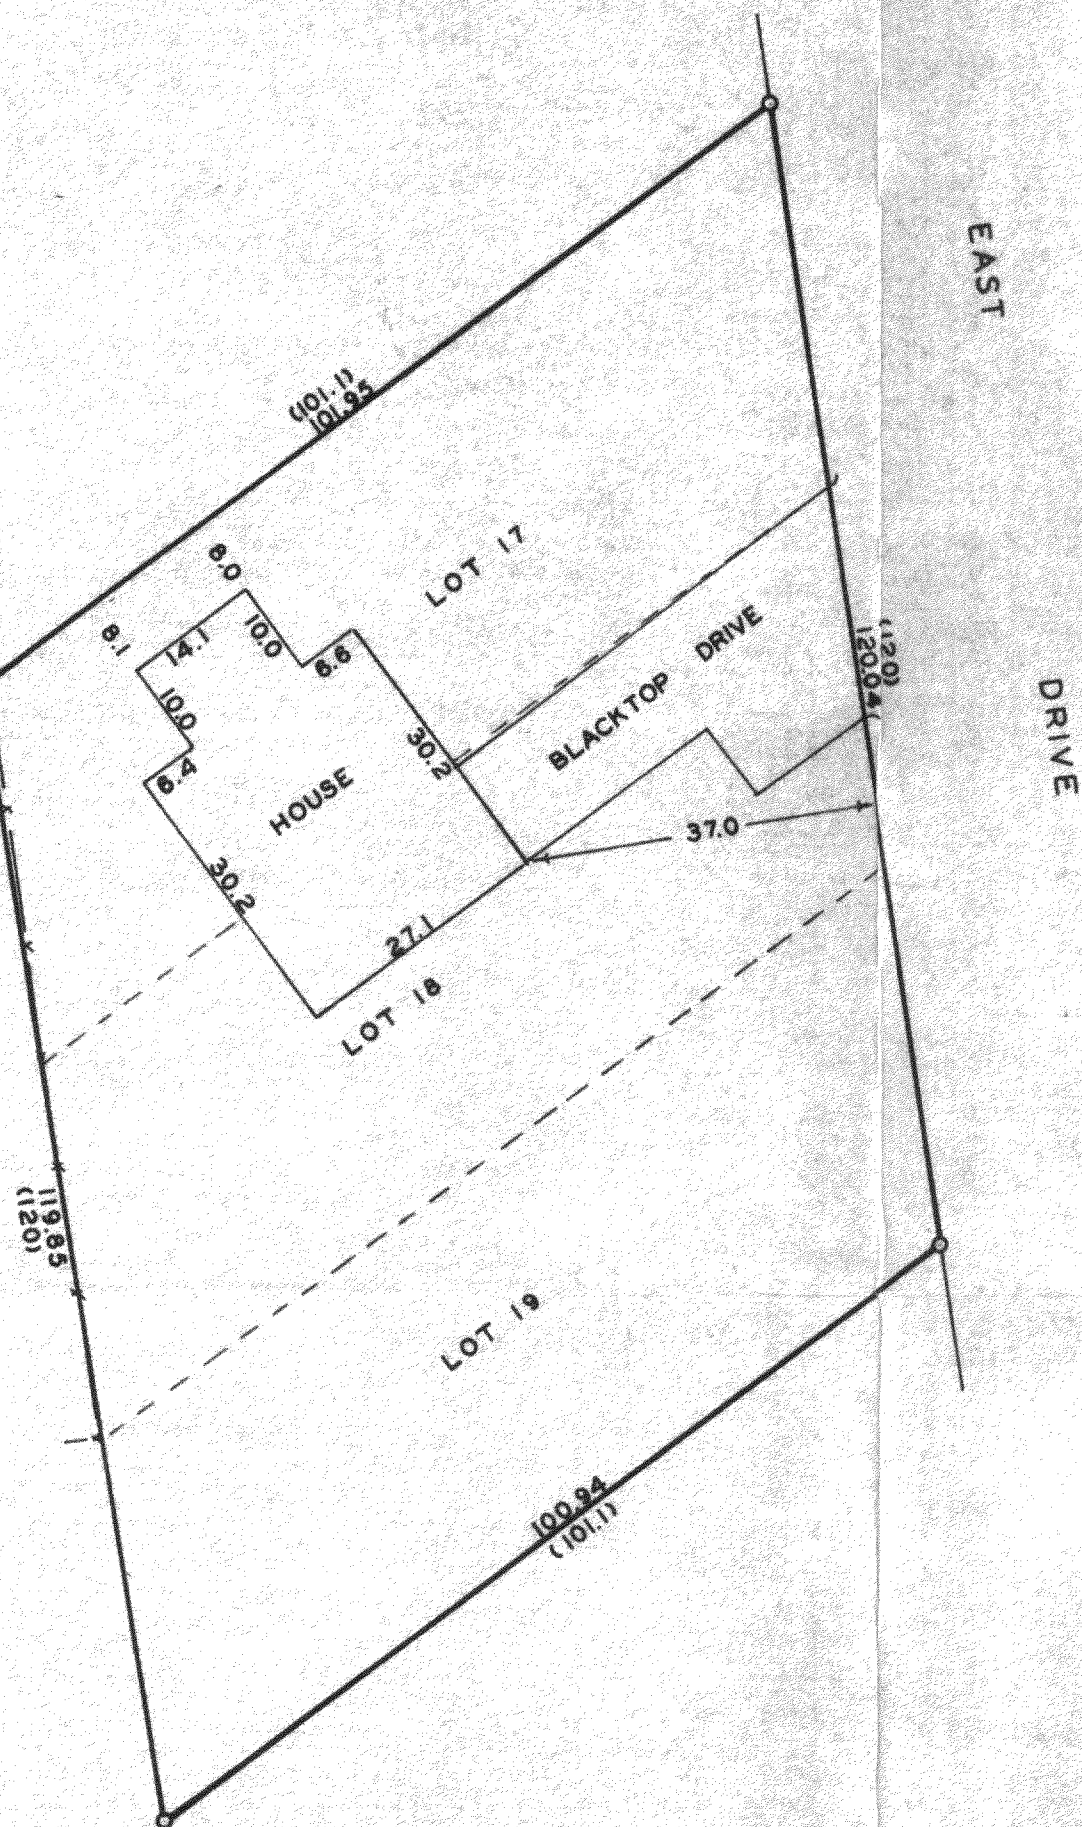

Scale - 1" = 20'
○ = Iron Pipe Found
(0.00) = Recorded Plat distance
0.00 = Field Measurement
--- = Fence line

STATE OF WISCONSIN)
COUNTY OF WALWORTH) SS

I, George T. Dunham, Surveyor, certify that I have surveyed the property described as follows,

Lots 17, 18, and 19, Block 1 of South Shore Manor, a subdivision located in Section 32, T 2 N, R 16 E, Walworth County, Wisconsin,

and the above map is a true representation thereof and shows the size and location of the property, its exterior boundaries, the location and dimensions of all structures thereon, fences, apparent easements and roadways and visible encroachments, if any.

This survey is made for the exclusive use of the present owners of the property, and also those who purchase, mortgage, or guarantee the title thereto within one (1) year from date hereof; and as to them I warrant the accuracy of said survey and map.
July 20, 1976

George T. Dunham
George T. Dunham, Surveyor

