

PLAT OF SURVEY WITH TOPOGRAPHIC MAPPING


OF LOT 12, BLOCK 1, THE INLET OAKS,
BEING PART OF THE NE 1/4 OF THE NE 1/4 OF SECTION 22,
TOWNSHIP 2 NORTH, RANGE 10 EAST, OF THE 4TH P.M.,
TOWN OF DELAVAN, WALWORTH COUNTY, WISCONSIN.

MONUMENT KEY

- 3/4" Iron Rebar Found
- Iron Pipe Found
- Record Information
- Benchmark

LEGEND

- Existing Boundary Line
- Existing Right-of-Way
- Existing Adjacent Property
- Existing Easement Line
- Existing Overhead Power
- Existing Sanitary Sewer
- Existing Electric Meter
- Existing Gas Meter
- Existing Air Conditioner
- Existing Well
- Existing Generator
- Existing Ground Light
- Existing Sanitary Manhole
- Existing Round Inlet
- Existing Telephone Pedestal
- Existing Utility Pole
- Existing Guy Wire
- Deciduous Tree
- Existing Mailbox

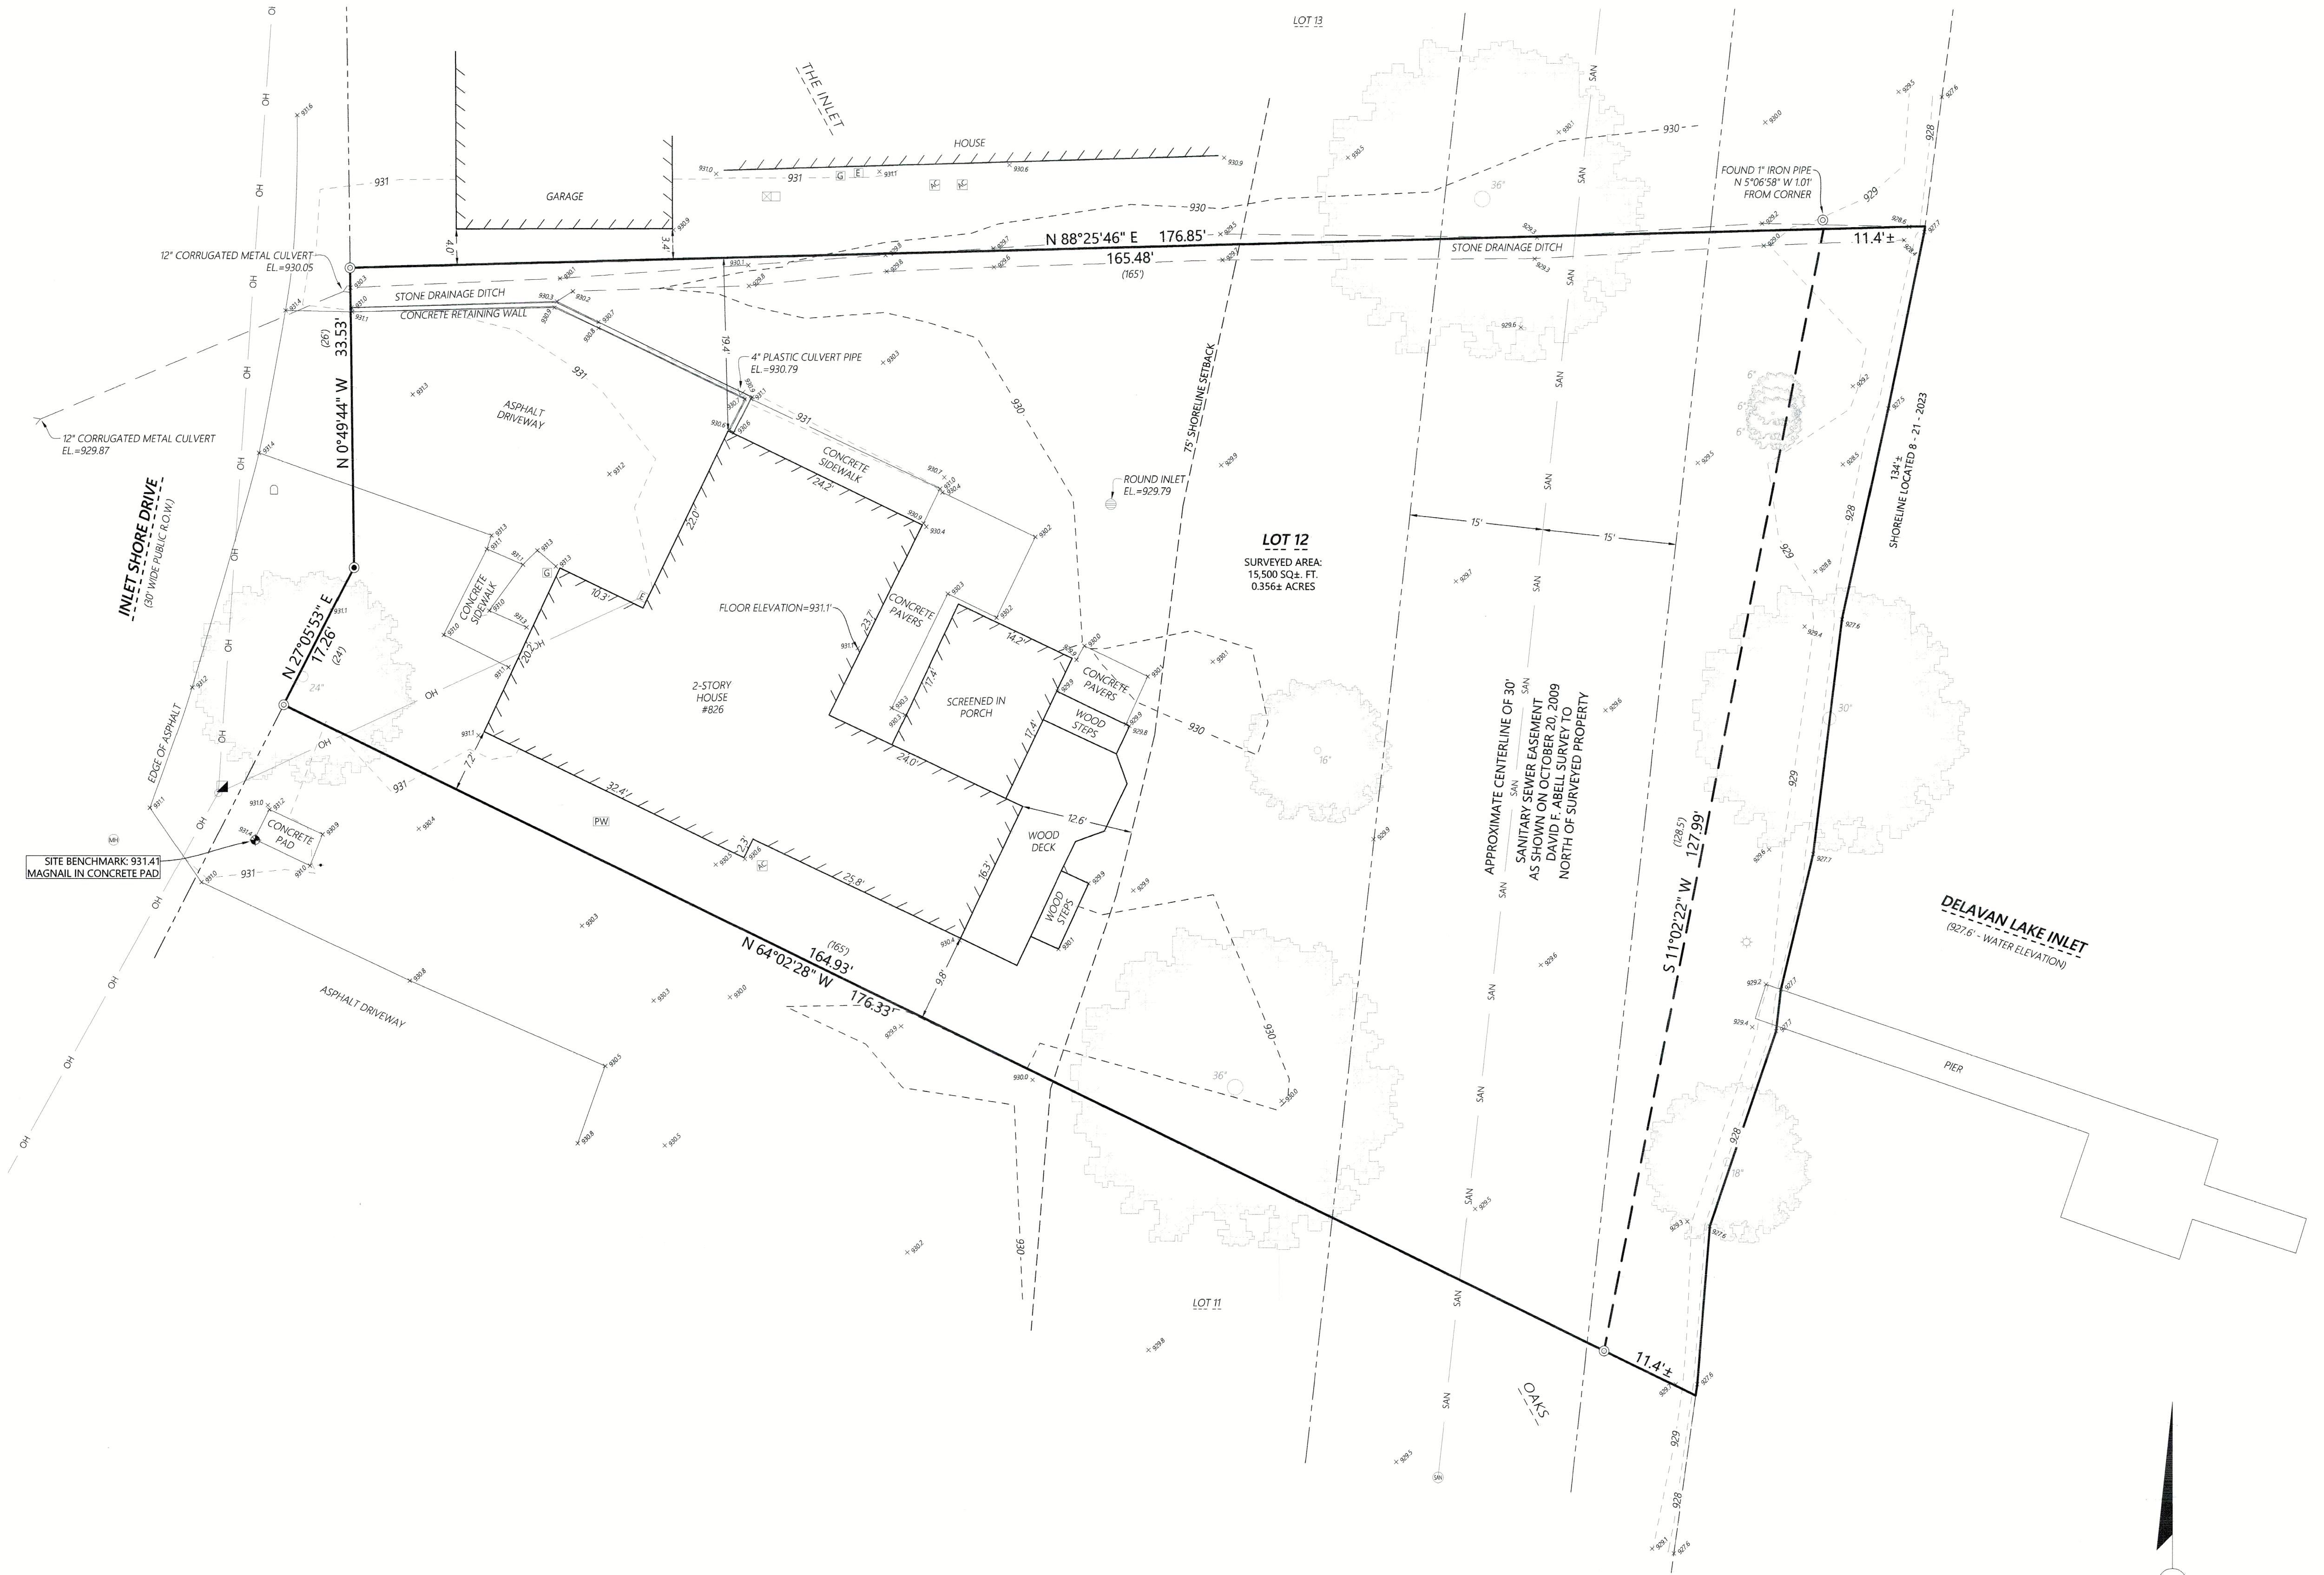

Kristin J. Belongia

Kristin J. Belongia, P.L.S.
Wisconsin Professional Land Surveyor S-2943
State of Wisconsin } ss
County of Walworth }

I hereby certify that I have supervised the survey of the property described above and to the best of my knowledge and belief, the plat drawn hereon complies with Chapter A-E 7 of the State of Wisconsin Administrative Code, Minimum Standards for Property Surveys and correctly represents said survey and its location.
Given under my hand and seal this 29th day of August, 2023 at Beloit, Wisconsin.
Last day of field work August 21, 2023

If the surveyor's signature is not red in color,
the plan is a copy that should be assumed to
contain unauthorized alterations.
The certification contained on this document
shall not apply to any copies.



Scale: 1" = 10'
DISTANCE UNITS BASED ON THE UNITED STATES SURVEY FOOT
BEARINGS BASED ON THE WISCONSIN COORDINATE REFERENCE SYSTEM,
WALWORTH ZONE.
THE NORTH LINE OF LOT 12 BEARING N 88°25'46"E
VERTICAL DATUM BASED ON NAVD-88 (2012)
GEOID 18 WISCONSIN
STARTING BENCHMARK: NGS MONUMENT
R1D: D19661
PUBLISHED ELEVATION: 965.36

FEB 18 2024

81K

PLAT OF SURVEY WITH TOPOGRAPHIC MAPPING

FOR

Tom & Loretta Dunaway

DELAVAN, WISCONSIN

FOR THE EXCLUSIVE USE OF:

Tom & Loretta Dunaway

826 Inlet Shore Drive

Delavan, WI 53115

ORDER NO: 34765

FIELD CREW: BMR

DRAWN BY: BMR

SHEET 1 OF 1



2827 Battelle Drive
Beloit, WI 53511
608.365.4464
1040 N Wisconsin Street
Elkhorn, Wisconsin 53121
www.batterman.com

Batterman
engineers surveyors planners