


PLAT OF SURVEY - AS BUILT  
LOT 163 AND 164 OF KRUMHAAR'S SECOND ADDITION TO RAVENSWOOD

LOCATED IN THE NW 1/4 OF THE SE 1/4 OF SECTION 31, TOWN 2 NORTH, RANGE 3 EAST  
TOWN OF DELAVAN, WALWORTH COUNTY, WISCONSIN

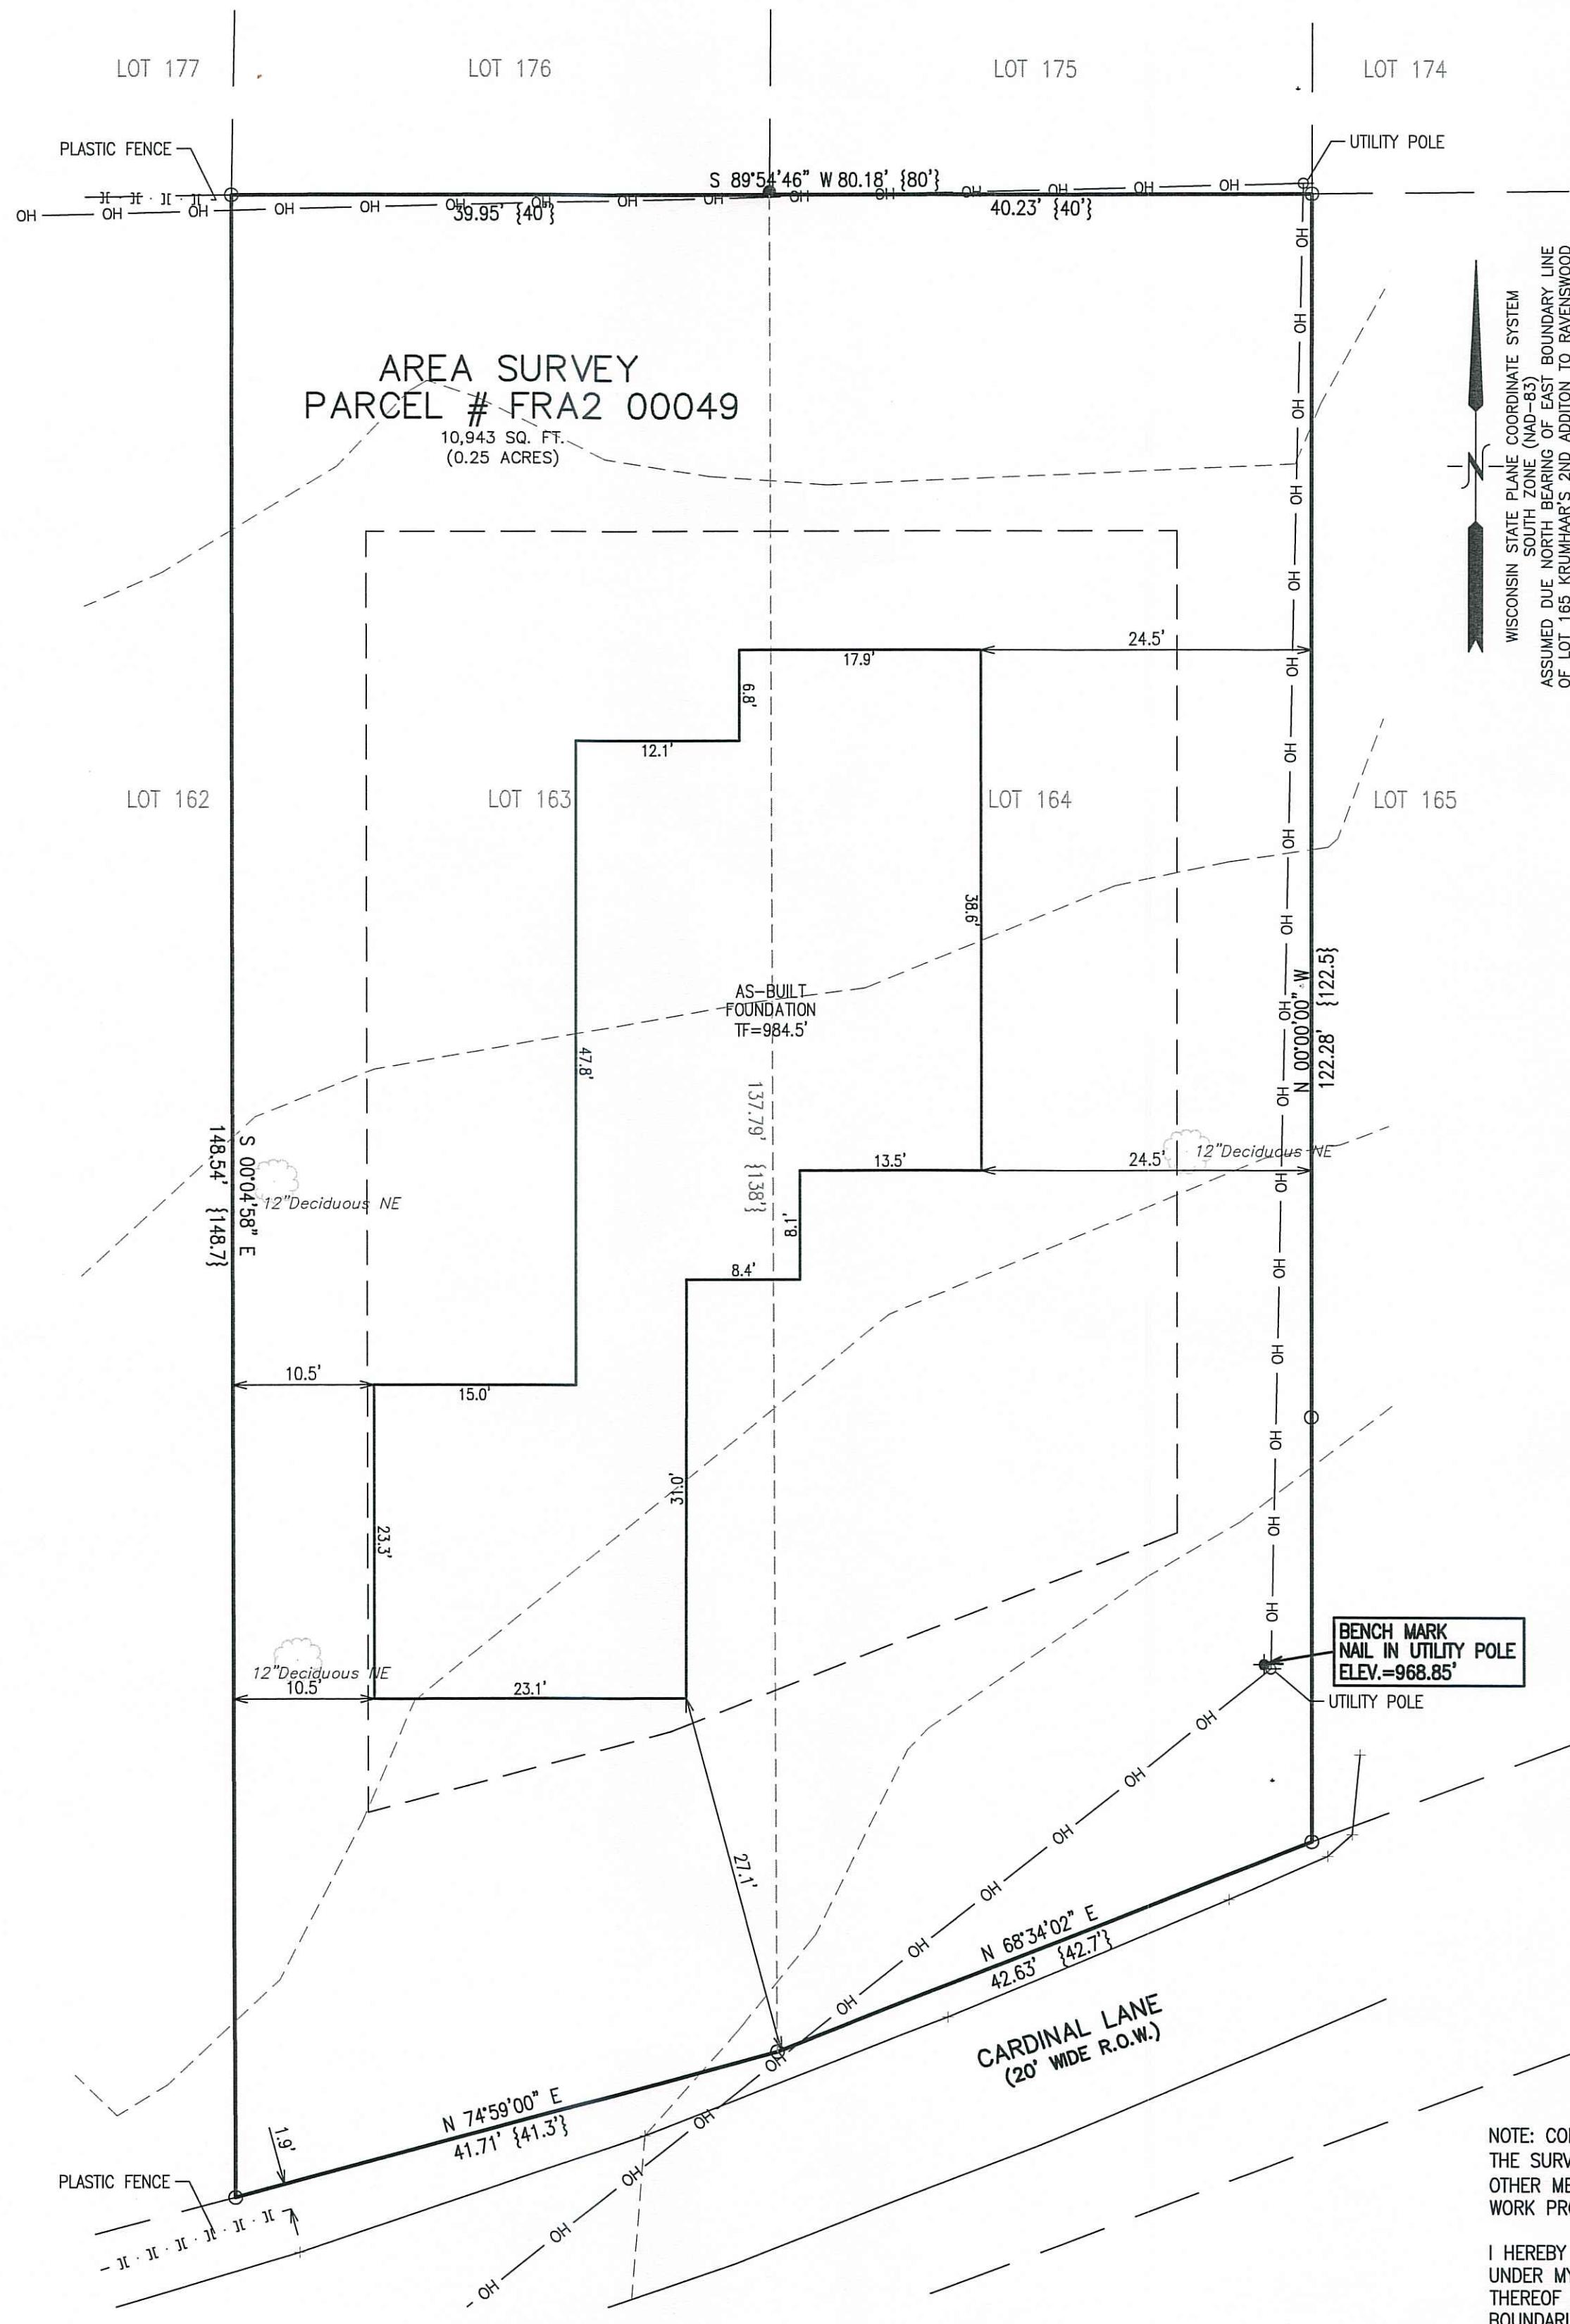

NOTE: FIELDWORK COMPLETED BY FARRIS HANSEN & ASSOCIATES, INC.  
ON 7/23/2024

**AS-BUILT PLAN**  
PARCEL# FRA2 00049

PARCEL# FRA2 00049  
OAK DRIVE / TOWN OF DELAVAN

**FARRIS, HANSEN & ASSOCIATES, INC.**  
ENGINEERING - ARCHITECTURE - SURVEYING  
7 RIDGWAY COURT P.O. BOX 437  
ELKHORN, WISCONSIN 53121  
PHONE: (262) 723-2098 e-mail: [office@farrishansen.com](mailto:office@farrishansen.com)

- WORK ORDERED BY -  
EILEEN NICOLL  
1419 LANCASTER LANE

CHRISTOPHER A. HODGES

7/24/2024

7/24/2024

DATED: 7/27/2024

## REVISIONS

PROJECT NO.

10970

DATE:

SHEET NO.

1 OF 1