


# Plat of Survey

of


## Lot 4 in Block 3 of Delmar,

a subdivision located in the Northeast 1/4 of the Southwest 1/4 of Section 27,  
Town 2 North, Range 16 East, Town of Delavan, Walworth County, Wisconsin.

Surveyed for: **Rich Boettcher**  
4308 North Lowell Avenue  
Chicago, Illinois. 60641

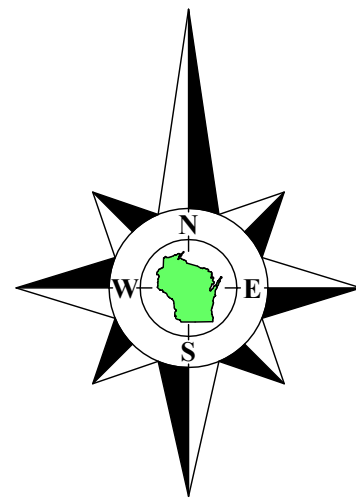

Bearings referenced to the Southeasterly line of Cameron Street, recorded as N32°23'E on the plat of Delmar.

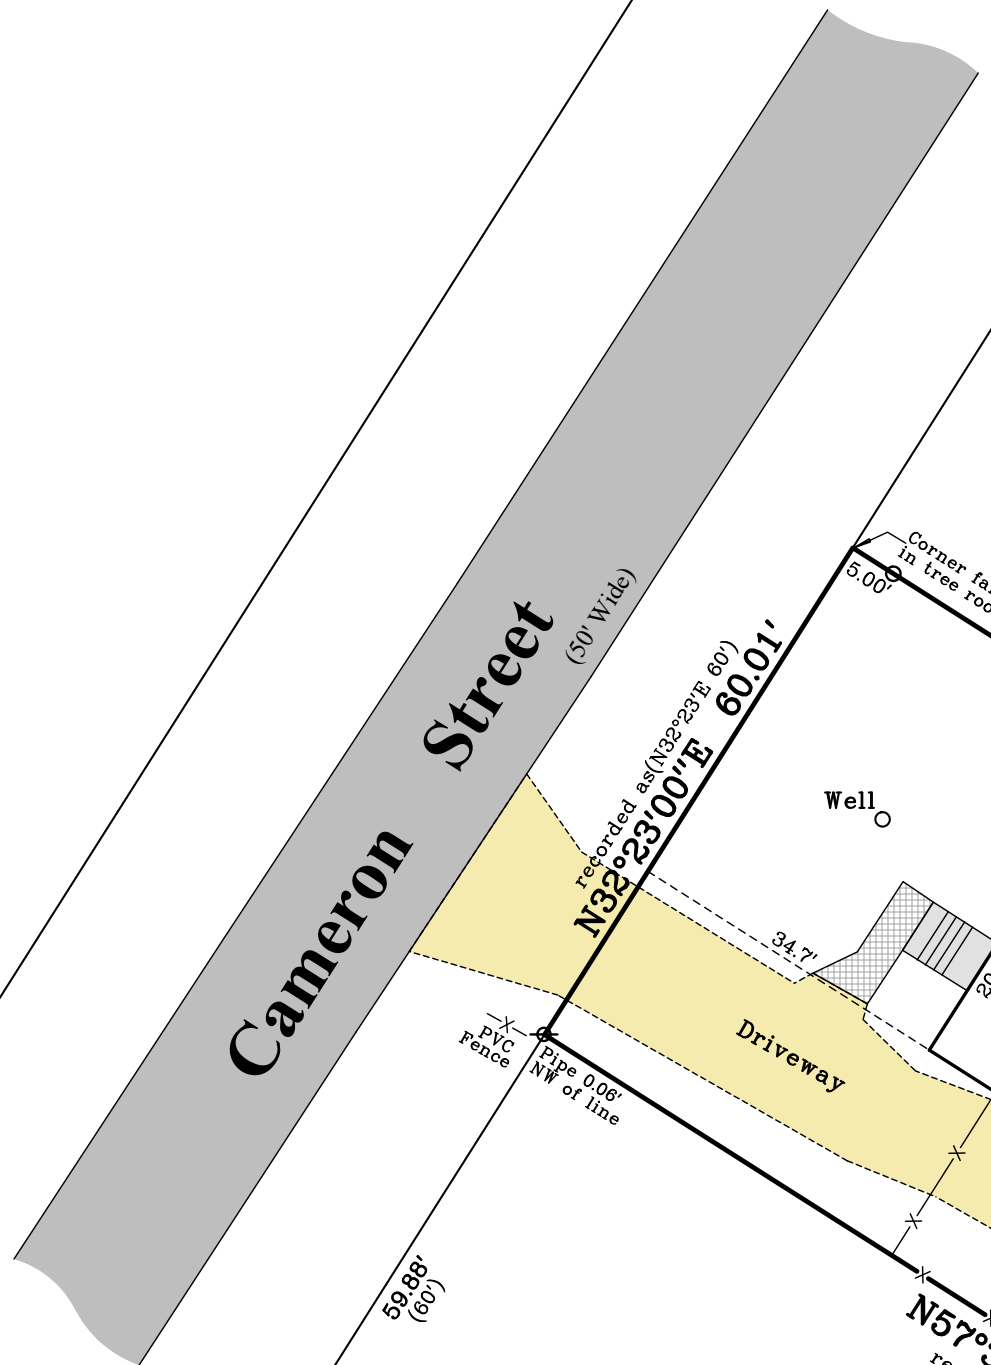


**Lot 4**  
Tax Parcel  
FDM 00016D  
0.186 Acre  
8,095 Sq.Ft.

**Poured Concrete Slab**

**House No. 2510**

**Driveway**

**Well**

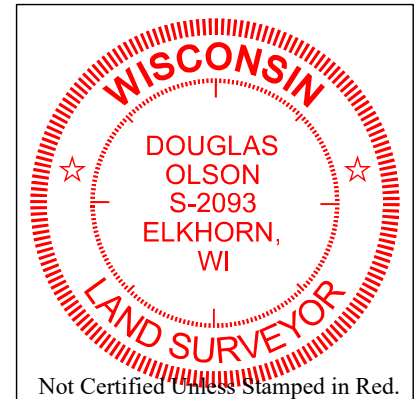

- Notes:**
- 1) This Plat of Survey is not certified unless signed and sealed in red ink.
  - 2) This survey is subject to Wisconsin lien laws. This Plat of Survey is the notice of intent to file lien. Lien waiver required.
  - 3) The Survey Date shown on this Plat of Survey is the completion date of the field work.


Copyright © 2023 by Olson Land Surveying, LLC.

All rights reserved. No part of this survey plat may be reproduced or transmitted in any form by any means - graphic, electronic, or mechanical, including photocopying, tracing, or information storage and retrieval systems - without permission in writing from Douglas G. Olson, Olson Land Surveying, LLC.

I hereby certify that I have surveyed the above described property in compliance with Chapter A-E 7 of the Wisconsin Administrative Code and that the map hereon is correct to the best of my professional knowledge and belief and shows the size and location of the property, its exterior boundaries, the location and dimensions of all visible structures thereon, boundary fences, apparent easements and roadways and visible encroachments, if any.  
This survey is made for the exclusive use of the present owners of the property, and also those who purchase, mortgage or guarantee title thereto, within one year from the date hereof.

Douglas G. Olson  
Wisconsin Professional Land Surveyor - 2093

Survey Date: June 12, 2023.  
Revisions: No. 1 - Proposed Garage Slab  
No. 2 - Proposed Concrete Slab

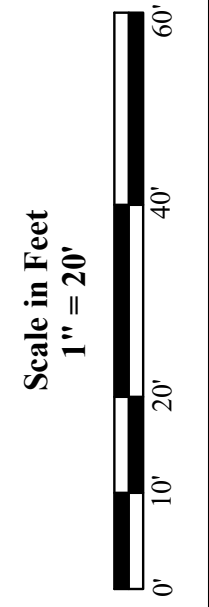

45 South Wisconsin Street | P.O. Box 322  
Elkhorn, Wisconsin. 53121  
Telephone: (262) 723-3434  
Facsimile: (262) 723-8044  
Email: doug@olsonsurveying.com  
Website: www.olsonsurveying.com



**Legend of Symbols & Abbreviations**

N	North
S	South
E	East
W	West
D	in Degrees
'	in Minutes
"	in Seconds
ft	in Feet
in	in Inches
Found Iron Pipe	Found Iron Pipe
Set Iron Pipe, 1" dia.	Set Iron Pipe, 1" dia.
Recorded Information	Recorded Information
Utility Pole	Utility Pole
Utility Pole - Metal	Utility Pole - Metal
Concrete Surface	Concrete Surface
Gravel Surface	Gravel Surface
Brick Pavers	Brick Pavers

Sheet 1 of 1 Sheets  
Drawing Name:  
Job Reference Number  
**2023.031**

**2023.031**