


North 1/4 Corner
Section 28-2-16
N. 225,921.05
E. 2,374,387.09

Plat of Survey

of

Lots 1-5 and the North 1/2 of a Vacated Portion of Lake View Avenue Adjacent to said Lots in Makovsky's Subdivision,

located in Government Lot 1 in the Northeast 1/4 of Section 28, Town 2 North, Range 16 East, Town of Delavan, Walworth County, Wisconsin.

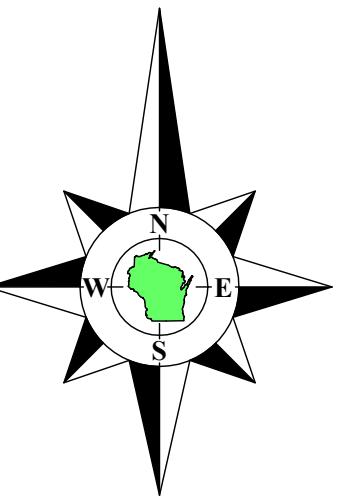

Surveyed for: **Brian Kelly**
35 East Woodworth Place
Roselle, Illinois. 60172



Survey Date: July 12, 2022.
Revisions: No. 1 - Misc. Info. & Note A
No. 2 - Poured Concrete
No. 3 - Tax Parcel FMAS 00001
No. 4 - Proposed House, Pool, Porch & Patios
No. 5 - Proposed Pool, Patios & Misc.
No. 6 - Proposed Driveway

No. 7 - Recorded Doc. 1086315
No. 8 - Staking
No. 9 - Poured Concrete
No. 10 - Foundations

Bearings referenced to the East line of the Southwest 1/4 of Section 9-3-17, recorded as N1°50'18"W in the Wisconsin State Plane Coordinate System, South Zone, (NAD-27).

Coordinates are referenced to the Wisconsin State Plane Coordinate System, South Zone, (NAD-27).

Scale in Feet
1" = 20'
0' 10' 20' 40' 60'

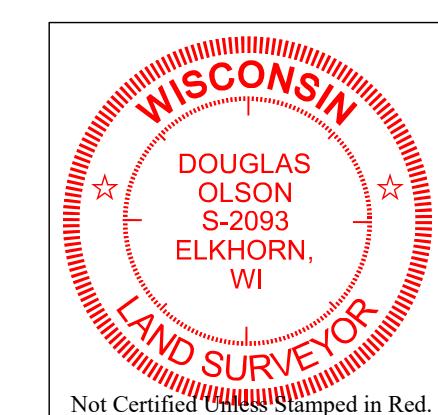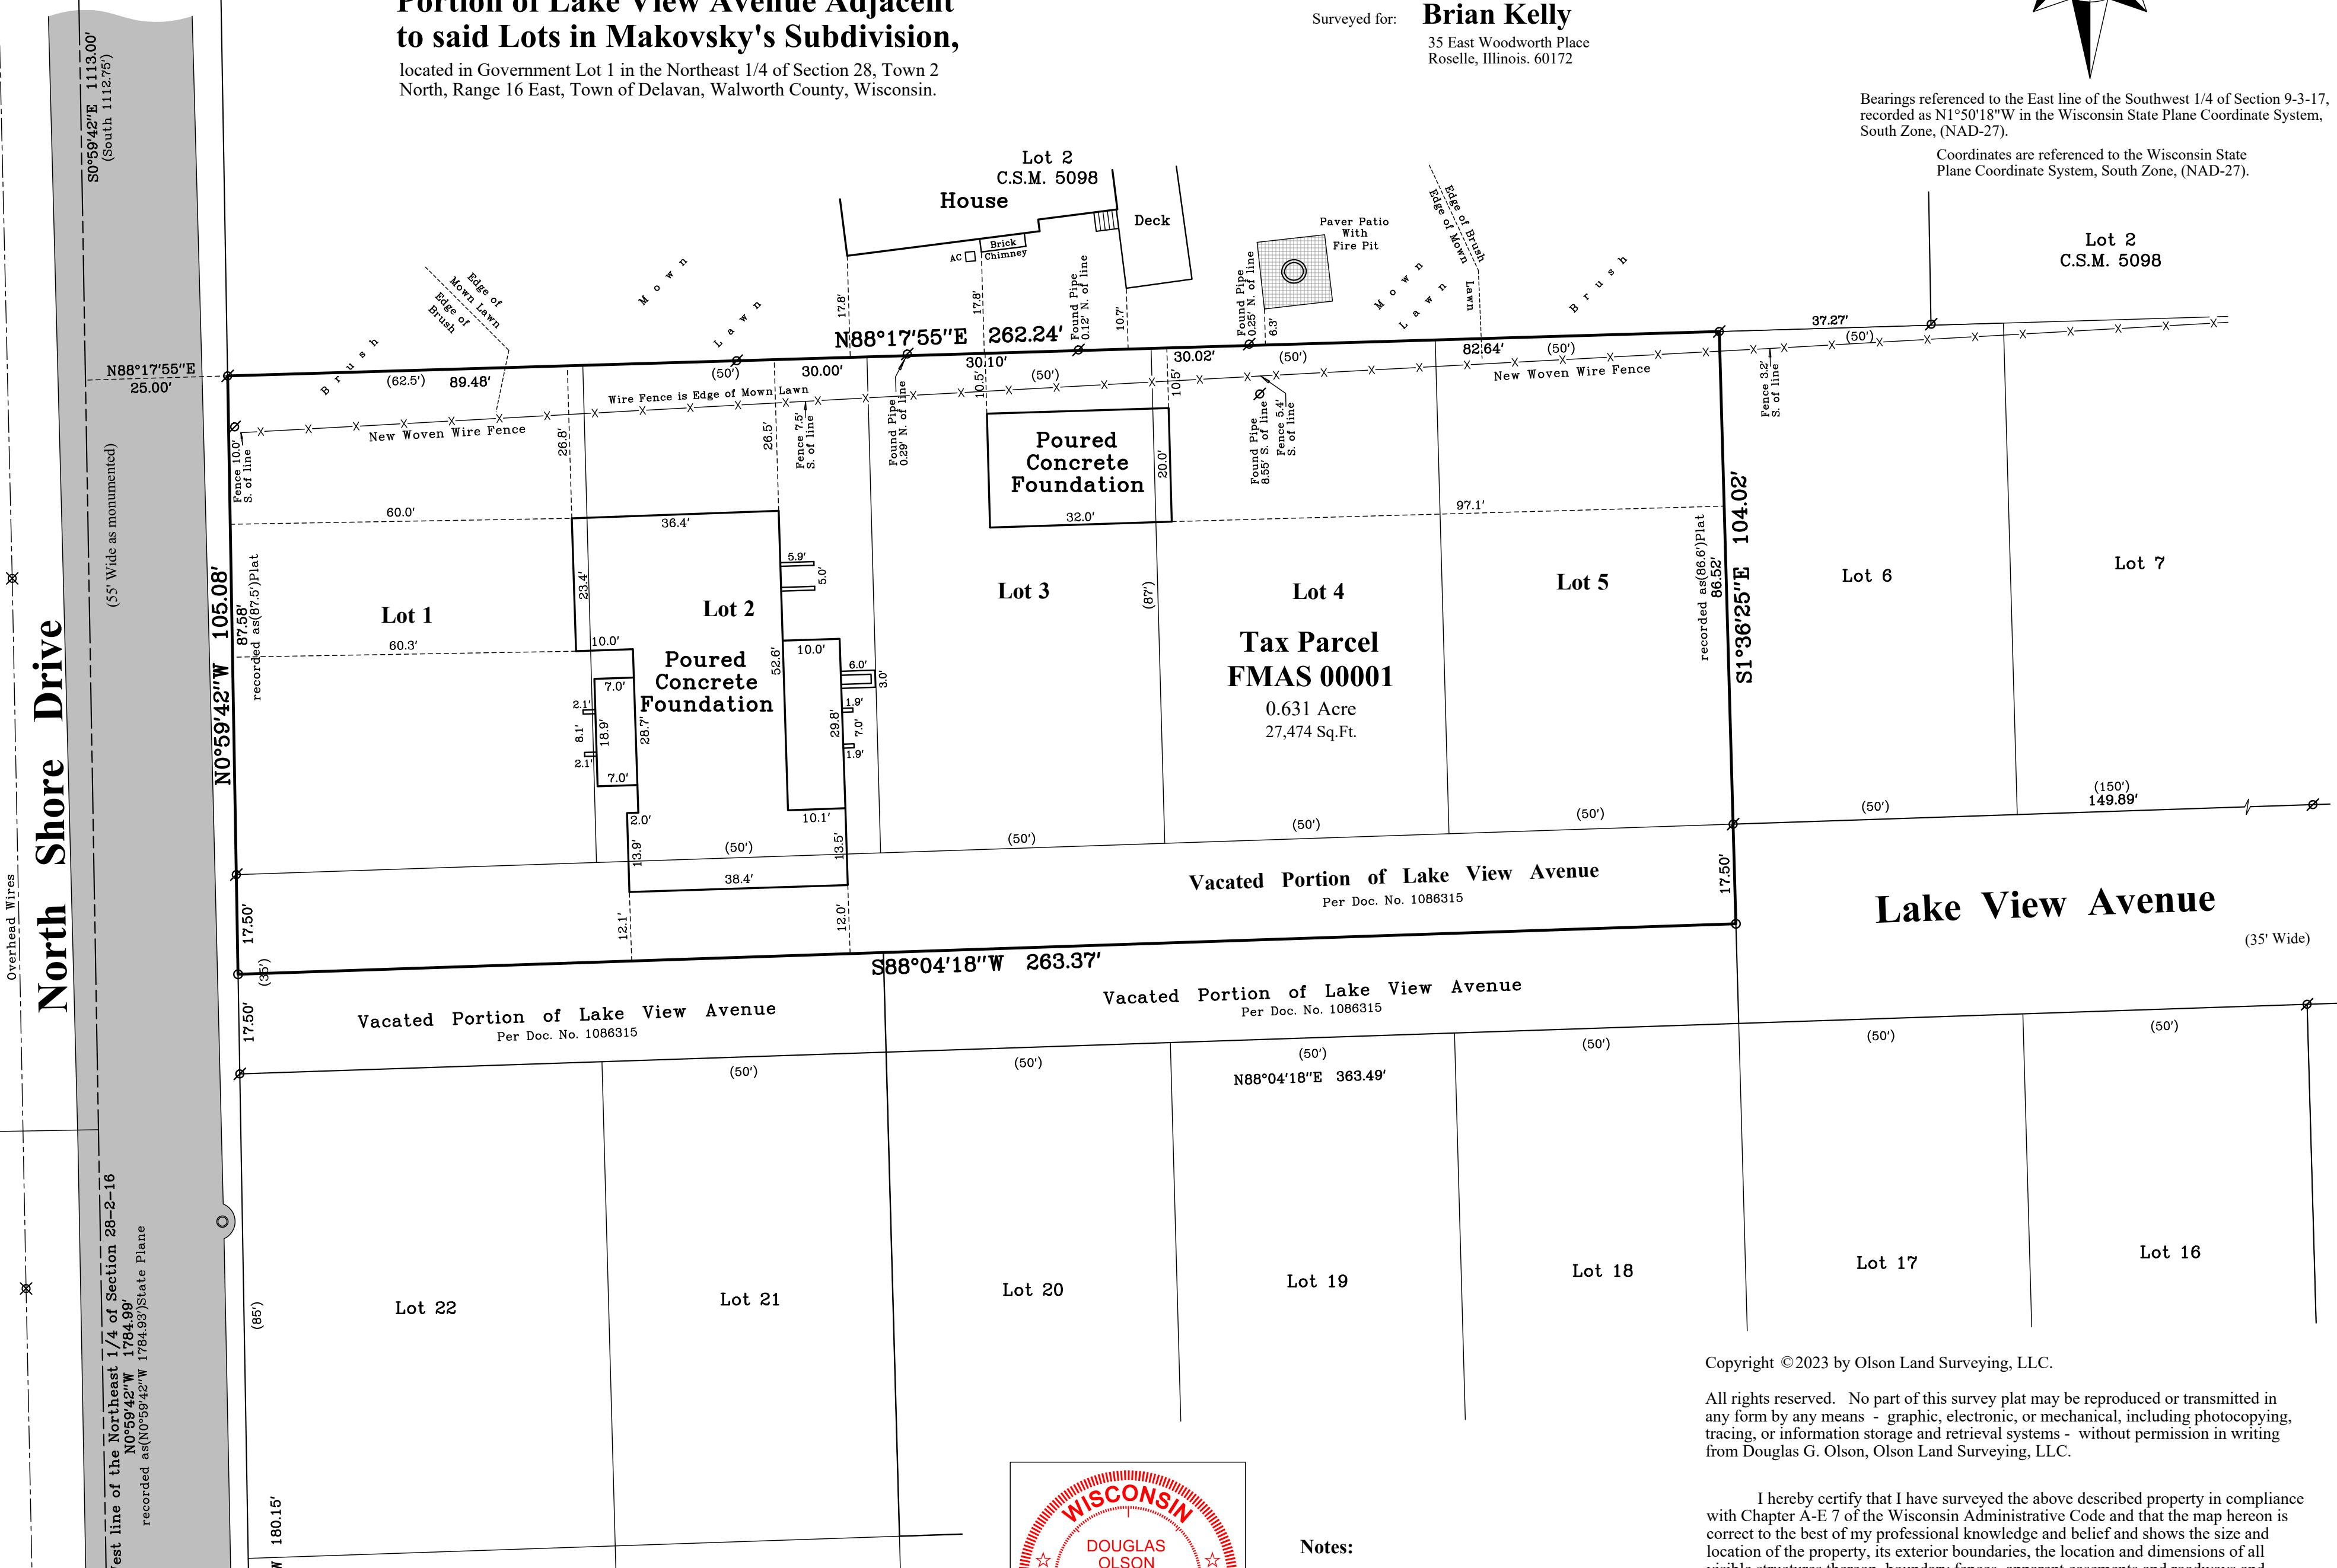

Notes:

- 1) This Plat of Survey is not certified unless signed and sealed in red ink.
- 2) This survey is subject to Wisconsin lien laws. This Plat of Survey is the notice of intent to file lien. Lien waiver required.
- 3) The Survey Date shown on this Plat of Survey is the completion date of the field work.

Copyright ©2023 by Olson Land Surveying, LLC.

All rights reserved. No part of this survey plat may be reproduced or transmitted in any form by any means - graphic, electronic, or mechanical, including photocopying, tracing, or information storage and retrieval systems - without permission in writing from Douglas G. Olson, Olson Land Surveying, LLC.

I hereby certify that I have surveyed the above described property in compliance with Chapter A-E 7 of the Wisconsin Administrative Code and that the map hereon is correct to the best of my professional knowledge and belief and shows the size and location of the property, its exterior boundaries, the location and dimensions of all visible structures thereon, boundary fences, apparent easements and roadways and visible encroachments, if any.

This survey is made for the exclusive use of the present owners of the property, and also those who purchase, mortgage or guarantee title thereto, within one year from the date hereof.

Douglas G. Olson
Wisconsin Professional Land Surveyor - 2093

Sheet 1 of 1 Sheets	
Found County Section Corner	North
Found Iron Pipe	South
Found Mag. Nail	East
Found Pipe	West
Set Iron Pipe	W 1/2 dia.
Recorded Information	Set Wood Stake
Utility Pole	Minutes
Utility Pedestal	Seconds
Manhole	Inches
Asphalt Surface	Brick Pavers

OLSON
LAND SURVEYING, LLC
45 South Wisconsin Street | P.O. Box 322
Elkhorn, Wisconsin. 53121
Telephone: (262) 723-3434
Facsimile: (262) 723-8044
Email: doug@olsonsurveying.com
Website: www.olsonsurveying.com

2023.053