

DUNHAM SURVEYING, S.C.
SURVEYING & SUBDIVIDING
DELAVER, WISCONSIN 53115

N

Scale - 1" = 20'
/ = Iron Pipe Found
o = Iron Pipe Set


Most Northwestern line
of Certified Survey
No. 453

Most Northwestern line of
Certified Survey No. 453

Most Northerly corner of Certified
Survey No. 453.

Plat of survey of a parcel of land located in the West 1/4 of Section 25, T2N, R16E, Walworth County, Wisconsin, showing the change in location of the most northwesterly line of Certified Survey No. 453, recorded in Vol. 2 of Certified Surveys on page 258, Walworth County Records. Said line being changed is presently described as beginning in the center line of State Trunk Highway No. 50 at the most northerly corner of said certified survey No. 453; thence S32°51'W 266.57 feet; the new location of said line will be relocated by beginning in the centerline of State Trunk Highway No. 50 at the most northerly corner of the aforementioned Certified Survey No. 453; thence N58°45'W along the centerline of said highway 14.70 feet to the place of beginning of said new line; thence S28°25'00"W 265.79 feet to a point located S67°47'E 6.00 feet from the southerly end of said northwesterly line. October 14, 1977

George T. Dunham
George T. Dunham, Surveyor

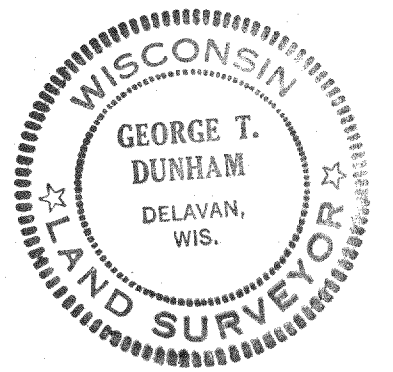

C.S. 453
4FD-25-15
line adjustment